IREDELL COUNTY HEALTH DEPARTMENT

STATESVILLE 704-878-5305 MOORESVILLE 704-664-5281

IMPROVEMENT PERMIT / CERTIFICATE OF COMPLETION / OPERATION PERMIT / EXISTING SYSTEM INSPECTION

PROPERTY DESCRIPTION NO. 19779 DATE Dec 9, '94 TAX MAP NO. 2623B28 Watershed: ☑ Yes ☐ No WS IV

OWNER OR CONTRACTOR Robert Clingenbum Homes PHONE: Business 391-3715 Home

ADDRESS 2900 B-185 S. Service Rd, Charlotte

LOCATION 1100 Tr 1113 TR Cove Creek Rd. TL Wynswept TR Wynwood TL North Shore Dr. on left near end

SUBDIVISION North Shore BLOCK / SECTION II LOT 28 LOT AREA 22,000 ft²+ SITE CLASS PS per 1956 DESIGN FLOW 450 gpd L.T.A.R. .3

Septic Tank: 1000 Gallons; STB Date 1/13/95 ☑ New System ☐ Repair System Type: I, II, III, (IV) V, VI ☑ House/Mod. Home No. Bedrooms 4 Water Supply:

Pump Tank: 1000 Gallons; PT PT27-1000 Date 3/2/95 System Description: LP PPBS ☐ Mobile Home No. Bathrooms 2½ ☐ Individual

Pump Make: Gould Model Serial No. Repair System Description: SAME ☐ Business No. Employees ☑ Community

Nitrification Field: No Fields 1 Square Feet Linear Feet 270 Maintenance Agreement Required: ☑ Yes ☐ No ☐ Other ☐ Public


No Lines 4 Trench Width 24" Max Trench Bottom Depth 30" Gravel Depth NA ☐ Slab ☑ Crawl Space ☐ Basement w/plumbing ☐ Basement wo/plumbing

Comments: Follow contour of laterals - one 3/16" hole per panel, 62 panels total


House site graded upon arrival for IP issuance

Comments:

INITIAL SITE SKETCH

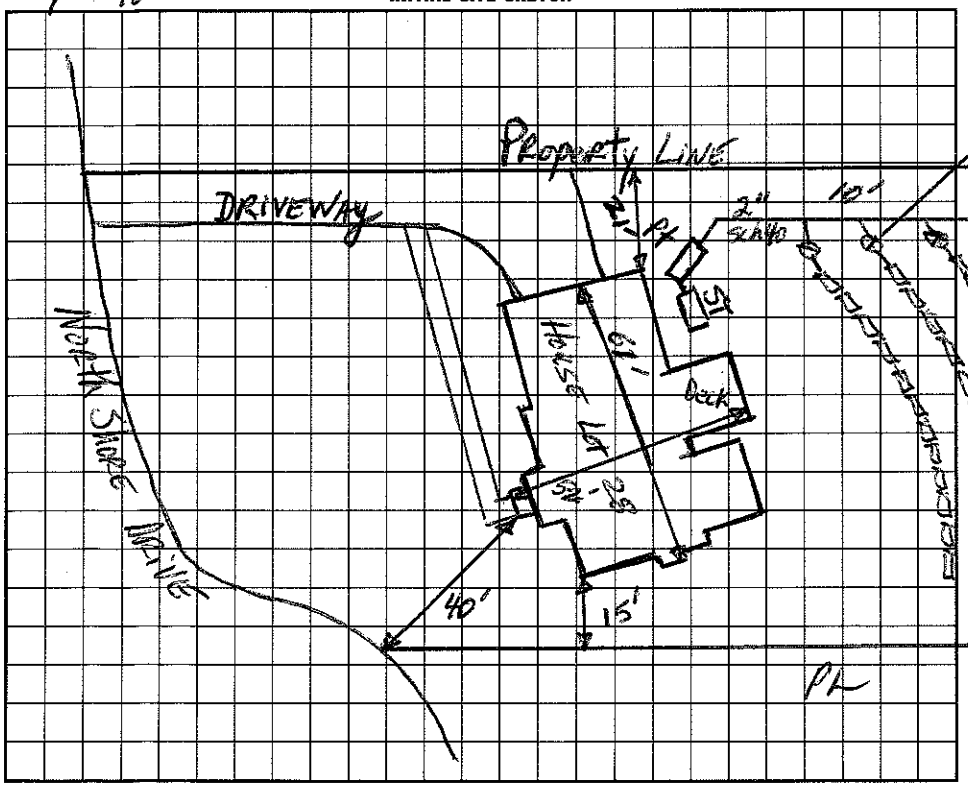

AS BUILT SKETCH

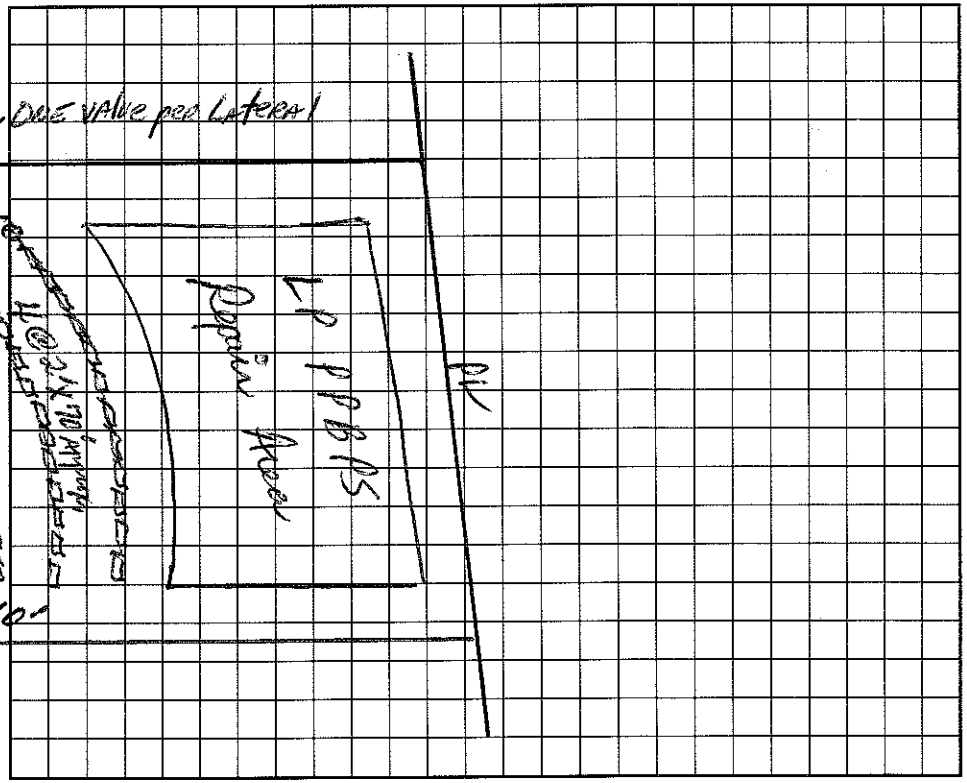

I understand that this permit can be suspended or revoked if any false information is supplied toward securing the permit/any unauthorized changes are made to the site/any unauthorized changes are made in the installation of the system. Improvement Permit is valid for 60 months from date of issuance.

Signed:

Improvement Permit by: date 12/9/94

Existing System Inspection by: date

Installed by:

Certificate of Completion by: date

Operation Permit by: date

HEALTH DEPT. COPY: WHITE INSPECTION COPY (FINAL): GREEN OWNER COPY (FINAL): YELLOW INSPECTION COPY (INITIAL): PINK OWNER COPY (INITIAL): GOLD