IREDELL COUNTY HEALTH DEPARTMENT

STATESVILLE 704-878-5305 MOORESVILLE 704-664-5281

IMPROVEMENT PERMIT / CERTIFICATE OF COMPLETION / OPERATION PERMIT / EXISTING SYSTEM INSPECTION

PROPERTY DESCRIPTION NO. 21644 DATE 7/23/95 TAX MAP NO. 2G 23 B 25 Watershed: X Yes ☐ No

OWNER OR CONTRACTOR Robert Ingram Homes PHONE: Business 391-3715 ~~Home~~ 463600-7878

ADDRESS I 85 Service Rd. Charlotte, NC. 28208

LOCATION Brawley Creek Pines, TR Cove Creek (L) Wynwood (R) Wynwood Ln. TL North Shore to 3rd Lot on (L)

SUBDIVISION North Shore BLOCK / SECTION II LOT 25 LOT AREA ~.6 SITE CLASS. PS DESIGN FLOW 480 L.T.A.R. .3

Septic Tank: 1000 Gallons; STB 794 Date 9/6/95

Pump Tank: _____ Gallons; PT _____ Date _____

Pump Make: _____ Model _____ Serial No. _____

Nitrification Field: No Fields 4 Square Feet 1600 Linear Feet ~~440~~ (533)

No Lines ~~4~~ Trench Width 36" Max Trench Bottom Depth 36" Gravel Depth N/A

X New System ☐ Repair System Type: I, II, III, IV, V, VI

System Description: GRAV IN FILTRATOR

Repair System Description: PANEL

Maintenance Agreement Required: ☐ Yes X No

X House/Mod. Home ☐ Mobile Home ☐ Business ☐ Other

No. Bedrooms 4 No. Bathrooms 2.5 No. Employees _____

☐ Slab X Crawl Space ☐ Basement w/plumbing ☐ Basement wo/plumbing


Water Supply: ☐ Individual X Community ☐ Public

Comments:


~~440~~ 533 * 25% reduction for infiltrator

Comments:

INITIAL SITE SKETCH

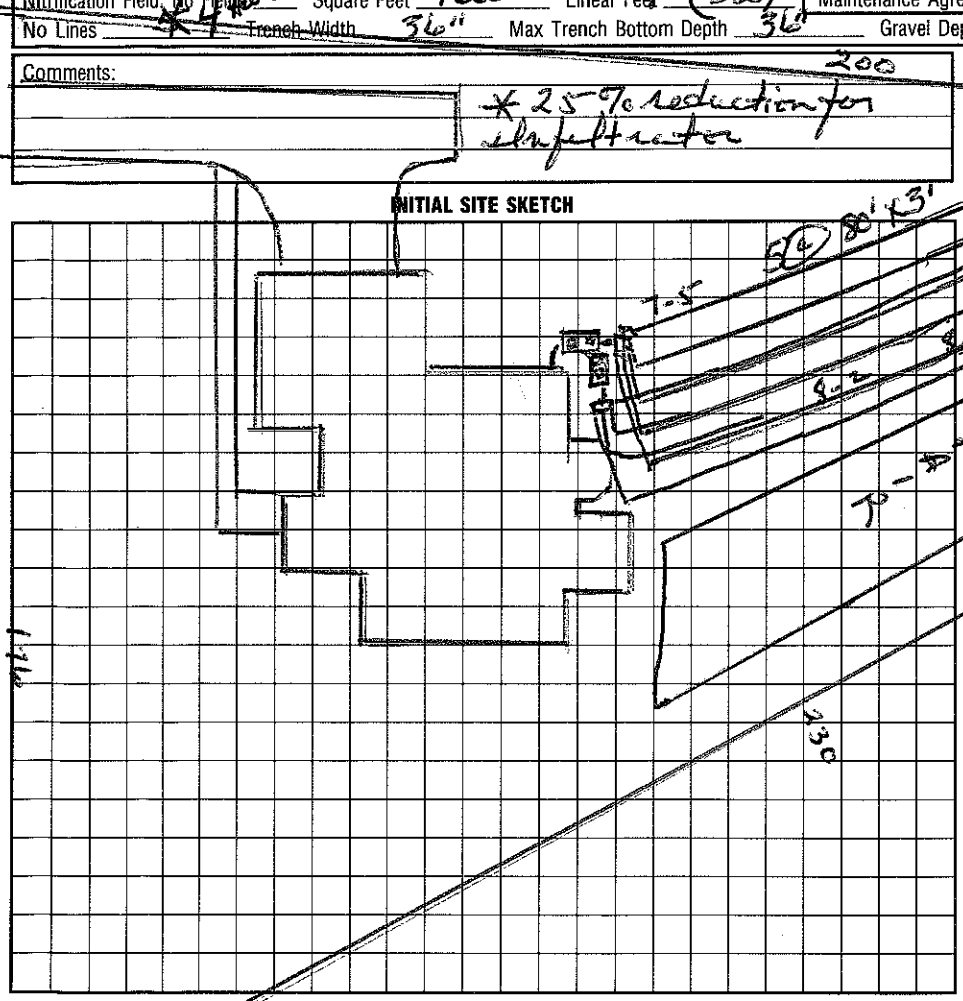

AS BUILT SKETCH

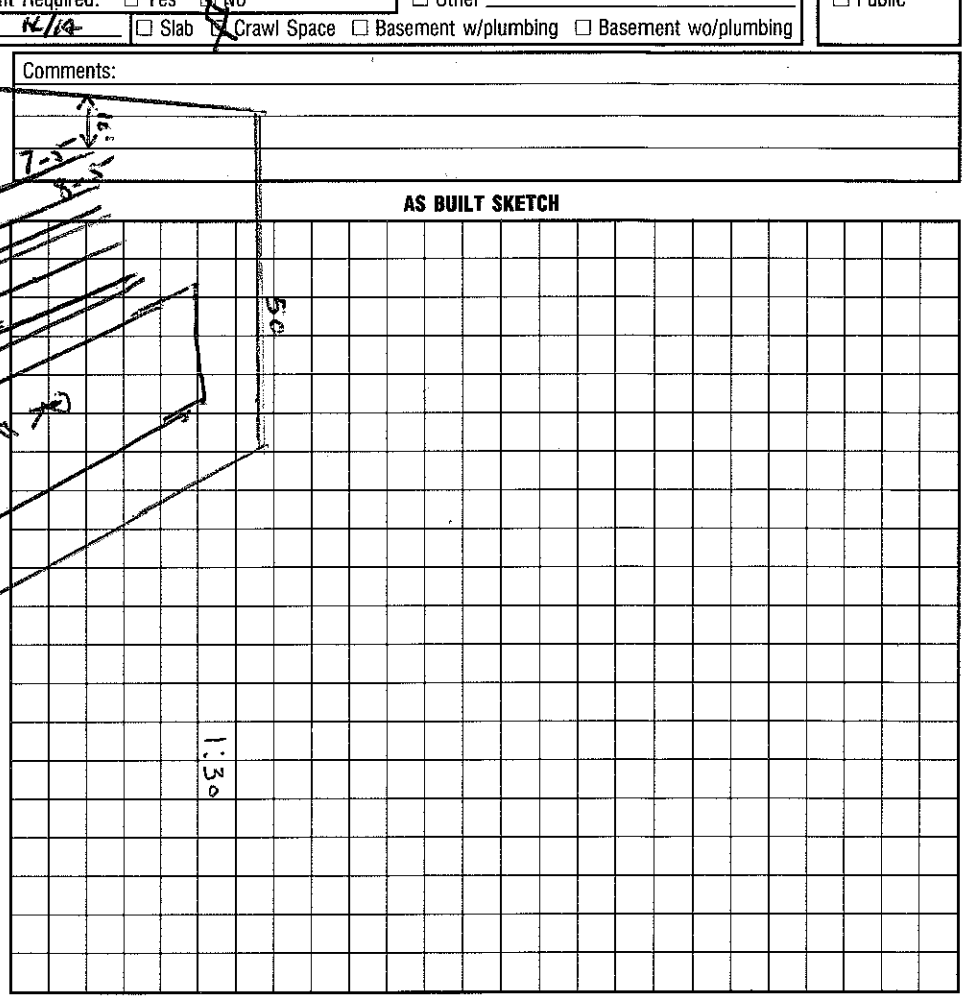

I understand that this permit can be suspended or revoked if any false information is supplied toward securing the permit/any unauthorized changes are made to the site/any unauthorized changes are made in the installation of the system. Improvement Permit is valid for 60 months from date of issuance.

Signed: _____ 7-26-95

Improvement Permit by: Wesley Sparks R.S. date 7/23/95

Existing System Inspection by: _____ date _____

Installed by: Iron Horse Grading

Certificate of Completion by: Wesley Sparks R.S. date 11/8/95

Operation Permit by: Wesley Sparks R.S. date 11/8/95

HEALTH DEPT. COPY: WHITE INSPECTION COPY (FINAL): GREEN OWNER COPY (FINAL): YELLOW INSPECTION COPY (INITIAL): PINK OWNER COPY (INITIAL): GOLD