IREDELL COUNTY HEALTH DEPARTMENT - *ENVIRONMENTAL HEALTH* ☐ STATESVILLE OFFICE 704-878-5305 ☒ MOORESVILLE OFFICE 704-664-5281

IMPROVEMENT PERMIT / AUTHORIZATION TO CONSTRUCT / OPERATION PERMIT / EXISTING SYSTEM INSPECTION

PERMIT # REPAIR PIN # 4636-00-8095 DATE 11-7-11

OWNER DAVID JONES APPLICANT: JASPER BUILDERS PHONE: Home/Cell # 704-799-9982 Business #

SITE ADDRESS 105 WYNWARD LN OWNER / APPLICANT ADDRESS SAME

SITE DIRECTIONS ISLE OF PINES, COVE CREEK, WYNSWEPT, WYNWARD

SUBDIVISION NORTH SHORE II BLOCK / SECTION II LOT # 17 LOT AREA .7 AC DESIGN FLOW 480 L.T.A.R. .3

Septic Tank 1000 Gallons: STB 794 Date 9-18-11

Pump Tank Gallons: P T Date

Pump Make Model Serial #

No. Nitrification Fields: No. Lines Linear Feet

Trench Width Max Trench Bottom Depth Gravel Depth

☐ New System ☒ Repair ☐ Expansion System Type I II (III) IV V VI

System Description: REPLACE TANK

Repair System Description:

Maintenance Agreement Required ☐ YES ☒ NO

☒ GRAVITY ☐ PRESSURE

☒ Residence No. Bedrooms 4

☐ Business No. Persons

☐ Other No. Employees

☐ Slab ☒ Crawl Space

☐ Basement w/plumbing ☐ Basement w/o plumbing


Water Supply: ☐ Private ☐ Public ☒ Community

Comments / Conditions ① INSTALL NEW TANK AS SHOWN


TANK & D-BOX REPLACED

INITIAL SITE SKETCH

SEND COPY TO RICHARD 704-664-6509 (FAX)

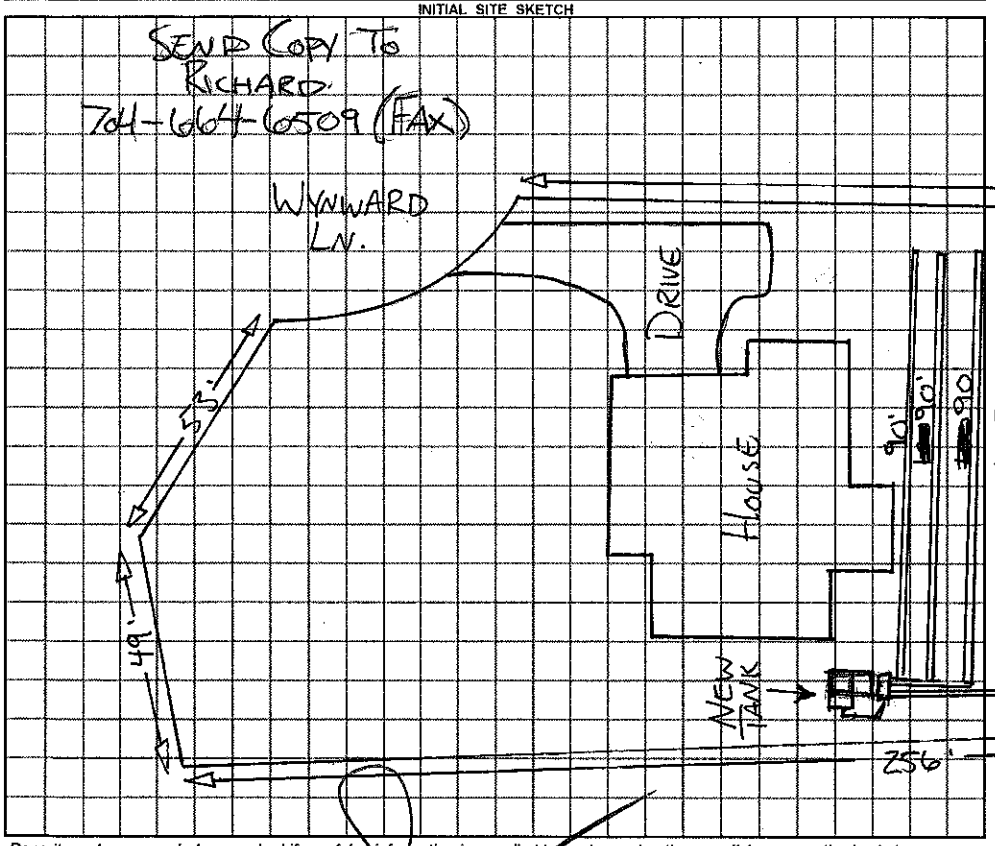

AS BUILT SKETCH

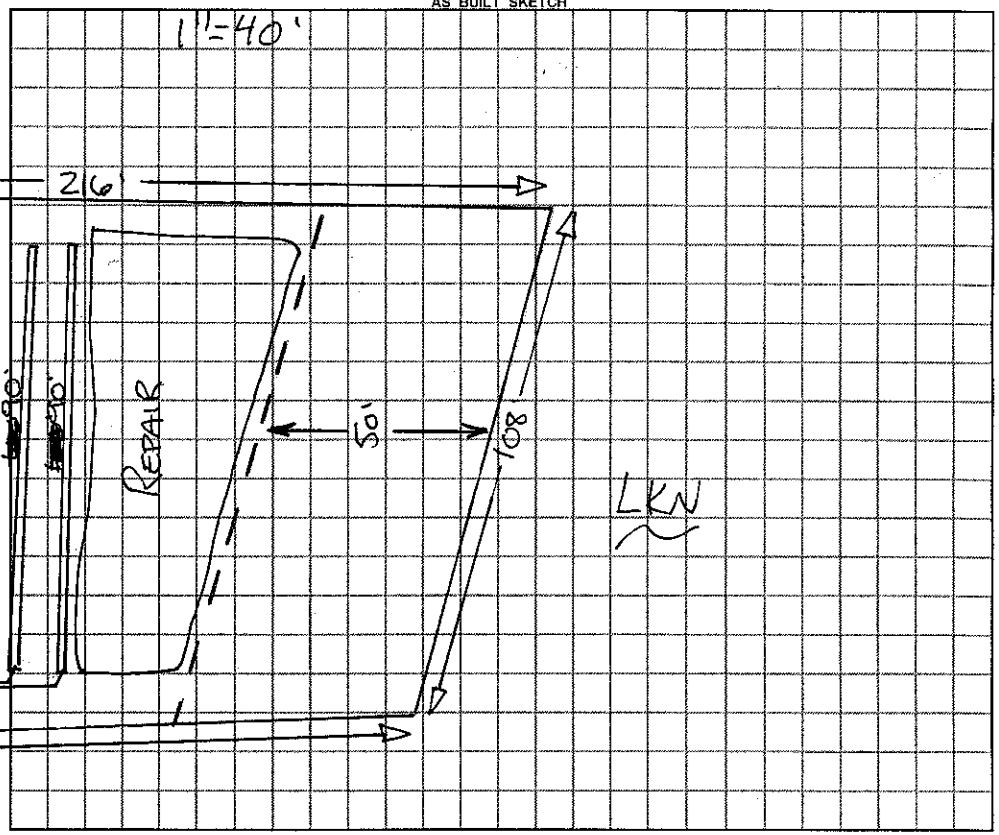

Permit can be suspended or revoked if any false information is supplied toward securing the permit / any unauthorized changes are made to the site / any unauthorized changes are made in the installation of the system.

☐ ***IMPROVEMENT PERMIT*** *with plat valid without expiration* ☐ ***IMPROVEMENT PERMIT*** *with ~~plat valid without expiration.~~ site plan valid 60 mo.* ☒ ***AUTHORIZATION TO CONSTRUCT*** valid for period equal to IMPROVEMENT PERMIT--not to exceed 60 mo.

Owner / Applicant Signature: Date

IMPROVEMENT PERMIT by: REHS Date 11-7-11

AUTHORIZATION TO CONSTRUCT by: REHS Date 11-7-11

Installed by: RICHARD ARBOGNATHY

OPERATION PERMIT by: REHS Date 11-14-11

Existing System Inspected by: REHS Date

YOU SHOULD CONTACT A LOCATOR SERVICE PRIOR TO ANY EXCAVATION

White Copy – Environmental Health YELLOW COPY (Final) Owner / Applicant PINK COPY (Initial) Owner / Applicant