IREDELL COUNTY HEALTH DEPARTMENT

STATESVILLE 704-878-5305 MOORESVILLE 704-664-5281

IMPROVEMENT PERMIT / CERTIFICATE OF COMPLETION / OPERATION PERMIT / EXISTING SYSTEM INSPECTION

PROPERTY DESCRIPTION NO. 1935 DATE March 11, '94 TAX MAP NO. 2623A B 22 Watershed: ☑ Yes ☐ No

OWNER OR CONTRACTOR Robert Hagnahem Homes PHONE: Business 391-3765 ~~Home~~ 4636-00-9775 C.V.

ADDRESS 2900 B I-85 Service Rd. Charlotte NC

LOCATION 1100 TL1113 TR Cove Creek Rd. TL Wynswept TR Wynward ~100' on left

SUBDIVISION North Shore BLOCK / SECTION Phase 2 LOT 22 LOT AREA 20,000ft² + SITE CLASS. PS DESIGN FLOW 480gpd L.T.A.R. .03

Septic Tank: 1000 Gallons; STB 744 Buellingo Date 5/4/94
Pump Tank: _____ Gallons; PT _____ Date _____
Pump Make: _____ Model _____ Serial No. _____
Nitrification Field: No Fields 2 Square Feet 1620 Linear Feet 540
No Lines 6 Trench Width 36" Max Trench Bottom Depth 36" Gravel Depth 12"

☑ New System ☐ Repair System Type: I, II, III, IV, V, VI
System Description: gravity conventional
Repair System Description: Same or new PPBPS
Maintenance Agreement Required: ☐ Yes ☑ No


☑ House/Mod. Home No. Bedrooms 4
☐ Mobile Home No. Bathrooms 2.5
☐ Business No. Employees _____
☐ Other _____
☐ Slab ☑ Crawl Space ☐ Basement w/plumbing ☐ Basement wo/plumbing

Water Supply:
☐ Individual
☑ Community
☐ Public

Comments:

Comments: Upper Laterals checked by Wesley Sparks

INITIAL SITE SKETCH

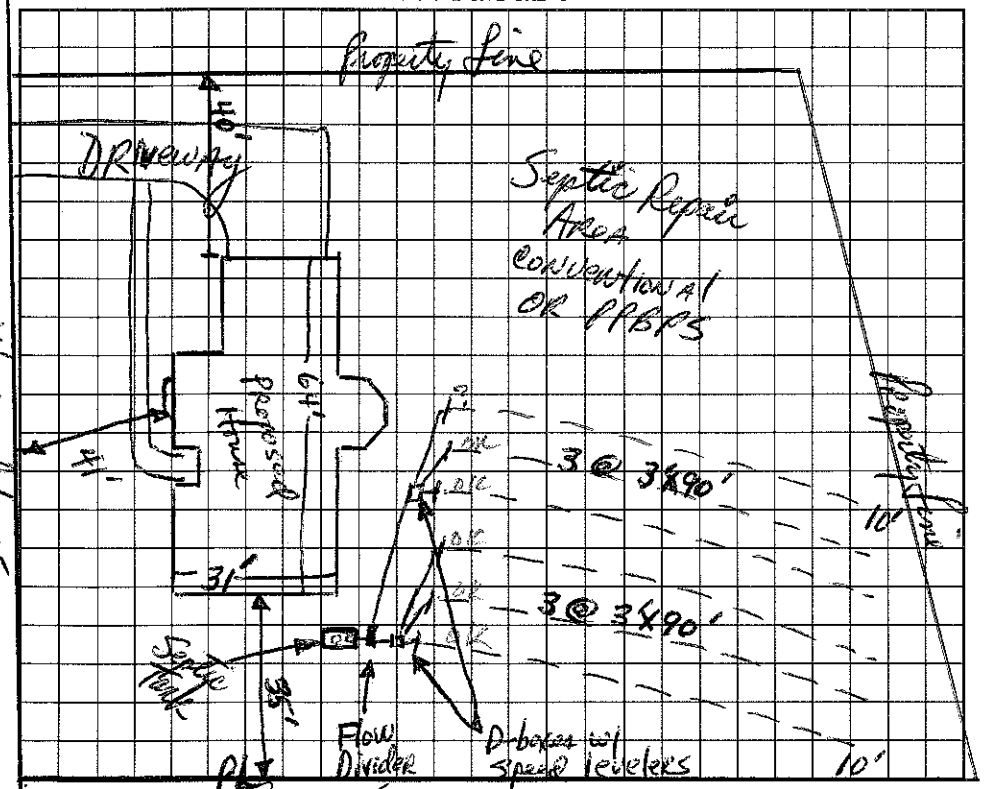

AS BUILT SKETCH

Laterals as installed on shown on sketch

I understand that this permit can be suspended or revoked if any false information is supplied toward securing the permit/any unauthorized changes are made to the site/any unauthorized changes are made in the installation of the system. Improvement Permit is valid for 60 months from date of issuance.

Signed: _____

Improvement Permit by: David R Hamm IRS date 3/11/94

Existing System Inspection by: _____ date _____

Installed by: Ken Painter / Cornhouse Grading

Certificate of Completion by: David R Hamm, RS date 6/6/94

Operation Permit by: _____ date _____

HEALTH DEPT. COPY: WHITE INSPECTION COPY (FINAL): GREEN OWNER COPY (FINAL): YELLOW INSPECTION COPY (INITIAL): PINK OWNER COPY (INITIAL): GOLD