IREDELL COUNTY HEALTH DEPARTMENT

Statesville Office (704) 878-5305 Mooresville Office (704) 660-3625 PERMIT # 212888

IMPROVEMENT PERMIT / AUTHORIZATION TO CONSTRUCT / OPERATION PERMIT / EXISTING SYSTEM

PIN # 4636-00-9775

APPLICANT: NICK SPEED APPLICANT ADDRESS: 7181 CALEY ST. DENVER

SITE ADDRESS: 145 WYNWARD LN. PHONE: 704-775-0857 ALT. PHONE:

SITE DIRECTIONS: ISLE OF PINES, TR COVE CREEK, TL WYNSWEPT, TR WYNWARD, ON L

SUBDIVISION: NORTH SHORE SECTION: 1 LOT # 22 LOT AREA: .6 AC DESIGN FLOW: 480 L.T.A.R.: .3

Septic Tank Ex. 1000 (gal) STB Date

Pump Tank (gal) PT Date

Pump Make Model Serial #

Nitrification Fields EXISTING # Lines Linear Ft:

Trench Width Max. Trench Bottom Depth Gravel Depth 12"

☐ New System ☐ Repair ☐ Expansion System Type: I II III IV V VI

System Description: GRAVEL

Repair System Description: PANEL BLOCK

Maintenance Agreement Required: ☐ YES ☒ NO

☒ GRAVITY ☐ PRESSURE

☐ Residence ☐ Business ☒ Other ☐ Slab ☐ Basement w/plumbing

No. Bedrooms 4 No. Persons No. Employees

☐ Crawl Space

Water Supply: ☐ Private ☐ Public ☒ Community


☐ Basement w/o plumbing

Comments / Conditions:

GARAGE

INITIAL SITE SKETCH

AS BUILT SKETCH

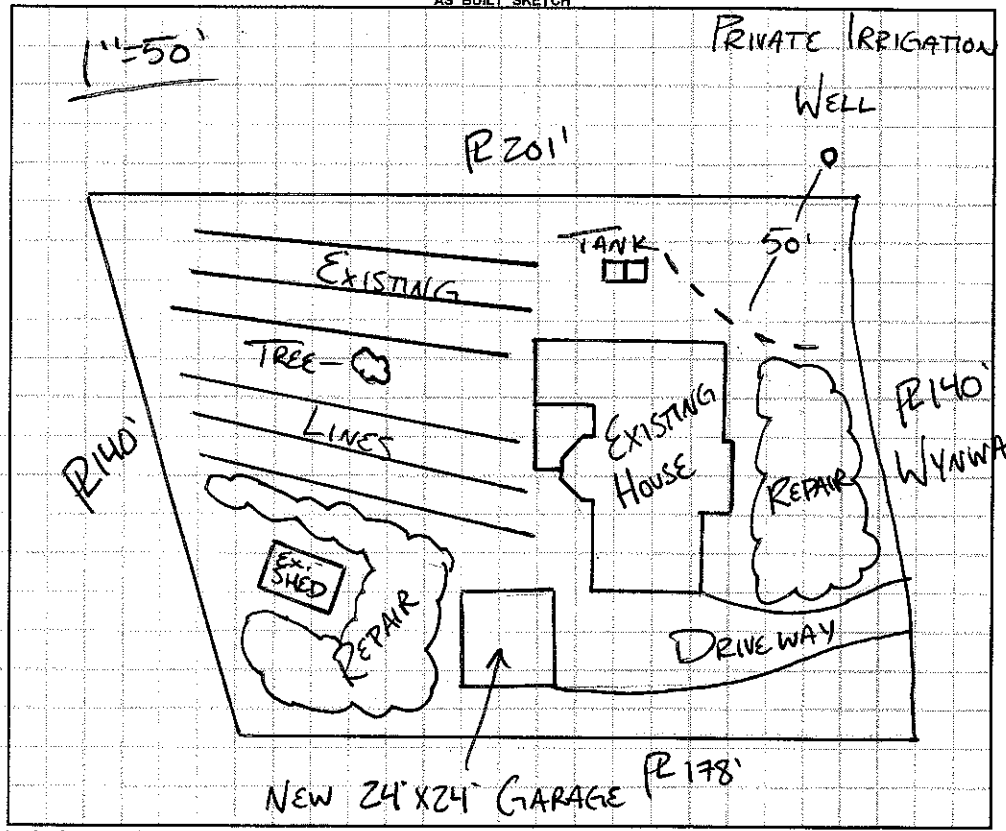

Permit can be suspended or revoked if any false information is supplied toward securing the permit / any unauthorized changes are made to the site / any unauthorized changes are made in the installation of the system. **CONTACT A LOCATOR SERVICE PRIOR TO ANY EXCAVATION**

☐ **IMPROVEMENT PERMIT** *with plat valid without expiration.* ☐ **IMPROVEMENT PERMIT** *with site plan valid for 60 mos.* ☐ **AUTHORIZATION TO CONSTRUCT** *valid for period equal to IMPROVEMENT PERMIT--not to exceed 60 mo.*

Owner / Applicant Signature: Date: 10-14-15 Installed by:

IMPROVEMENT PERMIT by: Date: OPERATION PERMIT by: Date:

AUTHORIZATION TO CONSTRUCT by: Date: Existing System Inspected by: Date: APPROVED OCT 12 2015

Health Dept. Copy - WHITE Applicant (Final Approval) - YELLOW Applicant (Conditional Approval) - PINK