IREDELL COUNTY HEALTH DEPARTMENT

Authorization to Construct

4636 00 9982

STATESVILLE 704-878-5305 MOORESVILLE 704-664-5281

IMPROVEMENT PERMIT / ~~CERTIFICATE OF COMPLETION~~ / OPERATION PERMIT / EXISTING SYSTEM INSPECTION

PROPERTY DESCRIPTION NO. 23046 DATE 2/8/96 TAX MAP NO. 2G 23 B 23 Watershed: X Yes ☐ No

OWNER OR CONTRACTOR Robert Simpson Homes PHONE: Business 704-391-3715 Home

ADDRESS 2900B I-85 Service Rd. Charlotte, NC 28208

LOCATION Brawley School Rd. (L) side of Pines TR Cove Creek (L) on Wynsong (R) on Wynwood (R) on N. Shore on (L) corner

SUBDIVISION North Shore BLOCK / SECTION II LOT 23 LOT AREA .6 AC SITE CLASS P5 DESIGN FLOW 360 L.T.A.R. .35

Septic Tank: 1000 Gallons; STB 794 Date 1-23-96

Pump Tank: Gallons; PT Date

Pump Make: Model Serial No.

Nitrification Field: No Fields Square Feet 1028 Linear Feet *258

No Lines 3 Trench Width 36" Max Trench Bottom Depth 36" Gravel Depth 6" SAND

X New System ☐ Repair System Type: I. II. (III) IV. V. VI

System Description: GRAV INFILTRATOR

Repair System Description: PRESSURE INFILTRATOR

Maintenance Agreement Required: ☐ Yes X No

X House/Mod. Home No. Bedrooms 3

☐ Mobile Home No. Bathrooms 2.5

☐ Business No. Employees

☐ Other


☐ Slab X Crawl Space ☐ Basement w/plumbing ☐ Basement wo/plumbing

Water Supply: ☐ Individual X Community ☐ Public


Comments: *259c Reduction for infiltrator use Sand backfill to top of louvers on each pond.

Comments:

INITIAL SITE SKETCH

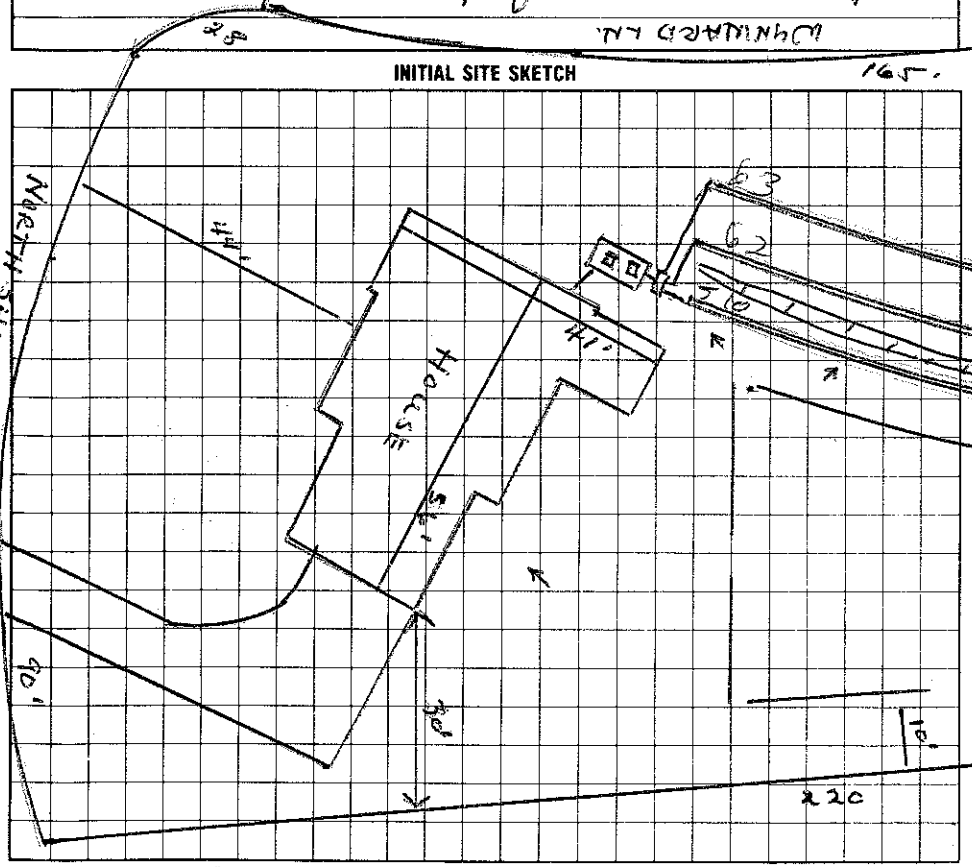

AS BUILT SKETCH

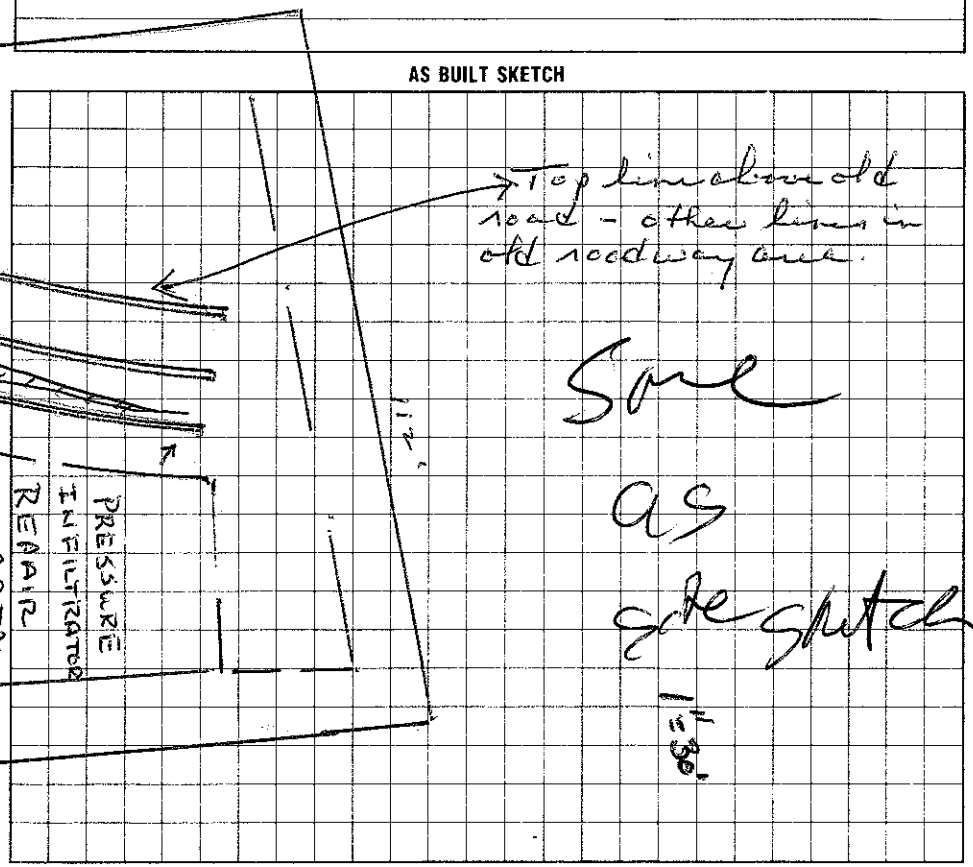

I understand that this permit can be suspended or revoked if any false information is supplied toward securing the permit/any unauthorized changes are made to the site/any unauthorized changes are made in the installation of the system.

Signed:

Improvement Permit by: Wesley Parks R.S. date 2/8/96

~~Certificate of Completion by:~~ Existing System Inspection by: Wesley Parks R.S. date 2/8/96

Installed by: Ironhorse Grading

Certificate of Completion by: date

Operation Permit by: FOR BD date 5/16/96

HEALTH DEPT. COPY: WHITE INSPECTION COPY (FINAL): GREEN OWNER COPY (FINAL): YELLOW INSPECTION COPY (INITIAL): PINK OWNER COPY (INITIAL): GOLD