IREDELL COUNTY HEALTH DEPARTMENT

Statesville Office (704) 878-5305 Mooresville Office (704) 660-3625 PERMIT # ~~13804~~ OP -7 205697

IMPROVEMENT PERMIT / AUTHORIZATION TO CONSTRUCT / OPERATION PERMIT / EXISTING SYSTEM

PIN # 4636013412

APPLICANT: David Christopher Mark Benite APPLICANT ADDRESS: P.O. Box 140090 Grand Rapids, Mi. 49534

SITE ADDRESS: 253 Cove Creek Ln. Mooresville, NC PHONE: ALT. PHONE: Kathleen 704 578-4951

SITE DIRECTIONS: Brawley School Rd TL Isle of Pines TR Cove Creek on right past Charthouse Ln

SUBDIVISION: Chesapeake Pointe SECTION: III LOT # 44 LOT AREA: 2.18 Ac. DESIGN FLOW: 480gpd L.T.A.R.: .3

Septic Tank 1000 (gal) STB Date
Pump Tank (gal) PT Date
Pump Make Model Serial #
Nitrification Fields 1 # Lines 5 Linear Ft: 400
Trench Width 36" Max. Trench Bottom Depth 36" Gravel Depth N/A

☒ New System ☐ Repair ☐ Expansion System Type: I II (III) IV V VI
System Description: Gravity - 25% Reduction
Repair System Description: LPP BPS
Maintenance Agreement Required: ☐ YES ☒ NO
☒ GRAVITY ☐ PRESSURE

☒ Residence ☐ Business ☐ Other ☐ Slab ☐ Basement w/plumbing
No. Bedrooms 4 No. Persons 8 No. Employees
☒ Crawl Space ☐ Basement w/o plumbing

Water Supply: ☐ Private ☐ Public ☒ Community

Comments / Conditions: *Note: Plumbing must be Stubbed out high in order for gravity flow to Septic Tank, Otherwise a "Pump" System will be required.

7/29/14 Reviewed Floor Plans, in Compliance With Improvement Permit

INITIAL SITE SKETCH

See approved plan by Kathleen Saunders LSS (dated 3-10-14)

AS BUILT SKETCH

Plumbing Stubbed out Low. Tank Location was Moved To Accomodate Gravity System. Refer To As Built Submitted From The Oaks Group Dated 4/2/15. Additional Repair Available.

Permit can be suspended or revoked if any false information is supplied toward securing the permit / any unauthorized changes are made to the site / any unauthorized changes are made in the installation of the system. **CONTACT A LOCATOR SERVICE PRIOR TO ANY EXCAVATION**

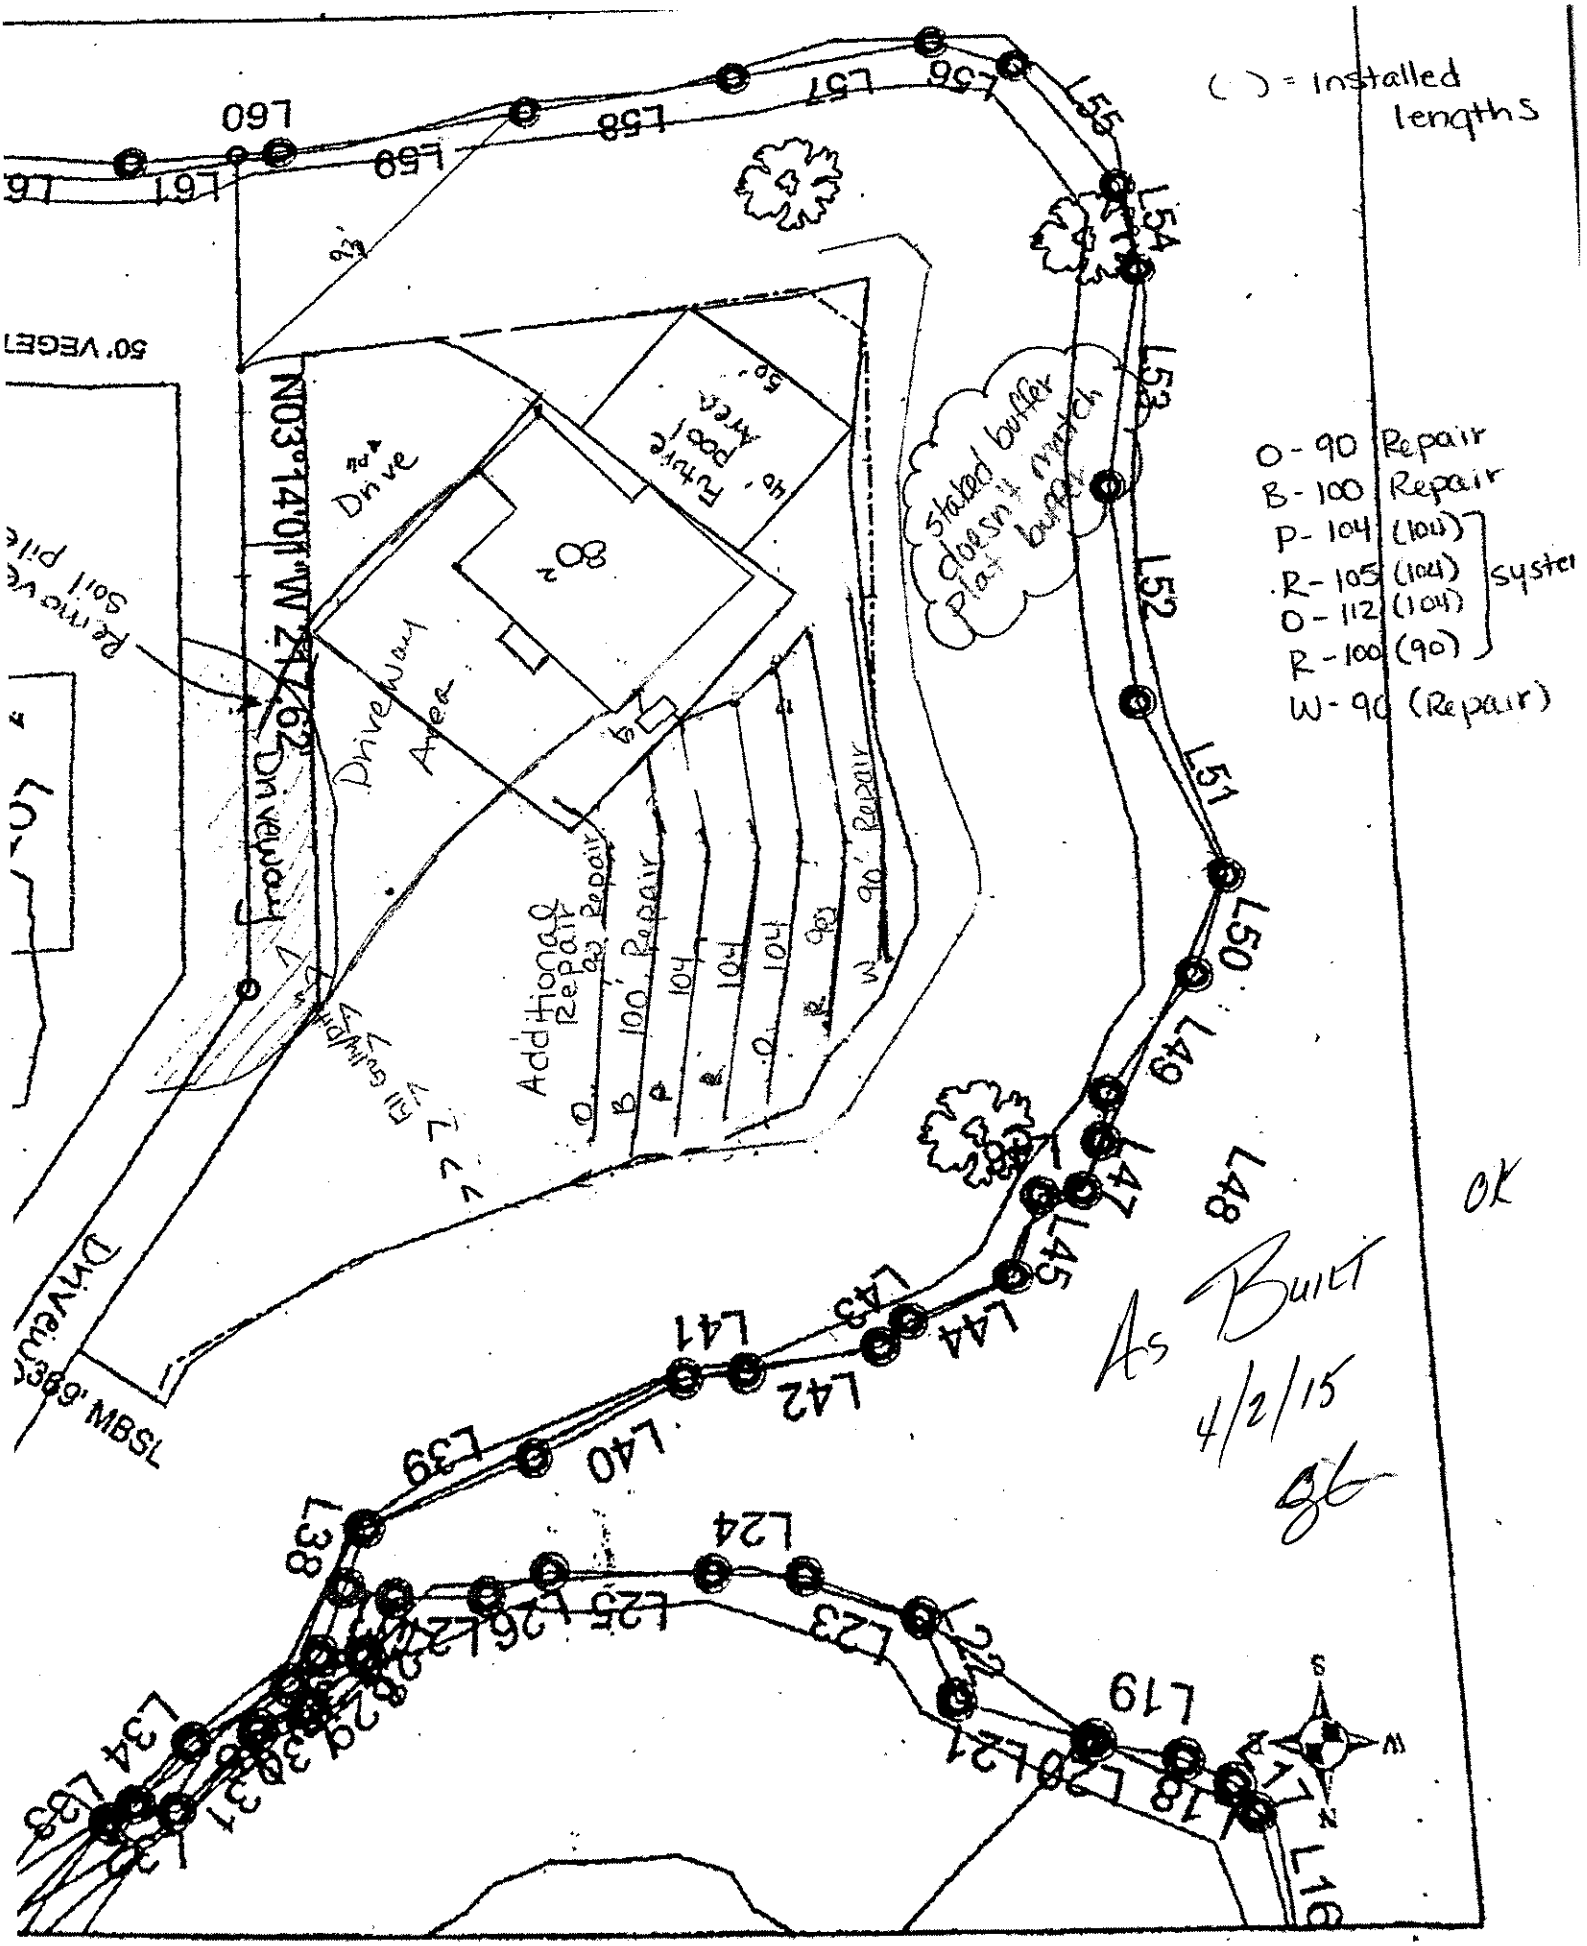
☐ **IMPROVEMENT PERMIT** *with plat valid without expiration.* ☑ **IMPROVEMENT PERMIT** *with site plan valid for 60 mos.* ☒ **AUTHORIZATION TO CONSTRUCT** *valid for period equal to IMPROVEMENT PERMIT--not to exceed 60 mo.*

Owner / Applicant Signature: Kathleen Saunders Date: 3-19-14 Installed by: Richard Abernathy

IMPROVEMENT PERMIT by: Maria Dotson RS Date: 3/17/14 OPERATION PERMIT by: APPROVED APR 07 2015 Date:

AUTHORIZATION TO CONSTRUCT by: Maria Dotson RS Date: 7/29/14 Existing System Inspected by: Date:

Health Dept. Copy - WHITE Applicant (Final Approval) - YELLOW Applicant (Conditional Approval) - PINK


( ) = Installed lengths
O - 90 Repair
B - 100 Repair
P - 104 (104)
R - 105 (104)
O - 112 (104)
R - 100 (90)
W - 90 (Repair)
system
Drive
Driveway Apron
Future Pool Area
80²
Stalled butter doesn't match Plat butter
Additional Repair
100' Repair
90' Repair
Driveway
Utility
50' VEGET
N03°14'01"W 27.02
698' MBSL
L16
L17
L18
L19
L20
L21
L22
L23
L24
L25
L26
L27
L28
L29
L30
L31
L32
L33
L34
L35
L36
L37
L38
L39
L40
L41
L42
L43
L44
L45
L47
L48
L49
L50
L51
L52
L53
L54
L55
L56
L57
L58
L59
L60
L61
OK
As Built
4/2/15