IREDELL COUNTY HEALTH DEPARTMENT

STATESVILLE 704-878-5305 MOORESVILLE 704-664-5281

IMPROVEMENT PERMIT / CERTIFICATE OF COMPLETION / OPERATION PERMIT / EXISTING SYSTEM INSPECTION

PROPERTY DESCRIPTION NO. 9332 DATE Sept. 22, '94 TAX MAP NO. 2623B38 Watershed: ☒ Yes ☐ No

OWNER OR CONTRACTOR Robert Ingraham Hemak PHONE: Business 4636-01-5017 Home

ADDRESS

LOCATION 1100 TL 1113 TR Cove Creek TL Wynwept TR Wynward TL North Shore on RT

SUBDIVISION North Shore BLOCK / SECTION 2 LOT 38 LOT AREA 20,000 sq ft SITE CLASS I5 per T15G DESIGN FLOW 360 gpd L.T.A.R. .3

Septic Tank: 1000 Gallons; STB ~~T&T~~ Bellinger Date 10-3-94

Pump Tank: Gallons; PT Date

Pump Make: Model Serial No.

Nitrification Field: No Fields 1 Square Feet 1200 Linear Feet 400

No Lines 5 Trench Width 36" Max Trench Bottom Depth 30" Gravel Depth 12"

☑ New System ☐ Repair System Type: I, (II) III, IV, V, VI

System Description: gravity conventional

Repair System Description: gravel LP PPBPS

Maintenance Agreement Required: ☐ Yes ☒ No

☒ House/Mod. Home ☐ Mobile Home ☐ Business ☐ Other

No. Bedrooms 3 No. Bathrooms 2½ No. Employees


☐ Slab ☐ Crawl Space ☒ Basement w/plumbing ☐ Basement wo/plumbing

Water Supply: ☐ Individual ☑ Community ☐ Public


Comments: follow contour w/ laterals, keep laterals shallow, no deeper than specified trench bottom depth.

Comments:

INITIAL SITE SKETCH

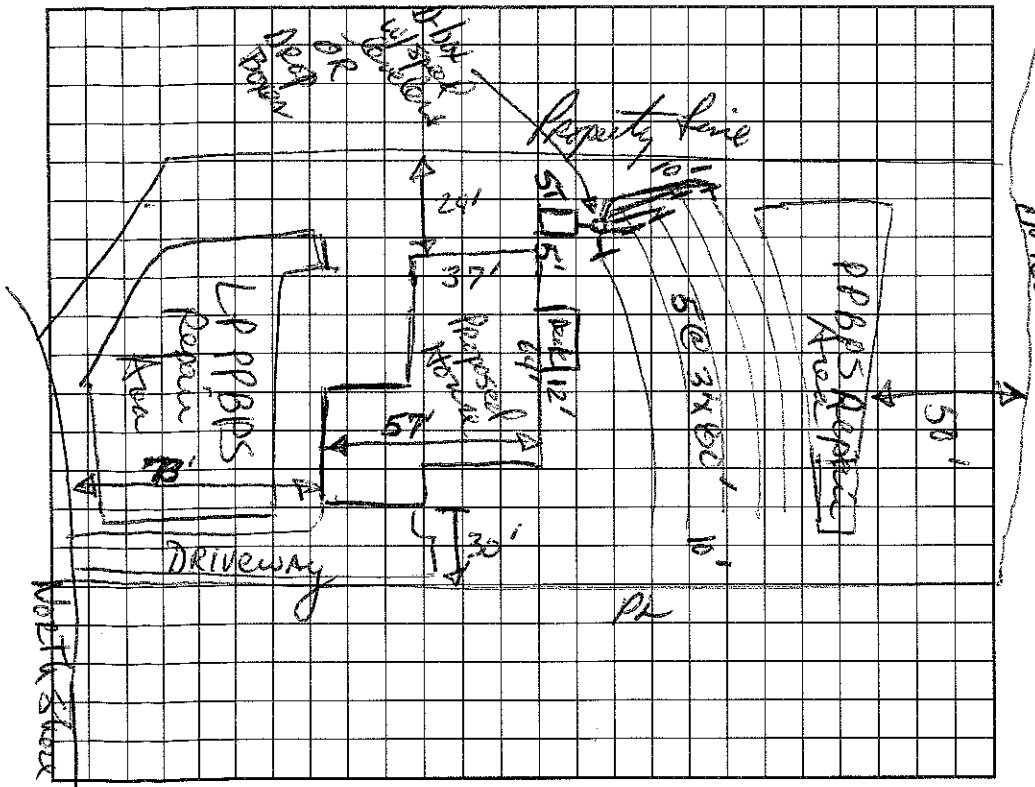

AS BUILT SKETCH

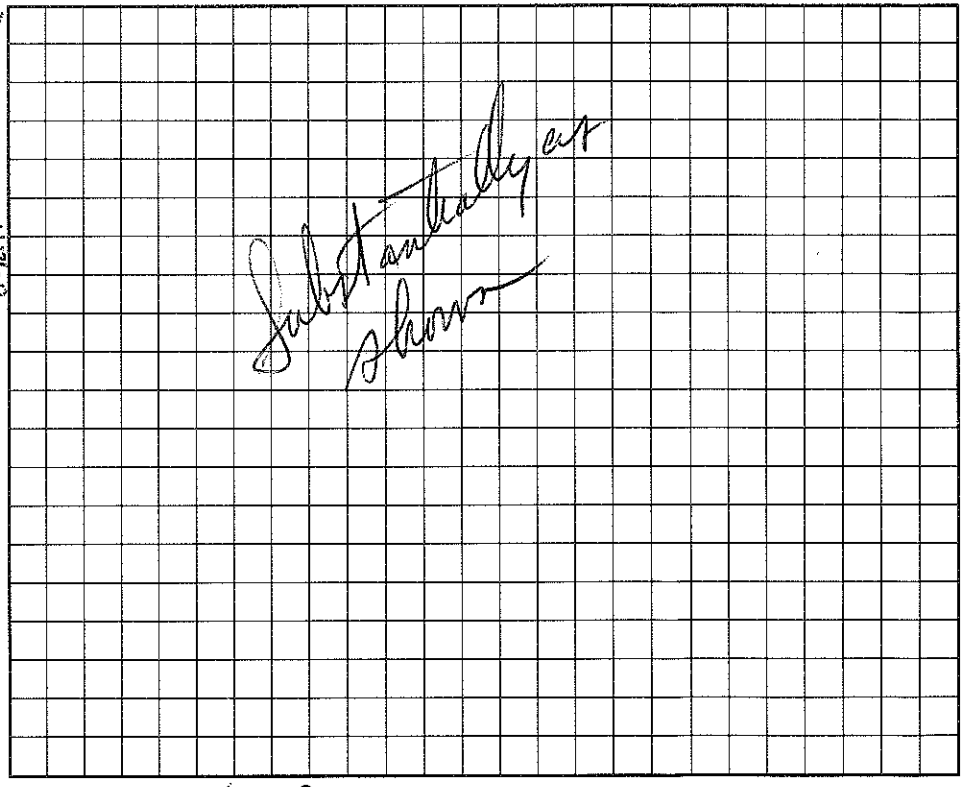

I understand that this permit can be suspended or revoked if any false information is supplied toward securing the permit/any unauthorized changes are made to the site/any unauthorized changes are made in the installation of the system. Improvement Permit is valid for 60 months from date of issuance.

Signed:

Improvement Permit by: R. Hamm, RS date 9/22/94

Existing System Inspection by: date

Installed by: Ken Painter

Certificate of Completion by: J R Hamm, RS date 1-12-95

Operation Permit by: date

HEALTH DEPT. COPY: WHITE INSPECTION COPY (FINAL): GREEN OWNER COPY (FINAL): YELLOW INSPECTION COPY (INITIAL): PINK OWNER COPY (INITIAL): GOLD