IREDELL COUNTY HEALTH DEPARTMENT

STATESVILLE 704-878-5305 MOORESVILLE 704-664-5281

IMPROVEMENT PERMIT / CERTIFICATE OF COMPLETION / OPERATION PERMIT / EXISTING SYSTEM INSPECTIO[N]

PROPERTY DESCRIPTION NO. 9332 DATE Sept. 22, 94 TAX MAP NO. 2G23B38 Watershed: ☒ Yes ☐ No

OWNER OR CONTRACTOR Robert Ingraham Homes PHONE: Business ______ Home ______

ADDRESS ______

LOCATION 1100 TL 1113 TR Cove Creek TL Wynwood TR Wynwood TL North Shore on Rt


SUBDIVISION North Shore BLOCK / SECTION ______ LOT 38 LOT AREA 29,000 ft² SITE CLASS PS ______ DESIGN FLOW 360 gpd L.T.A.R. .3

Septic Tank: 1000 Gallons; STE ______ Date 10-3-94 Pump Tank: ______ Gallons; PT ______ Date ______ Pump Make: ______ Model ______ Serial No. ______ Nitrification Field: No Fields 1 Square Feet 1200 Linear Feet 400 No Lines 5 Trench Width 36" Max Trench Bottom Depth 30"	☑ New System ☐ Repair System Type: I, ⓘII, III, IV, V, VI System Description: gravity conventional Repair System Description: gravel LP, PPBPS Maintenance Agreement Required: ☐ Yes ☒ No Gravel Depth 12" ☐ Slab ☐ Crawl Space ☒ Basement w/plumbing ☐ Basement w/o plumbing	☒ House/Mod. Home No. Bedrooms 3 ☐ Mobile Home No. Bathrooms 2½ ☐ Business No. Employees ______ ☐ Other ______ Water Supply: ☐ Individual ☑ Community ☐ Public


Comments: Follow contour w/ laterals & keep laterals shallow, no deeper than specified trench bottom depth.

Comments:

INITIAL SITE SKETCH

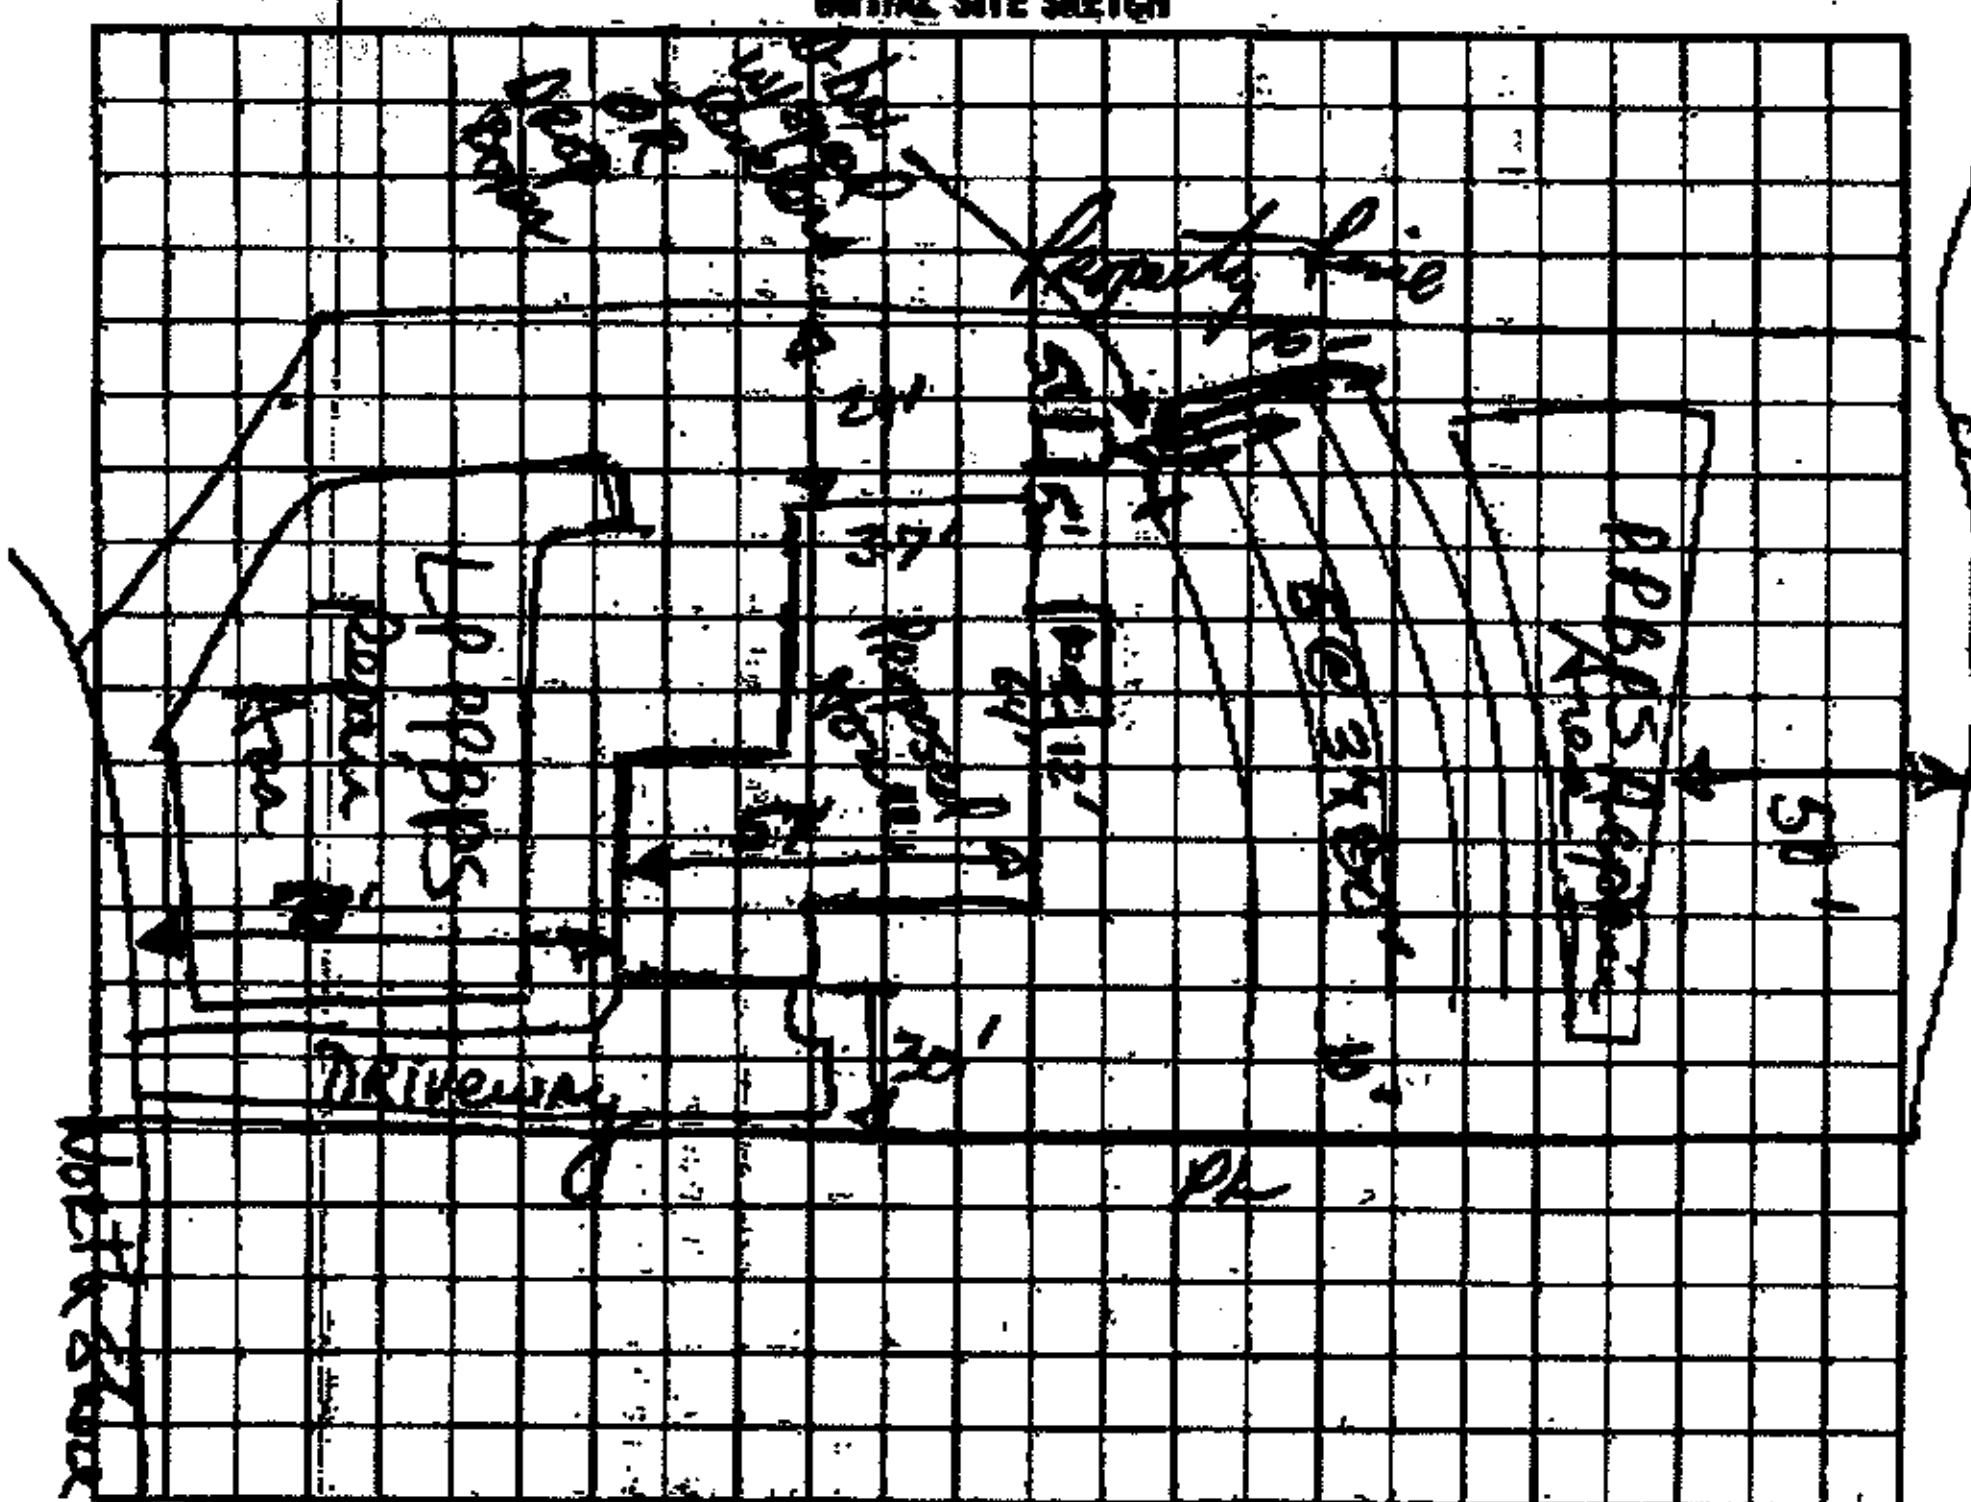

AS BUILT SKETCH

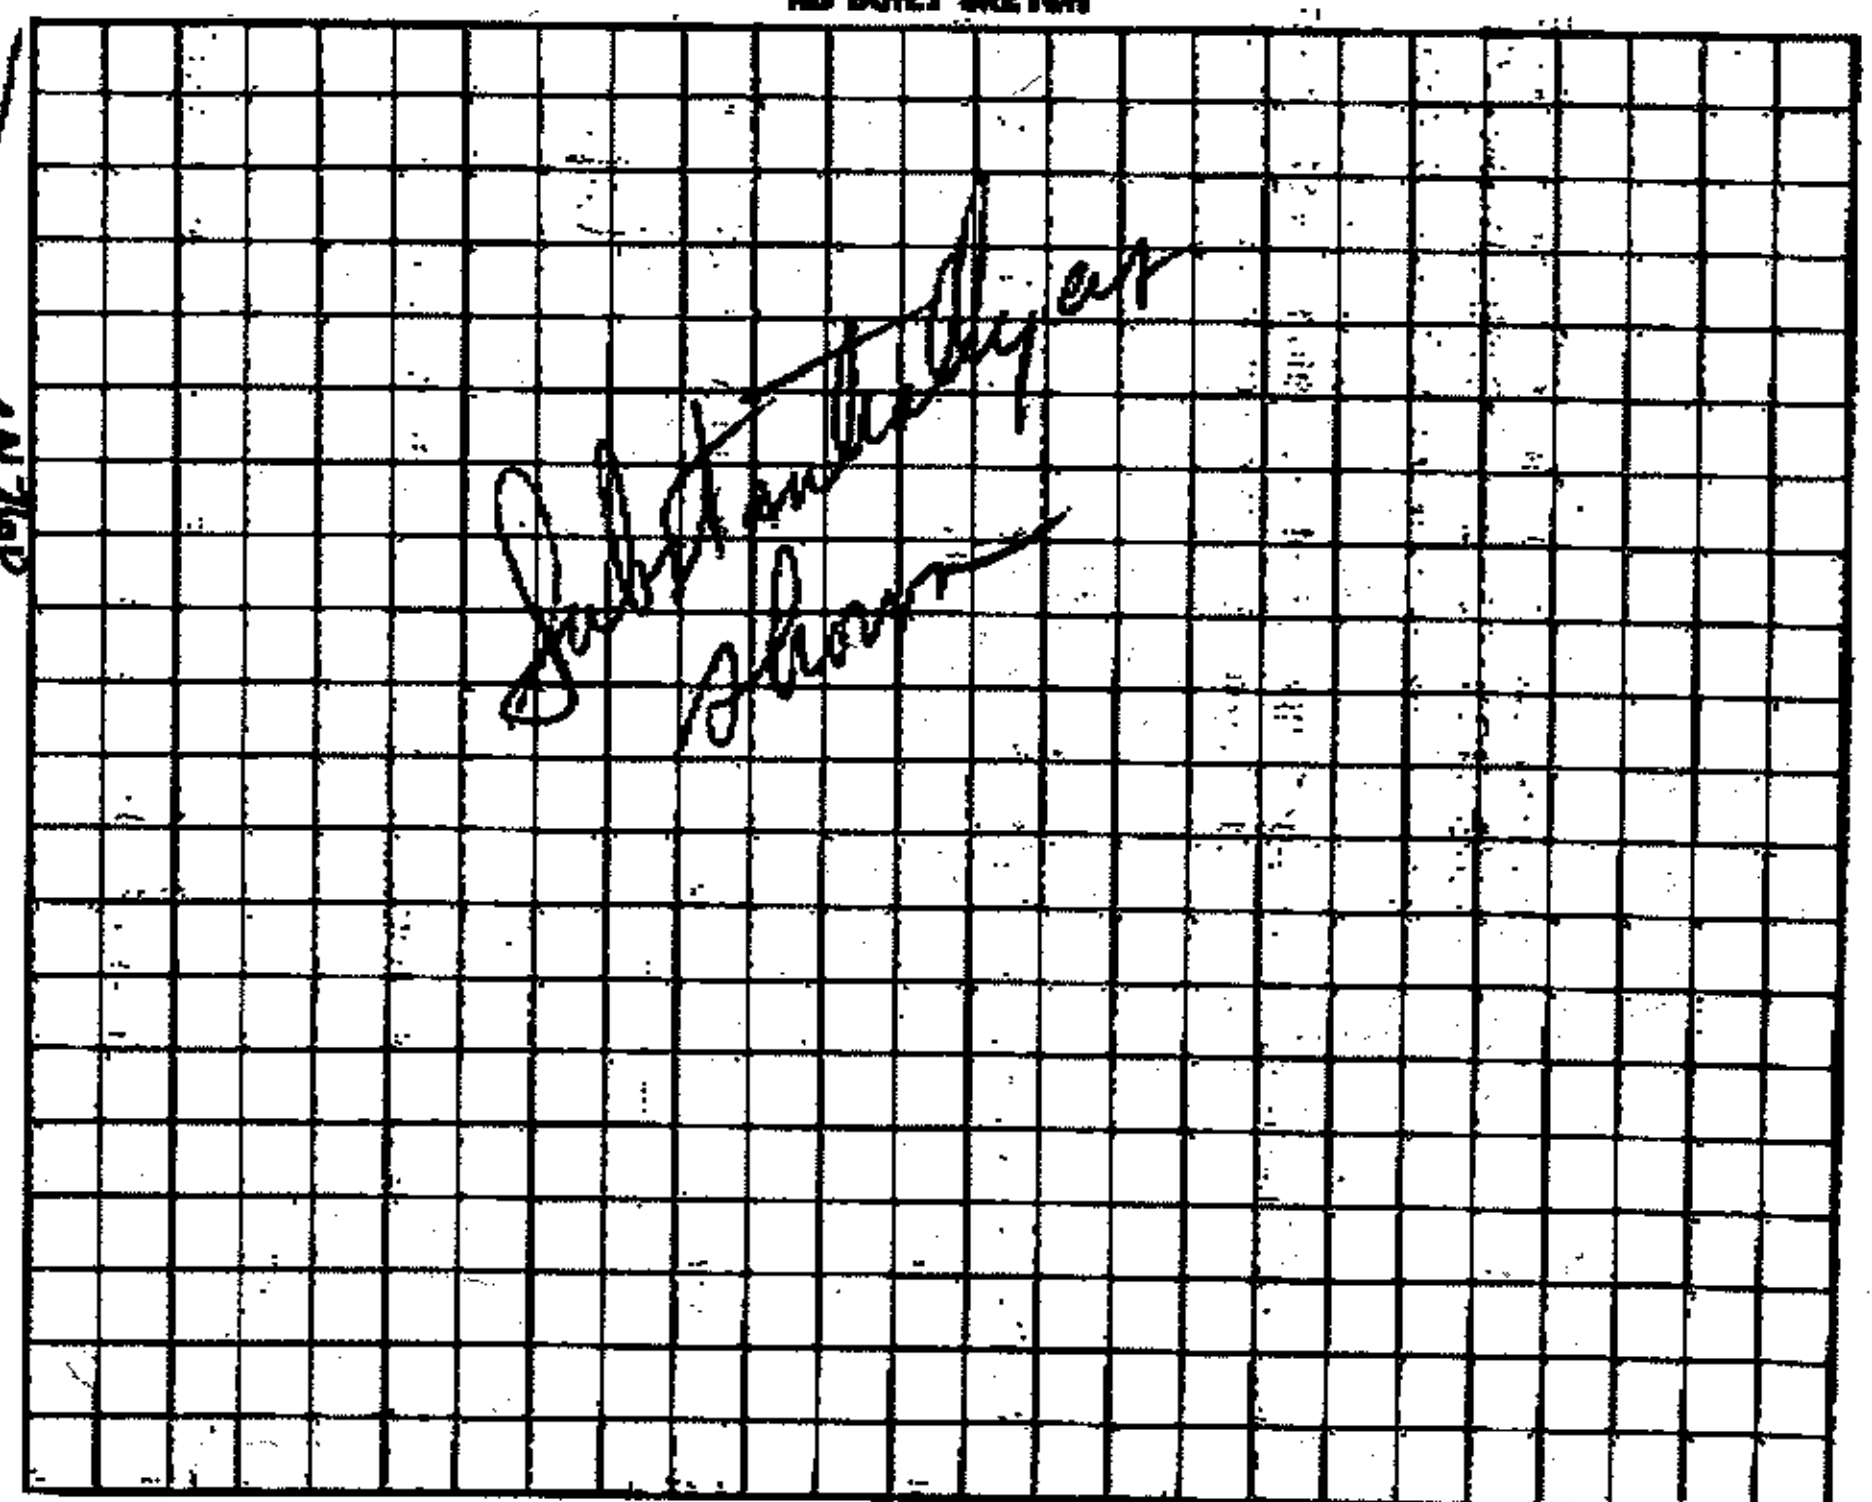

I understand that this permit can be suspended or revoked if any false information is supplied toward securing the permit/any unauthorized changes are made to the site/any unauthorized changes are made in the installation of the system. Improvement Permit is valid for 60 months from date of issuance.

Signed: ______

Improvement Permit by: ______, RS date 9/22/94

Existing System Inspection by: ______ date ______

Installed by: Ken Painter

Certificate of Completion by: ______, RS date 1-12-95

Operation Permit by: ______ date ______

HEALTH DEPT. COPY: WHITE INSPECTION COPY (FINAL): GREEN OWNER COPY (FINAL): YELLOW INSPECTION COPY (INITIAL): PINK OWNER COPY (INITIAL): GOLD