Repair

IREDELL COUNTY HEALTH DEPARTMENT - *ENVIRONMENTAL HEALTH* ☐ STATESVILLE OFFICE 704-878-5305 ☐ MOORESVILLE OFFICE 704-664-5281

IMPROVEMENT PERMIT / AUTHORIZATION TO CONSTRUCT / OPERATION PERMIT / EXISTING SYSTEM INSPECTION

PERMIT # 167290 PIN # 4636016039 DATE 7-7-2011

OWNER Mike Matlock APPLICANT: Edge Building PHONE: Home/Cell # Business # 980 721 6778

SITE ADDRESS 118 North Shore Dr. OWNER / APPLICANT ADDRESS 118 Northshore Dr. Mooresville NC 28117

SITE DIRECTIONS Brawley School Rd TL Isle of Pines TR Cove Creek TL Wynswept TR Wynward TL North Shore

SUBDIVISION Northshore BLOCK / SECTION II LOT # 39 LOT AREA .68 Acre DESIGN FLOW 480 gpd L.T.A.R. .3

Septic Tank 1000 Gallons: STB 794 Date 3-11-07 ☐ New System ☒ Repair ☐ Expansion System Type I II III IV V VI ☒ Residence No. Bedrooms 4 Water Supply

Pump Tank ____ Gallons: P T ____ Date ____ System Description: Stone Gray Plastic Chamber ☐ Business No. Persons ____ ☐ Private


Pump Make ____ Model ____ Serial # ____ Repair System Description: Pump Panel Block, ☐ Other No. Employees ____ ☒ Public

No. Nitrification Fields: 1 No. Lines 5 Linear Feet 400 Maintenance Agreement Required ☐ YES ☒ NO ☐ Slab ☒ Crawl Space ☐ Community


Trench Width 36" Max. Trench Bottom Depth ____ Gravel Depth ____ ☒ GRAVITY ☐ PRESSURE ☐ Basement w/plumbing ☐ Basement w/o plumbing

Comments / Conditions Replace existing ST with new ST (Existing ST Concrete is deteriorating) Pump out ST, crush & backfill.

INITIAL SITE SKETCH

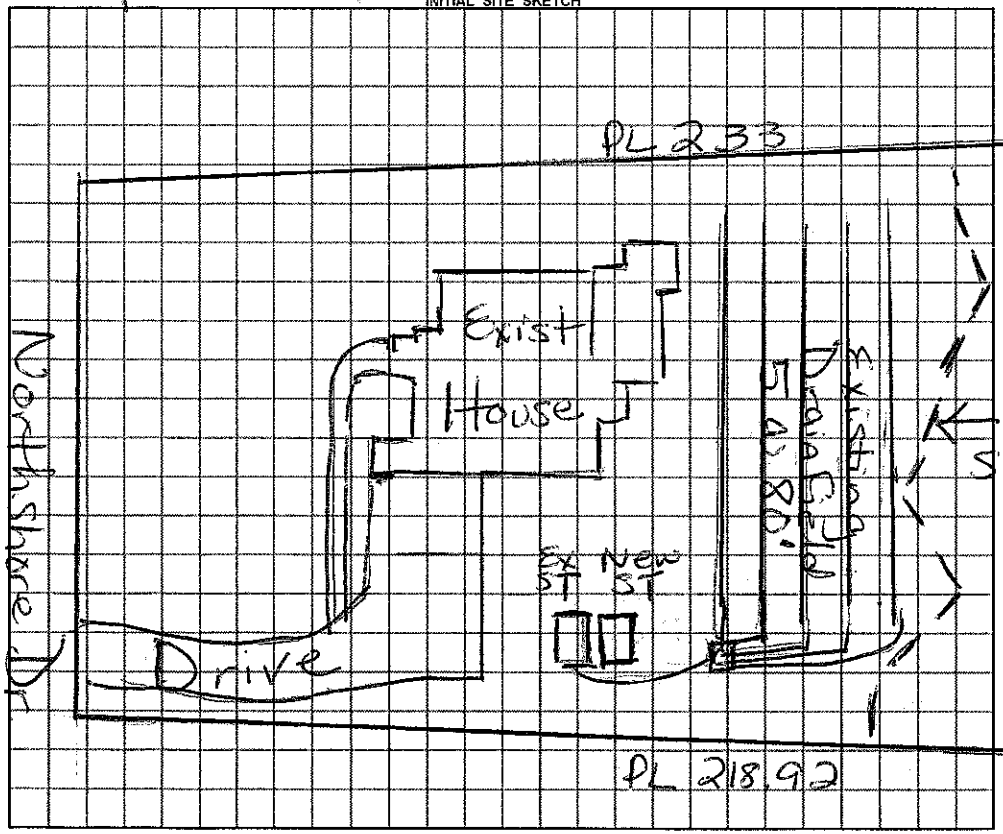

AS BUILT SKETCH

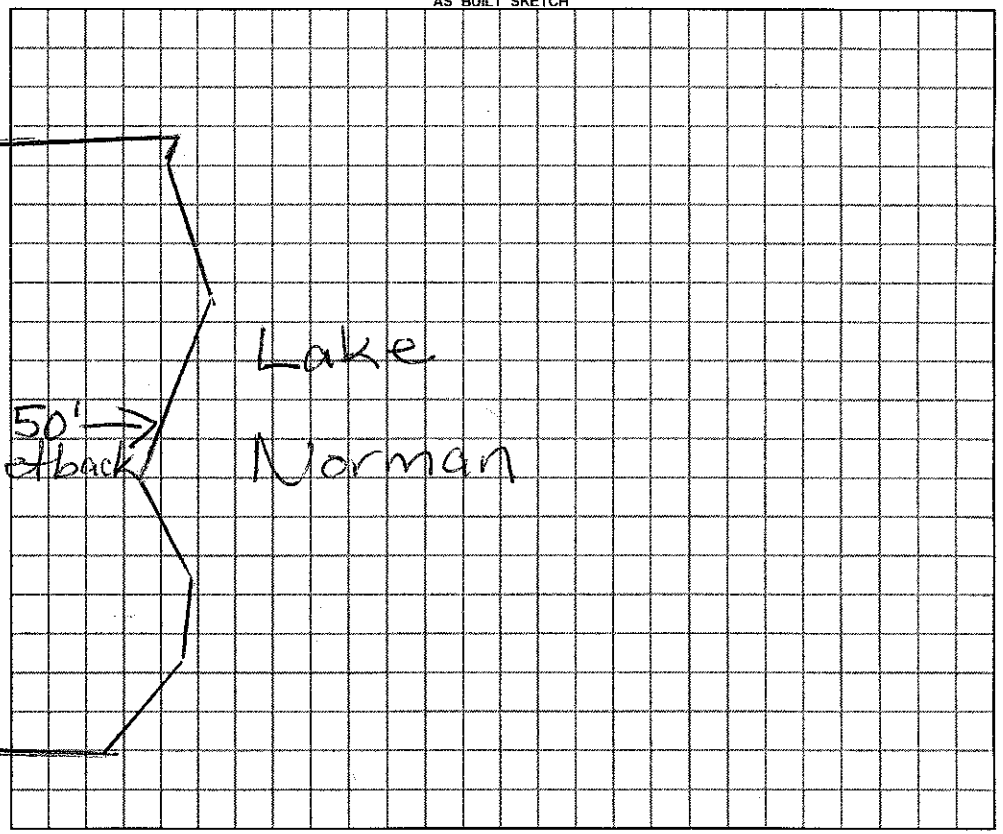

Permit can be suspended or revoked if any false information is supplied toward securing the permit / any unauthorized changes are made to the site / any unauthorized changes are made in the installation of the system.

☐ ***IMPROVEMENT PERMIT*** *with plat valid without expiration.* ☐ ***IMPROVEMENT PERMIT*** *with ~~plat valid without expiration.~~ site plan valid 60 mo.* ☐ ***AUTHORIZATION TO CONSTRUCT*** valid for period equal to IMPROVEMENT PERMIT--not to exceed 60 mo.

Owner / Applicant Signature: ____ Date ____ Installed by: Tron Horse 8/21/96

IMPROVEMENT PERMIT by: [signature] REHS Date 7/7/2011 OPERATION PERMIT by: [signature] REHS Date 7-12-11

AUTHORIZATION TO CONSTRUCT by: [signature] REHS Date 7/7/2011 Existing System Inspected by: ____ REHS Date ____

YOU SHOULD CONTACT A LOCATOR SERVICE PRIOR TO ANY EXCAVATION

White Copy – Environmental Health YELLOW COPY (Final) Owner / Applicant PINK COPY (Initial) Owner / Applicant