IREDELL COUNTY HEALTH DEPARTMENT

Statesville Office (704) 878-5305 Mooresville Office (704) 660-3625 PERMIT # 206349

IMPROVEMENT PERMIT / AUTHORIZATION TO CONSTRUCT / OPERATION PERMIT / EXISTING SYSTEM

PIN # 4636016415

APPLICANT: CP III / Mark Benitez APPLICANT ADDRESS: 3125 Presidential Pkwy Ste 200 Atlanta, GA 30340

SITE ADDRESS: 249 Cove Creek Mooresville NC 28117 PHONE: ALT. PHONE: 704 576-3889 Mike

SITE DIRECTIONS: Brawley School Rd TL Isle of Pines TR Cove Creek on right

SUBDIVISION: Chesapeake Pt. SECTION: III LOT # 46 LOT AREA: 1.31 Acres DESIGN FLOW: 480gpd L.T.A.R.: .25

Septic Tank 1000 (gal) STB Date
Pump Tank (gal) PT Date
Pump Make Model Serial #
Nitrification Fields 1 # Lines 5 Linear Ft: 500'
Trench Width 36" Max. Trench Bottom Depth ~~30~~ 57" Gravel Depth N/A

☒ New System ☐ Repair ☐ Expansion System Type: I II (III) IV V VI
System Description: Gravity - 25% Reduction
Repair System Description: JPPBPS
Maintenance Agreement Required: ☐ YES ☒ NO
☒ GRAVITY ☐ PRESSURE

☒ Residence ☐ Business ☐ Other ☐ Slab ☐ Basement w/plumbing
No. Bedrooms 4 No. Persons 8 No. Employees
☒ Crawl Space ☐ Basement w/o plumbing

Water Supply: ☐ Private ☐ Public ☒ Community

Comments / Conditions: * Direct stormwater away from Septic System.

* This permit replaces previous permit dated 10/24/2006

INITIAL SITE SKETCH

See approved/attached plan by Michael Athanas & Assoc. (received May 19, 2015)

AS BUILT SKETCH

INSTALLED AS SHOWN BA

Permit can be suspended or revoked if any false information is supplied toward securing the permit / any unauthorized changes are made to the site / any unauthorized changes are made in the installation of the system. **CONTACT A LOCATOR SERVICE PRIOR TO ANY EXCAVATION**

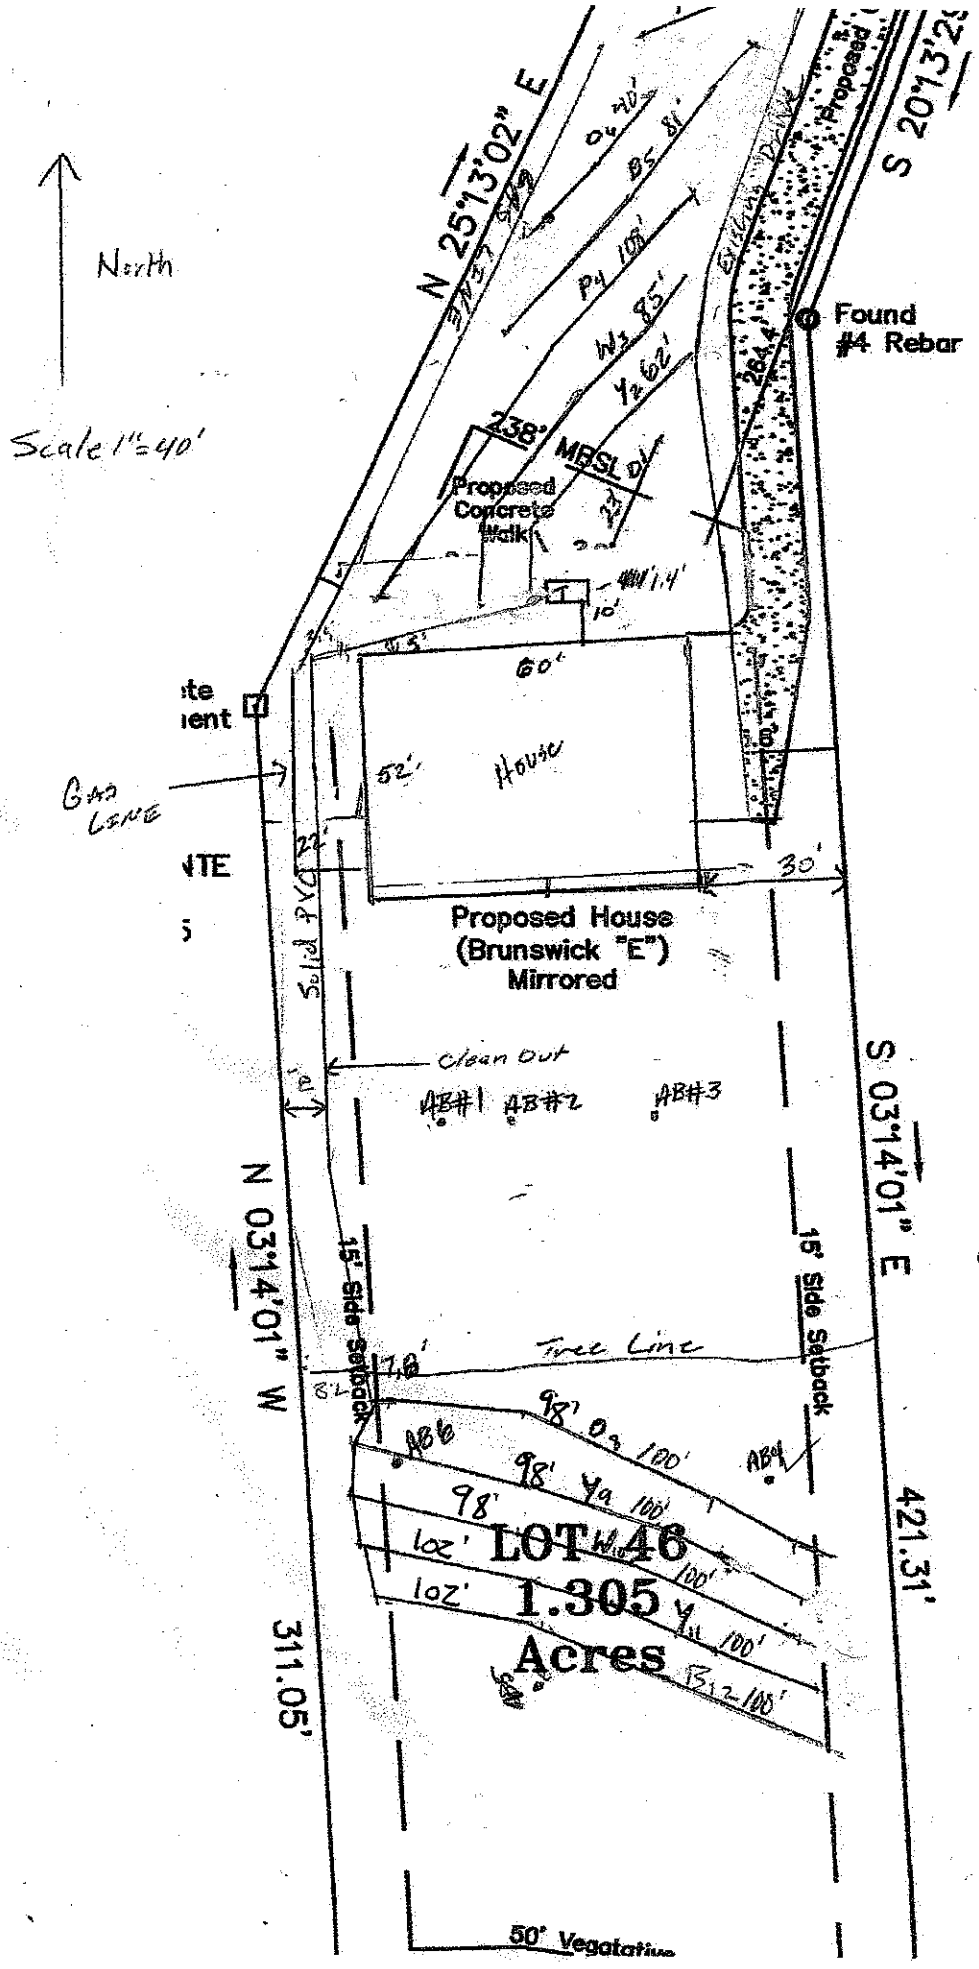
☐ **IMPROVEMENT PERMIT** *with plat valid without expiration.* ☐ **IMPROVEMENT PERMIT** *with site plan valid for 60 mos.* ☐ **AUTHORIZATION TO CONSTRUCT** *valid for period equal to IMPROVEMENT PERMIT--not to exceed 60 mo.*

Owner / Applicant Signature: Date: 5-28-15 Installed by: ABERNATHY

IMPROVEMENT PERMIT by: Mariah H. Dotson RS Date: 5/21/15 OPERATION PERMIT by: BA Date: APPROVED JUN 12 2015

AUTHORIZATION TO CONSTRUCT by: Mariah H. Dotson RS Date: 5/21/15 Existing System Inspected by: Date:

Health Dept. Copy - WHITE Applicant (Final Approval) - YELLOW Applicant (Conditional Approval) - PINK


North
Scale 1"=40'
N 25°13'02" E
S 20°13'2
Found
#4 Rebar
Proposed Concrete Walk
MBSL
60'
House
52'
30'
Proposed House
(Brunswick "E")
Mirrored
Gas Line
Clean Out
AB#1
AB#2
AB#3
AB#4
AB#6
Tree Line
15' Side Setback
15' Side Setback
N 03°14'01" W
S 03°14'01" E
311.05'
421.31'
LOT 46
1.305
Acres
50' Vegatative
LOT
CHESAPEAKE
PHASE
PB: 51, P