4636-01-7153

IREDELL COUNTY HEALTH DEPARTMENT

STATESVILLE 704-878-5305 MOORESVILLE 704-664-5281

IMPROVEMENT PERMIT / CERTIFICATE OF COMPLETION / OPERATION PERMIT / EXISTING SYSTEM INSPECTION

PROPERTY DESCRIPTION NO. 21158 DATE 7/6/95 TAX MAP NO. 2623 B40 Watershed: [X] Yes [ ] No

OWNER OR CONTRACTOR Robert Ingram Homes PHONE: Business 391-3715 Home

ADDRESS 2900-B Sandifer Rd. Charlotte, NC. 28203

LOCATION TR Conn Crk, TL Wynswept TR Wynwind TL North Shore, 3rd lot on (R) from corner

SUBDIVISION North Shore II BLOCK / SECTION II LOT 40 LOT AREA ~.6 AC SITE CLASS. P DESIGN FLOW 480 L.T.A.R. .35

Septic Tank: 1000 Gallons; STB 794 Date 7/10/95 [X] New System [ ] Repair System Type: I, II, III, (IV) V, VI

Pump Tank: 1000 Gallons; PT 29 Date 8/12/95 System Description: Pres. - Panel 16"

Pump Make: Model Serial No. Repair System Description:

Nitrification Field: No Fields 1 Square Feet 1371 Linear Feet *280 Maintenance Agreement Required: [X] Yes [ ] No

No Lines 4 Trench Width 24" Max Trench Bottom Depth 34" Gravel Depth 6" SAND [ ] Slab [ ] Crawl Space [X] Basement w/plumbing [ ] Basement wo/plumbing

[X] House/Mod. Home No. Bedrooms 4

[ ] Mobile Home No. Bathrooms 2.5

[ ] Business No. Employees


[ ] Other

Water Supply: [ ] Individual [X] Community [ ] Public

Comments:
*50% reduction for PBS use

Comments:
290 / 12 / 580 / 232 / 52 | 3480
60 / 3 / 360 / 180 / 2160
216 / .75 / 1080 / 540 / 1620

INITIAL SITE SKETCH

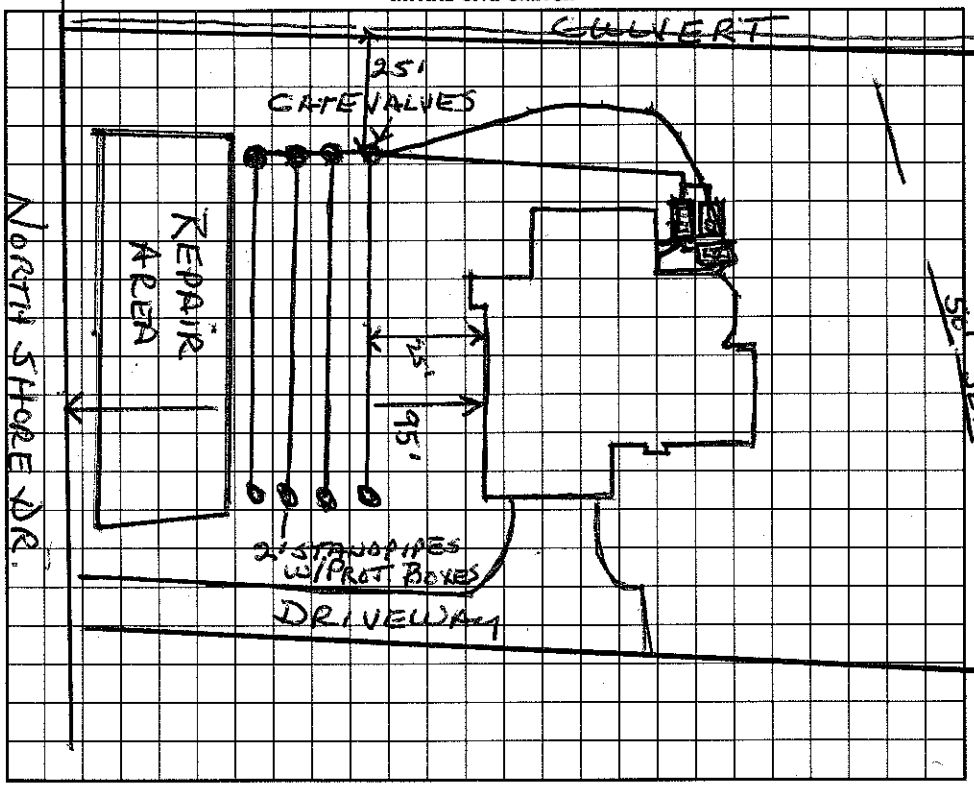

AS BUILT SKETCH



I understand that this permit can be suspended or revoked if any false information is supplied toward securing the permit/any unauthorized changes are made to the site/any unauthorized changes are made in the installation of the system. Improvement Permit is valid for 60 months from date of issuance.

Signed: 7-7-95

Improvement Permit by: Wesley Sparks RS. date 7/6/95

Existing System Inspection by: date

Installed by: Akron House Supply

Certificate of Completion by: Wesley Sparks RS. date 12/5/95

Operation Permit by: Wesley Sparks RS. date 12/5/95

HEALTH DEPT. COPY: WHITE INSPECTION COPY (FINAL): GREEN OWNER COPY (FINAL): YELLOW INSPECTION COPY (INITIAL): PINK OWNER COPY (INITIAL): GOLD