COPY

IREDELL COUNTY HEALTH DEPARTMENT

STATESVILLE 704-878-5305 MOORESVILLE 704-664-5281

IMPROVEMENT PERMIT / AUTHORIZATION TO CONSTRUCT / OPERATION PERMIT / EXISTING SYSTEM INSPECTION

PERMIT # REPAIR PIN # 4636-01-7153 DATE 4-21-11

OWNER or APPLICANT WILLIAM LEEDY PHONE: Business 704-770-8880 Home:

OWNER or APPLICANT ADDRESS 114 NORTH SHORE DR

LOCATION / DIRECTIONS BSR, ISLE OF PINES, 2ND COVE CK, WYNWARD, WYNSWEPT, NORTH SHORE, (R)

SUBDIVISION NORTH SHORE BLOCK / SECTION II LOT # 40 LOT AREA .683AC DESIGN FLOW 480 L.T.A.R. .35

Septic Tank MIN 1050 Gallons: STB TW 1050 Date

Pump Tank Gallons: P T Date

Pump Make Model Serial #

Nitrification Field No Fields No Lines ~~Linear Feet~~ INF

Trench Width Max. Trench Bottom Depth Gravel Depth

☐ New System ☒ Repair ☐ Expansion System Type I II III (IV) V VI

System Description: TANK

Repair System Description:

Maintenance Agreement Required ☐ YES ☐ NO

☐ GRAVITY ☐ PRESSURE

☐ Residence No. Bedrooms

☐ Business No. Persons

☐ Other No. Employees

☐ Slab ☐ Crawl Space


☐ Basement w/plumbing ☐ Basement w/o plumbing

Water Supply: ☐ Private ☐ Public ☐ Community


Comments / Conditions (1) INSTALL TANK AS SHOWN (2) MAY NEED PLASTIC TANK

Comments / Conditions

INITIAL SITE SKETCH

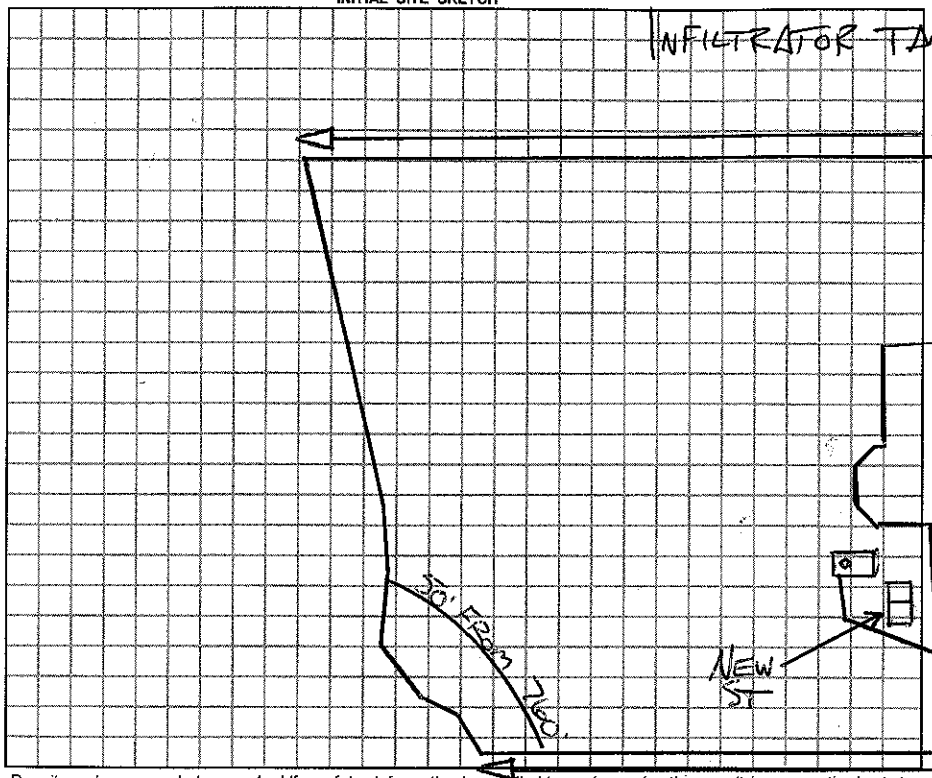

AS BUILT SKETCH

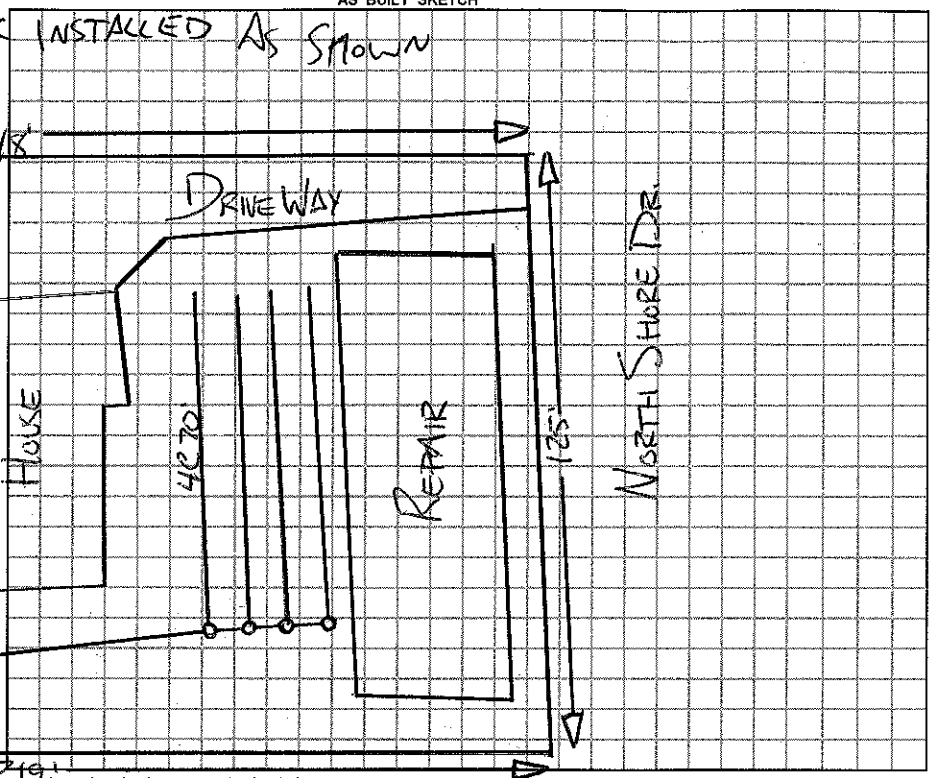

Permit can be suspended or revoked if any false information is supplied toward securing the permit / any unauthorized changes are made to the site / any unauthorized changes are made in the installation of the system.

☐ *IMPROVEMENT PERMIT w / plat valid without expiration.* ☐ *IMPROVEMENT PERMIT w / site plan valid for 60 mos.* ☐ *AUTHORIZATION TO CONSTRUCT valid for period equal to IMPROVEMENT PERMIT-not to exceed 60 mo.*

Owner / Applicant Signature: Dennis Daleke Date 4-26-11

Improvement Permit by: R.A. Ellis REHS Date 4-21-11

Authorzation to Construct by: R.A. Ellis REHS Date 4-21-11

YOU SHOULD CONTACT A LOCATOR SERVICE PRIOR TO ANY EXCAVATION.

Installed by: A-1

Operation Permit by: R.A. Ellis REHS Date: 4-27-11

Existing System Inspected by: Date:

WHITE COPY Environmental Health YELLOW COPY (Final) Owner / Applicant PINK COPY (Initial) Owner / Applicant