IREDELL COUNTY HEALTH DEPARTMENT

Statesville Office (704) 878-5305 Mooresville Office (704) 660-3625 PERMIT # 206350

IMPROVEMENT PERMIT / AUTHORIZATION TO CONSTRUCT / OPERATION PERMIT / EXISTING SYSTEM

PIN # 4636017408

APPLICANT: CP III LLC APPLICANT ADDRESS: 3125 RESIDENTIAL PKWY ATLANTA GA

SITE ADDRESS: 247 COVE CREEK - MOORESVILLE PHONE: ALT. PHONE:

SITE DIRECTIONS: BRAWLEY SCHOOL - TL ISLE OF PINES - TR 2nd COVE CREEK - ON LT

SUBDIVISION: CHESAPEAKE PT SECTION: 3 LOT # 47 LOT AREA: 1.32 AC DESIGN FLOW: 480 L.T.A.R.: .3

Septic Tank 1000 (gal) STB 794 Date 3-30-15

Pump Tank (gal) PT Date

Pump Make Model Serial #

Nitrification Fields 1 # Lines 5 Linear Ft: 405

Trench Width 36" Max. Trench Bottom Depth 36" Gravel Depth N/A

☑ New System ☐ Repair ☐ Expansion System Type: I II (III) IV V VI

System Description: GRAVITY 25% REDUCTION

Repair System Description: LPPBPS

Maintenance Agreement Required: ☐ YES ☑ NO

☑ GRAVITY ☐ PRESSURE

☑ Residence ☐ Business ☐ Other ☐ Slab ☐ Basement w/plumbing

No. Bedrooms 4 No. Persons 8 No. Employees

☑ Crawl Space ☐ Basement w/o plumbing

Water Supply: ☐ Private ☐ Public ☑ Community

Comments / Conditions:

INITIAL SITE SKETCH

SEE MICHAEL ATHANAS & ASSOCIATES PLAN

AS BUILT SKETCH

INSTALLED AS DRAWN

BA

Permit can be suspended or revoked if any false information is supplied toward securing the permit / any unauthorized changes are made to the site / any unauthorized changes are made in the installation of the system. **CONTACT A LOCATOR SERVICE PRIOR TO ANY EXCAVATION**

☐ **IMPROVEMENT PERMIT** *with plat valid without expiration.* ☑ **IMPROVEMENT PERMIT** *with site plan valid for 60 mos.* ☑ **AUTHORIZATION TO CONSTRUCT** *valid for period equal to IMPROVEMENT PERMIT--not to exceed 60 mo.*

Owner / Applicant Signature: Date: 5-19-15

IMPROVEMENT PERMIT by: Date: 5/18/15

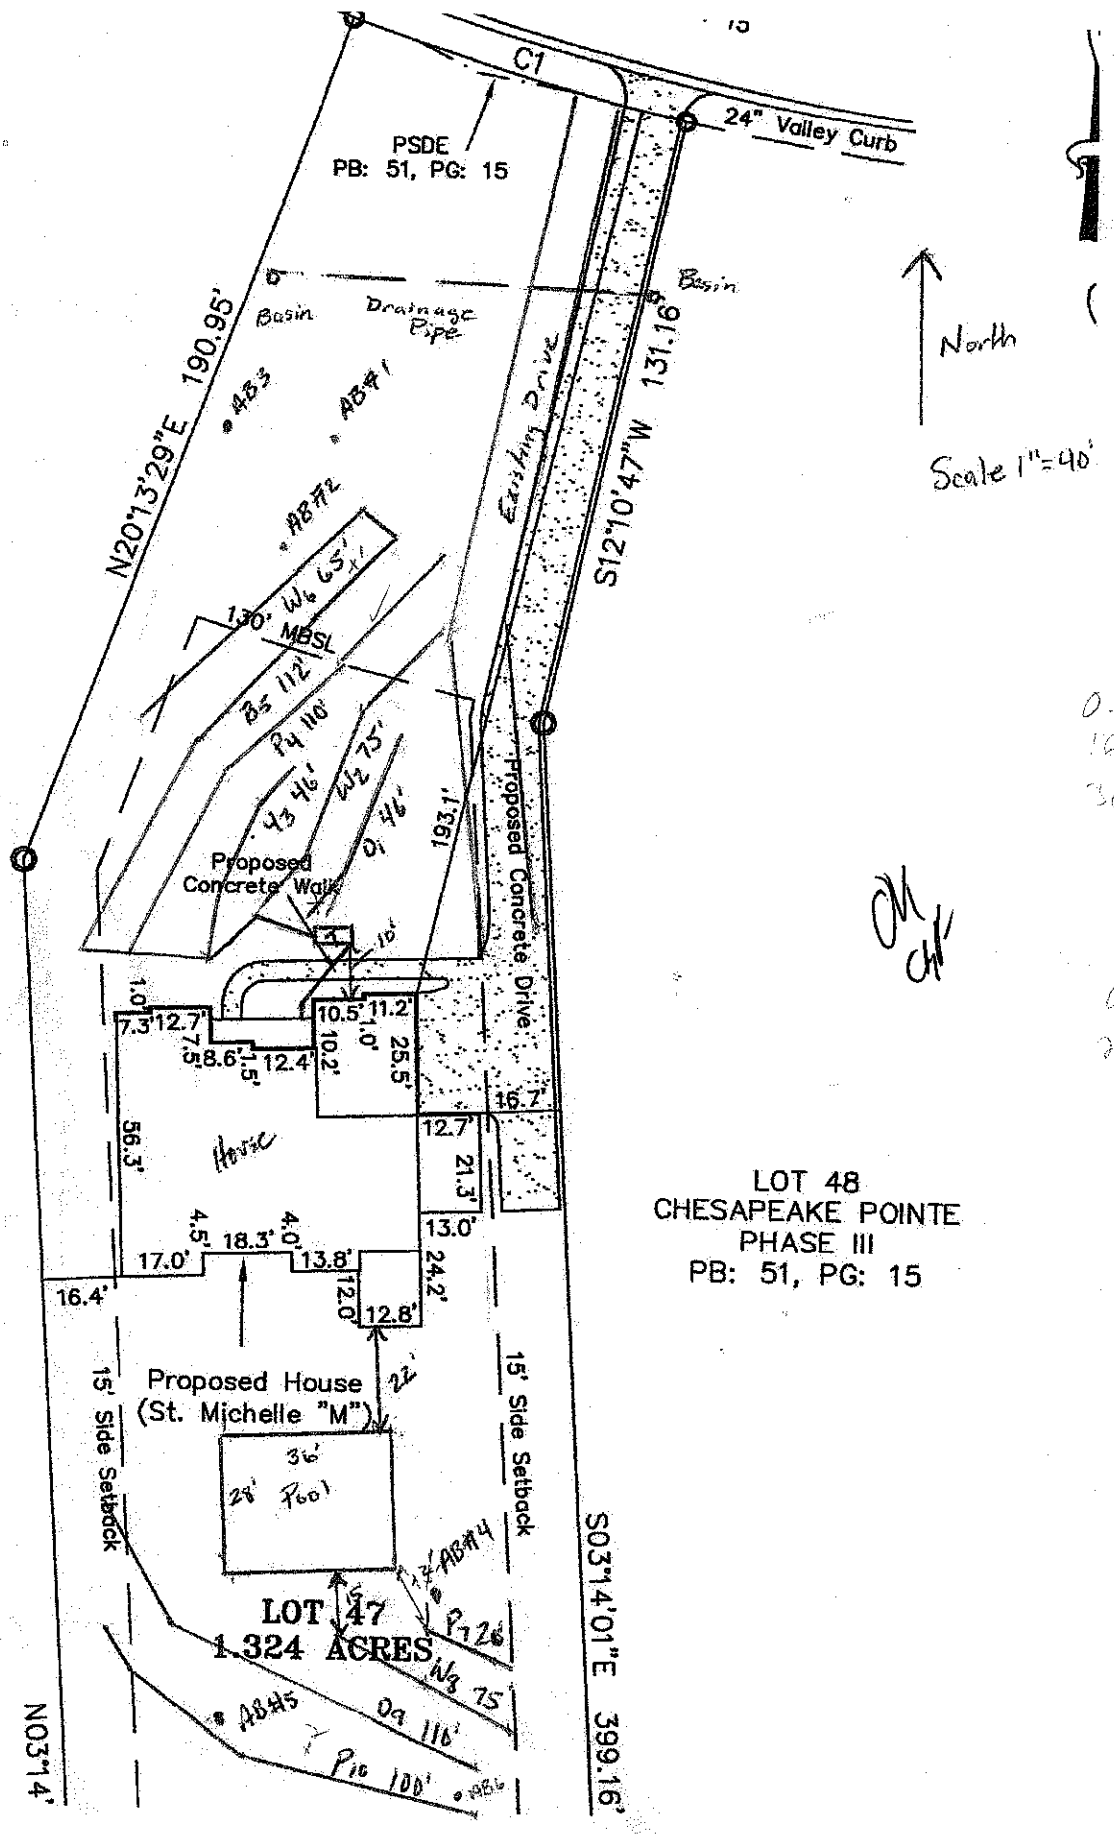
AUTHORIZATION TO CONSTRUCT by: APPROVED MAY 22 2015 Date:

Installed by: ABERNATHY

OPERATION PERMIT by: Date: 5-22-15

Existing System Inspected by: Date:

Health Dept. Copy - WHITE Applicant (Final Approval) - YELLOW Applicant (Conditional Approval) - PINK


C1
24" Valley Curb
PSDE
PB: 51, PG: 15
Basin
Drainage Pipe
Basin
North
Scale 1"=40'
N20°13'29"E 190.95'
S12°10'47"W 131.16'
Existing Drive
Proposed Concrete Drive
Proposed Concrete Walk
Proposed House
(St. Michelle "M")
LOT 47
1.324 ACRES
LOT 48
CHESAPEAKE POINTE
PHASE III
PB: 51, PG: 15
15' Side Setback
15' Side Setback
N03°14'
S03°14'01"E 399.16'
Horse
AB#1
AB#2
AB#3
AB#4
AB#5
MBSL