IREDELL COUNTY HEALTH DEPARTMENT

STATESVILLE 704-878-5300 MOORESVILLE 704-664-5281

IMPROVEMENT PERMIT / AUTHORIZATION TO CONSTRUCT / OPERATION PERMIT / EXISTING SYSTEM INSPECTION

2,000 Sq. ft Ken Foster

PERMIT# 133887 PIN# 4636022509 / 4636-07-2611 DATE 2-6-07

OWNER OR APPLICANT Chesapeake Point LLC PHONE: Business (678) 300-8521 Home

ADDRESS 7380 McGinnis Ferry Rd Suwanee GA (Easement)

LOCATION Brawley School Rd TL Isle of Pines TR Cove Creek TL Charthouse

SUBDIVISION Chesapeake Pt BLOCK / SECTION II LOT 36 LOT AREA 6.85 Acre SITE CLASS. PS DESIGN FLOW 700gpd L.T.A.R. .3

Septic Tank: 1500 Gallons: STB 338 Date 8-23-08

Pump Tank: 1500 Gallons: PT 477 Date 9-9-08

Pump Make: Myers Model ME10052 Serial No 2532D02

Nitrification Field: No Fields 1 Square Feet 800 Linear Feet 600

No Lines 5 or 20 Trench Width 36" Max Trench Bottom Depth 36" Gravel Depth N/A

☒ New System ☐ Repair ☐ Expansion System Type: I II III IV V VI

System Description: Pump-PM-25% Reduction

Repair System Description: LP-Panel Blk

Maintenance Agreement Required: ☐ Yes ☒ No

☐ House/Mod. Home ☐ Mobile Home ☐ Business ☒ Other Community Amenity Site

No. Bedrooms ___ No. Persons ___ No. Employees ___

Water Supply: ☐ Individual ☐ Public ☒ Community


☐ Gravity ☒ Pressure ☐ Slab ☐ Crawl Space ☐ Basement w/plumbing ☐ Basement wo/plumbing

Comments/Conditions: * Design Flow based on maximum number of lots = 77. Therefore can only be used by Chesapeake Pt Community & not any other Subdivision.

Comments/Conditions: 10/29/08 Checked tanks ran 2" supply line buried >30" & sleeved 11/24/08 Checked EZ-Flow lines.


INITIAL SITE SKETCH

Scale=

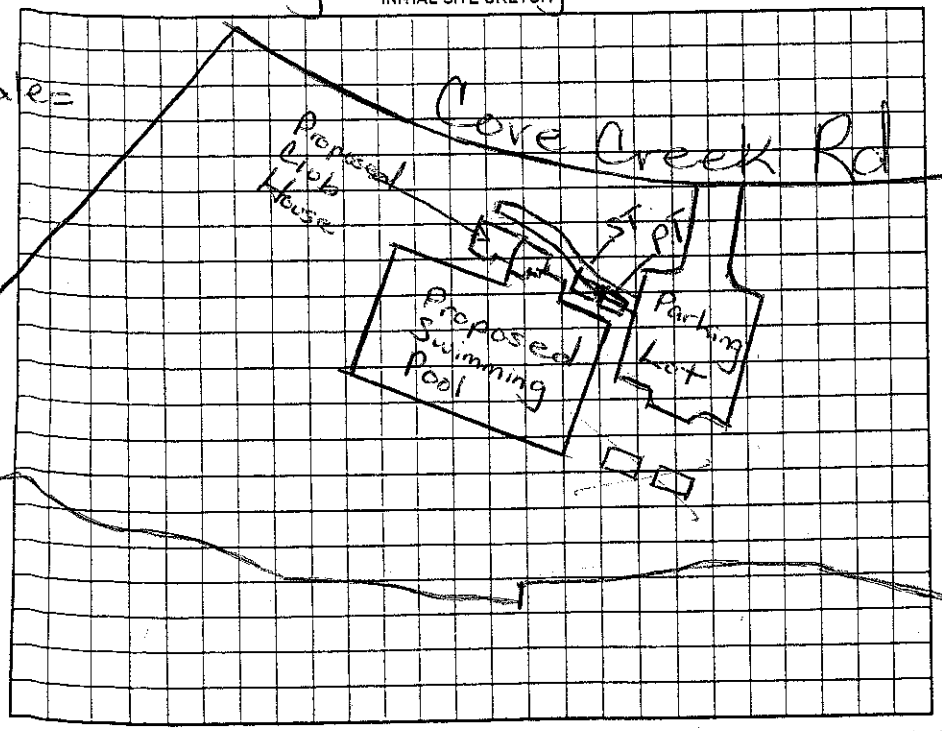

AS BUILT SKETCH Scale 1:50

10/12/09 2ff pressure set

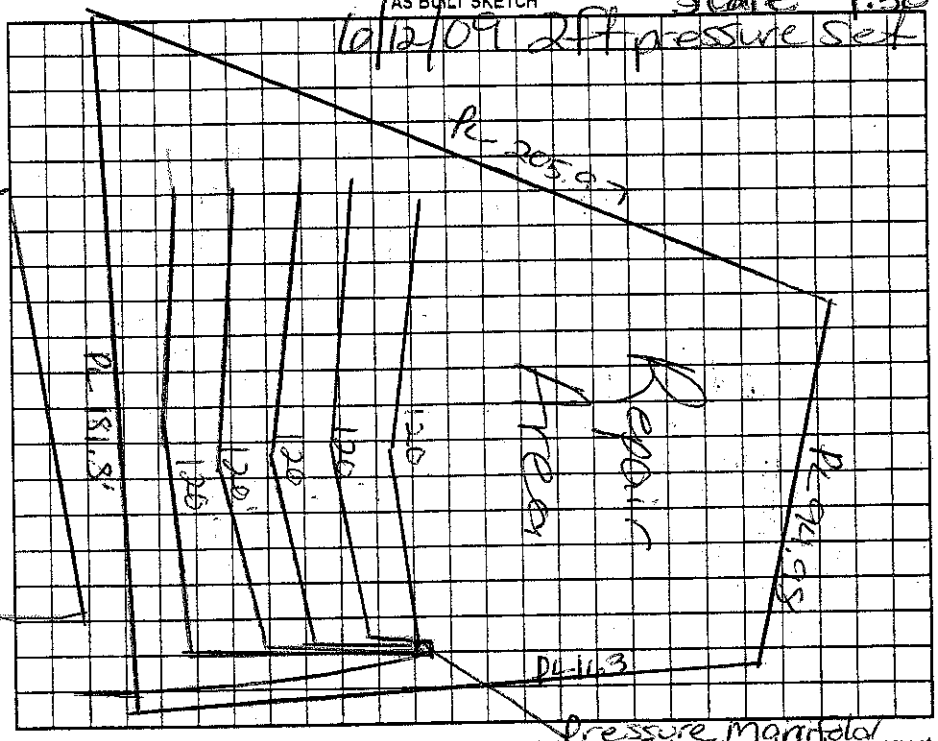

Permit can be suspended or revoked if any false information is supplied toward securing the permit/any unauthorized changes are made to the site/any unauthorized changes are made in the installation of the system. Improvement Permit with plat valid without expiration ☐ Improvement Permit with site plan valid for sixty months ☐ Authorization to Construct is valid for a period equal to that of Improvement Permit – not to exceed sixty months.

Issued by: [signature] date 2-19-07 Installed by: Willie Christen DUSY

Permit by: Marina Hall Dotson RS date 2/8/07 Operation Permit by: Marina Hall Dotson RS date 10/12/09

by: Judy McNeill date 5/22/08 Existing System Inspection by: ___ date ___

HEALTH DEPT. COPY: WHITE OWNER COPY (FINAL): YELLOW OWNER COPY (INITIAL): PINK