This permit replaces previously Permit issued 10-25-06 BP

IREDELL COUNTY HEALTH DEPARTMENT

Statesville Office (704) 878-5305 Mooresville Office (704) 660-3625 PERMIT # 137628

IMPROVEMENT PERMIT / AUTHORIZATION TO CONSTRUCT / OPERATION PERMIT / EXISTING SYSTEM

PIN # 4136025460

APPLICANT: StME Inc. APPLICANT ADDRESS: 105 D Denver Business Park

SITE ADDRESS: Cove Creek Rd. PHONE: 704-662-8625 ALT. PHONE: N/A

SITE DIRECTIONS: BSR TL Isle of Pines Rd. TR Cove Creek Rd.

SUBDIVISION: Chesapeake Pointe SECTION: II LOT # 80 LOT AREA: .69 acres DESIGN FLOW: 480gpd L.T.A.R.: 0.3

Septic Tank 1000 (gal) STB 794 Date 1-8-14
Pump Tank 1000 (gal) PT 27 Date 1-22-14
Pump Make Myers Model ME45 Serial #
Nitrification Fields 1 # Lines 3 Linear Ft: 270
Trench Width 24" Max. Trench Bottom Depth 48" Gravel Depth N/A

☑ New System ☐ Repair ☐ Expansion System Type: I II III ☑ IV V VI
System Description: Low Pressure PPBPS
Repair System Description: Low Pressure PPBPS
Maintenance Agreement Required: ☑ YES ☐ NO
☐ GRAVITY ☑ PRESSURE

☑ Residence No. Bedrooms 4
☐ Business No. Persons 8
☐ Other No. Employees
☐ Slab ☑ Crawl Space
☐ Basement w/plumbing ☐ Basement w/o plumbing

Water Supply: ☐ Private ☐ Public ☑ Community

Comments / Conditions:

INITIAL SITE SKETCH

See attached design by StME

AS BUILT SKETCH

Installed as drawn

Permit can be suspended or revoked if any false information is supplied toward securing the permit / any unauthorized changes are made to the site / any unauthorized changes are made in the installation of the system. **CONTACT A LOCATOR SERVICE PRIOR TO ANY EXCAVATION**

☐ **IMPROVEMENT PERMIT** *with plat valid without expiration.* ☑ **IMPROVEMENT PERMIT** *with site plan valid for 60 mos.* ☑ **AUTHORIZATION TO CONSTRUCT** *valid for period equal to IMPROVEMENT PERMIT--not to exceed 60 mo.*

Owner / Applicant Signature: Date: Installed by: Willie Christenbury

IMPROVEMENT PERMIT by: Justin Henderson Date: 3-20-14 OPERATION PERMIT by: Justin Henderson Date: 3-20-14

AUTHORIZATION TO CONSTRUCT by: Justin Henderson Date: 3-20-14 Existing System Inspected by: Date:

Health Dept. Copy - WHITE Applicant (Final Approval) - YELLOW Applicant (Conditional Approval) - PINK

IREDELL COUNTY HEALTH DEPARTMENT

STATESVILLE 704-878-5305 MOORESVILLE 704-664-5281

IMPROVEMENT PERMIT / AUTHORIZATION TO CONSTRUCT / OPERATION PERMIT / EXISTING SYSTEM INSPECTION

PERMIT# 137628 PIN# 4636025460 DATE October 25, 2006

OWNER OR APPLICANT Chesapeake Pointe LLC / Orleans Homes PHONE: Business 678-300-8521 Home

ADDRESS 1380 McGinnis Ferry Rd, Suwanee, Ga. 30024

LOCATION BSR N. Side of Pinecrest Cove Creek Rd. on left

SUBDIVISION Chesapeake Pointe BLOCK / SECTION 2 LOT 80 LOT AREA .69 Ac SITE CLASS. PS DESIGN FLOW 460gpd L.T.A.R. .3

Septic Tank: 1000 Gallons; STB 7464 Date 1-8-14

Pump Tank: 1000 Gallons; PT 27 Date 1-22-14

Pump Make: Myers mes Model ME545 Serial No.

Nitrification Field: No Fields 1 Square Feet 540 Linear Feet 270

No Lines 3 Trench Width 24" Max Trench Bottom Depth 36"

☒ New System ☐ Repair ☐ Expansion System Type: I II III IV V VI

System Description: LP PPBPS

Repair System Description: LP PPBPS

Maintenance Agreement Required: ☒ Yes ☐ No

☒ House/Mod. Home No. Bedrooms 4

☐ Mobile Home No. Persons

☐ Business No. Employees

☐ Other

Water Supply: ☐ Individual ☒ Public ☒ Community

Gravel Depth N/A ☐ Gravity ☒ Pressure ☐ Slab ☒ Crawl Space ☐ Basement w/plumbing ☐ Basement wo/plumbing

Comments:/Conditions:

Shave off any old berms in septic system area.

10/7/13 Reviewed Floor plans in compliance with original Septic plan

Comments:/Conditions: 3/5/14 Checked tanks MS

Note: PT on side of House, ST behind house

INITIAL SITE SKETCH


SEE Plan from S&ME

House

ST

PT

AS BUILT SKETCH

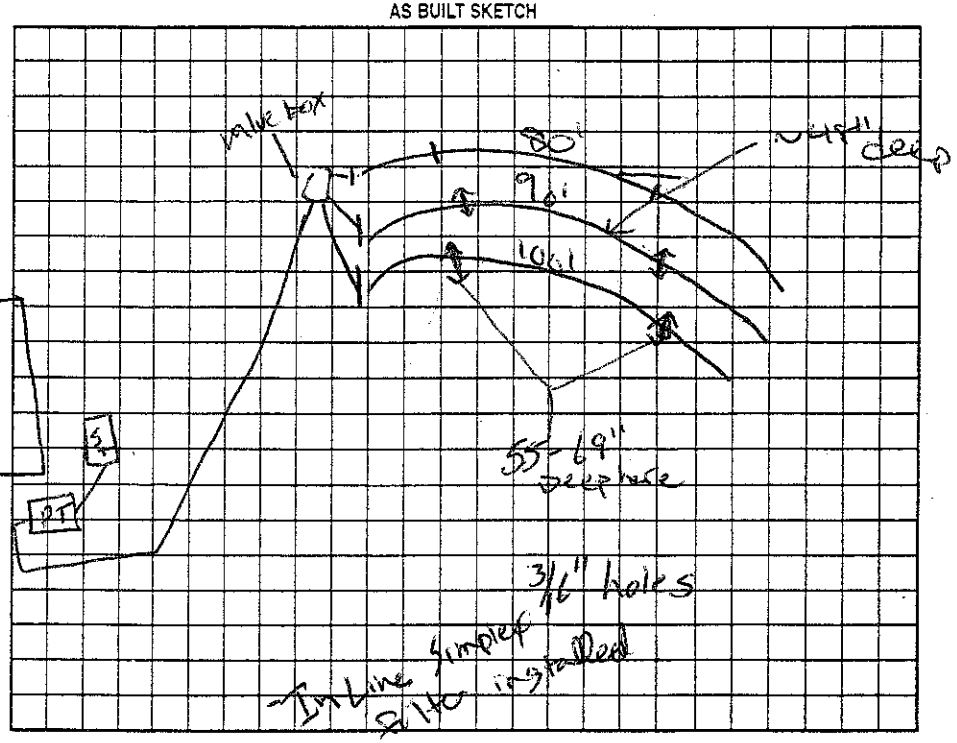

Permit can be suspended or revoked if any false information is supplied toward securing the permit/any unauthorized changes are made to the site/any unauthorized changes are made in the installation of the system. Improvement Permit with plat valid without expiration ☐ Improvement Permit with site plan valid for sixty months ☒ Authorization to Construct is valid for a period equal to that of Improvement Permit – not to exceed sixty months.

Signed: date 12-12-06 Installed by:

Improvement Permit by: date 10-25-06 Operation Permit by: date

Authorization to Construct by: BS date 10/7/13 Existing System Inspection by: date

HEALTH DEPT. COPY: WHITE OWNER COPY (FINAL): YELLOW OWNER COPY (INITIAL): PINK