252 Cove Creek Lp.

10130

IREDELL COUNTY HEALTH DEPARTMENT

STATESVILLE 704-878-5305 MOORESVILLE 704-664-5281

IMPROVEMENT PERMIT / AUTHORIZATION TO CONSTRUCT / OPERATION PERMIT / EXISTING SYSTEM INSPECTION

PERMIT# ~~B0072~~ 20539 PIN# ~~4636 12 0237.067~~ 4636-02-6091.000 DATE Feb 15, 2007

OWNER OR APPLICANT Chesapeake Pointe LLC / Mark Benitez PHONE: Business _____ Home _____

ADDRESS 7380 McInnis Ferry Rd. / Suwanee, Ga 30024

LOCATION Brawley Sch Rd. TL side of Pines TR Cove Creek Rd. on left at jct w/ Chanthorne

SUBDIVISION Chesapeake Pointe BLOCK / SECTION 3 LOT 67/67A LOT AREA .69Ac+ .43Ac SITE CLASS. PS SFE DESIGN FLOW 480gpd L.T.A.R. .3 SFE

Septic Tank: 1000 Gallons: ST# 194 Date 5-5-15

Pump Tank: 1000 Gallons: PT 283 Date 5-18-15

Pump Make: Goulds Model WE0512H Serial No LEL3E15

Nitrification Field: No Fields 1 Square Feet 1206 Linear Feet 402

No Lines 3 Trench Width 36" Max Trench Bottom Depth 36"

☒ New System ☐ Repair ☐ Expansion System Type: I II (III) IV V VI

System Description: pm 25% Reduction

Repair System Description: SAME OR LP 25% Red.

Maintenance Agreement Required: ☐ Yes ☒ No

☒ House/Mod. Home ☐ Mobile Home ☐ Business ☐ Other

No. Bedrooms 4 No. Persons ___ No. Employees ___

Water Supply: ☐ Individual ☒ Public ☒ Community

Gravel Depth NA ☐ Gravity ☒ Pressure ☐ Slab ☒ Crawl Space ☐ Basement w/plumbing ☐ Basement wo/plumbing

Comments:/Conditions:

Show if any old barns in septic system area.

Comments:/Conditions: 6/26/15 Checked tanks & lines Installed essentially as drawn See revised tank location on plan

INITIAL SITE SKETCH

SEE PLAN from J & ME

AS BUILT SKETCH

	Date	Initials
Drain Lines Checked	6/26/15	MD
Tanks Checked	6/26/15	MD
Pressure Manifold or Valve Box Checked	7/15/15	SL
Pressure Head Set	7/15/15	SL
Electrical Checked	7/15/15	SL
Floats Set	7/15/15	SL
Alarm Checked	7/15/15	SL
Maintenance Contract Y / (N)		

Permit can be suspended or revoked if any false information is supplied toward securing the permit/any unauthorized changes are made to the site/any unauthorized changes are made in the installation of the system. Improvement Permit with plat valid without expiration ☐ Improvement Permit with site plan valid for sixty months ☒ Authorization to Construct is valid for a period equal to that of Improvement Permit – not to exceed sixty months.


Signed: Karen D. Wallace date 7-27-07 Installed by: Richard Abernathy

Improvement Permit by: _____ date 2-15-07 Operation Permit by: _____ date 7/15/15


Authorization to Construct by: _____ date _____ Existing System Inspection by: _____ date _____

APPROVED OCT 22 2014

HEALTH DEPT. COPY: WHITE OWNER COPY (FINAL): YELLOW OWNER COPY (INITIAL): PINK

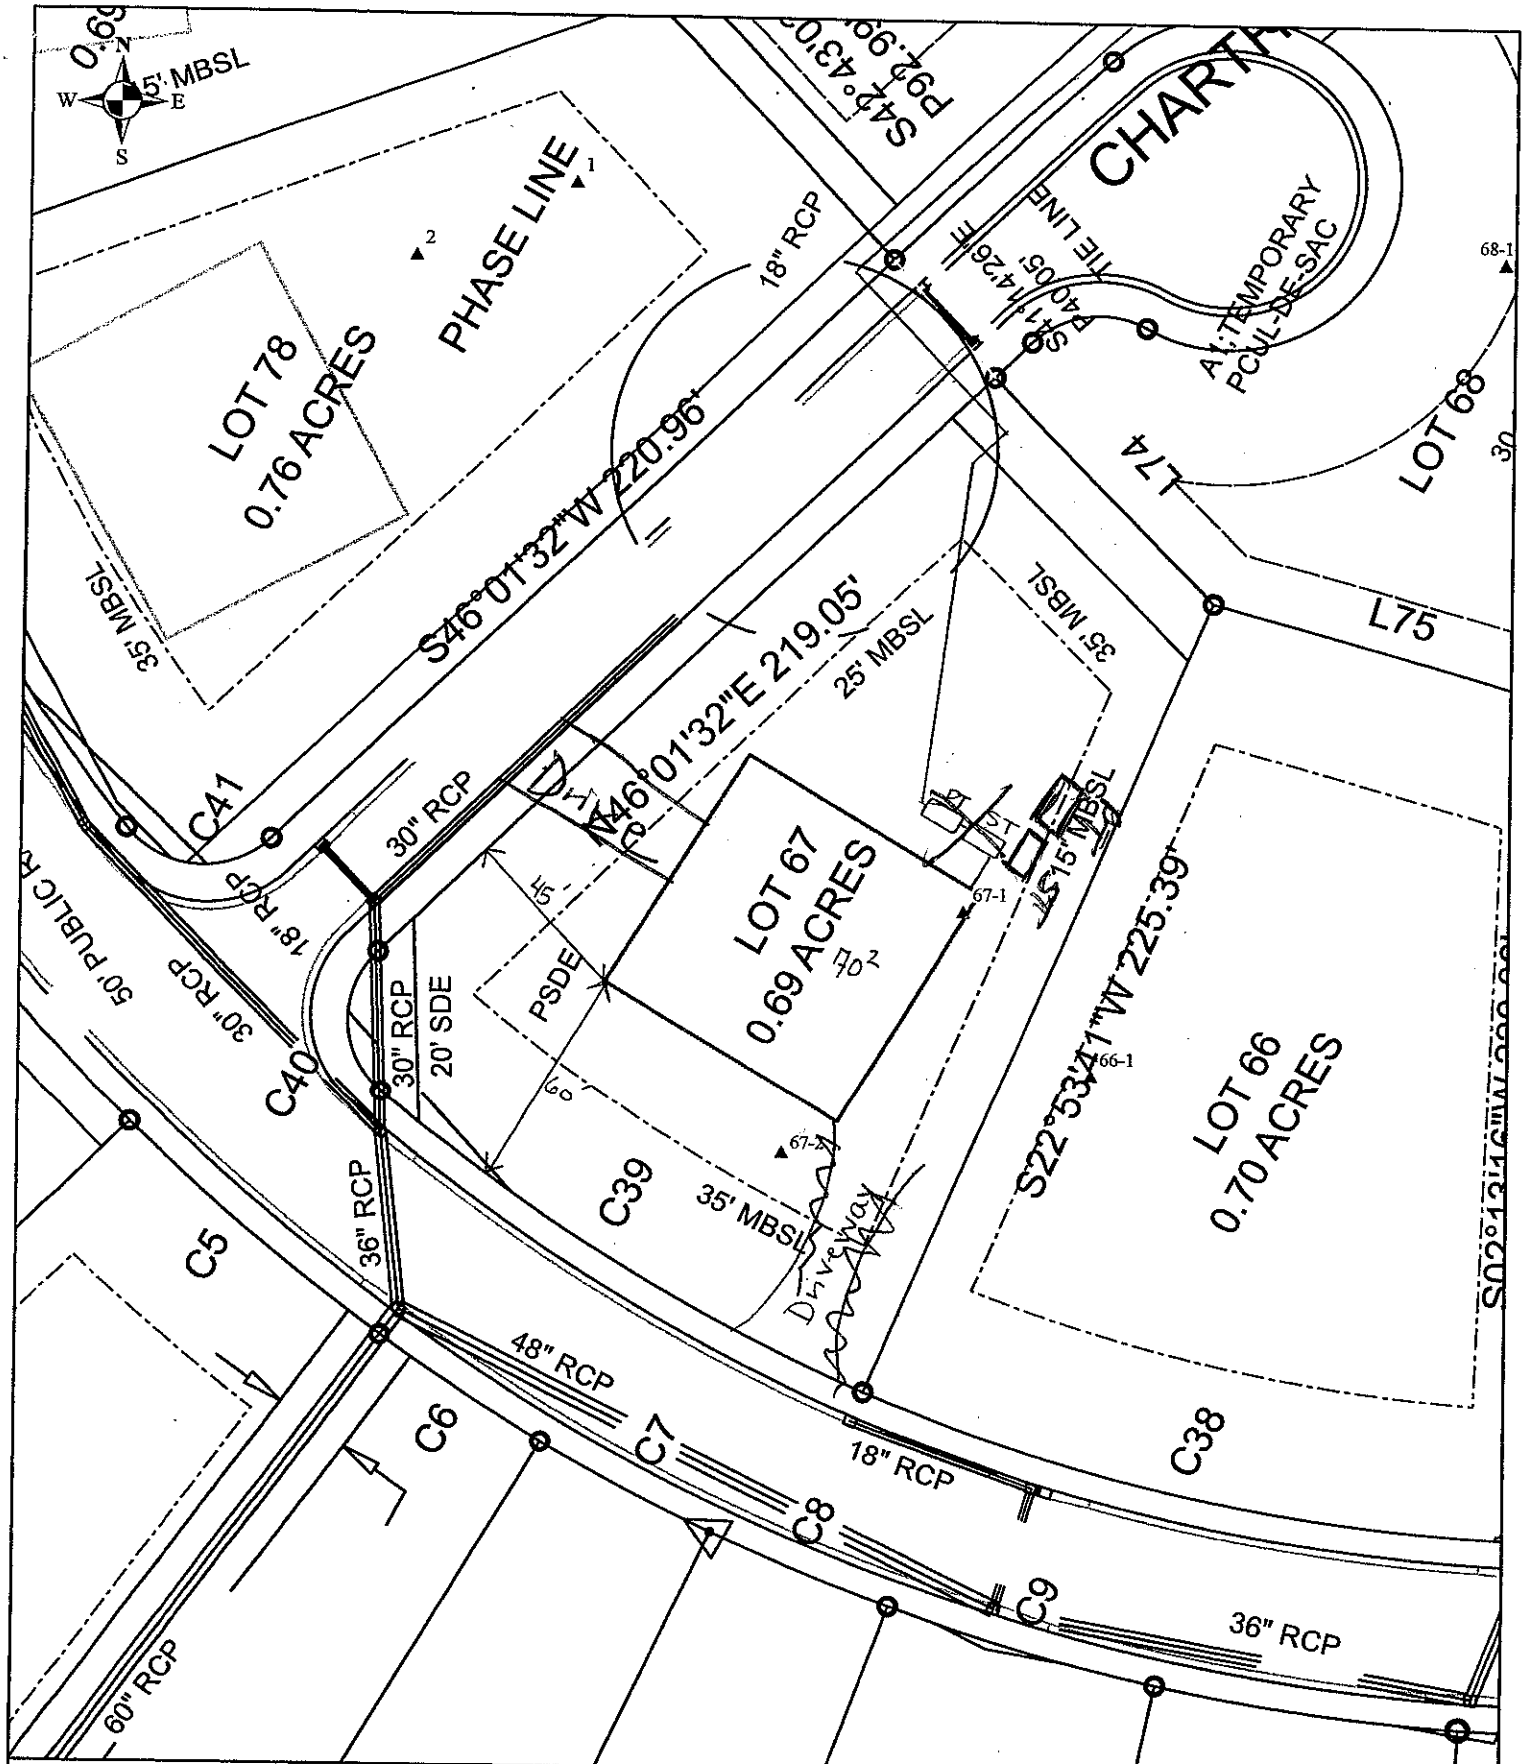

Scale: 1 inch equals 50 feet	S&ME	Lot 67 Chesapeke Point	FIGURE
Drawn by: JBP	ENVIRONMENTAL SERVICES • ENGINEERING • TESTING	Detailed, Scaled Site Plan	1
Reviewed by: KS		Iredell County, NC	
Date: December, 2006		S&ME Project #1588-04-011	

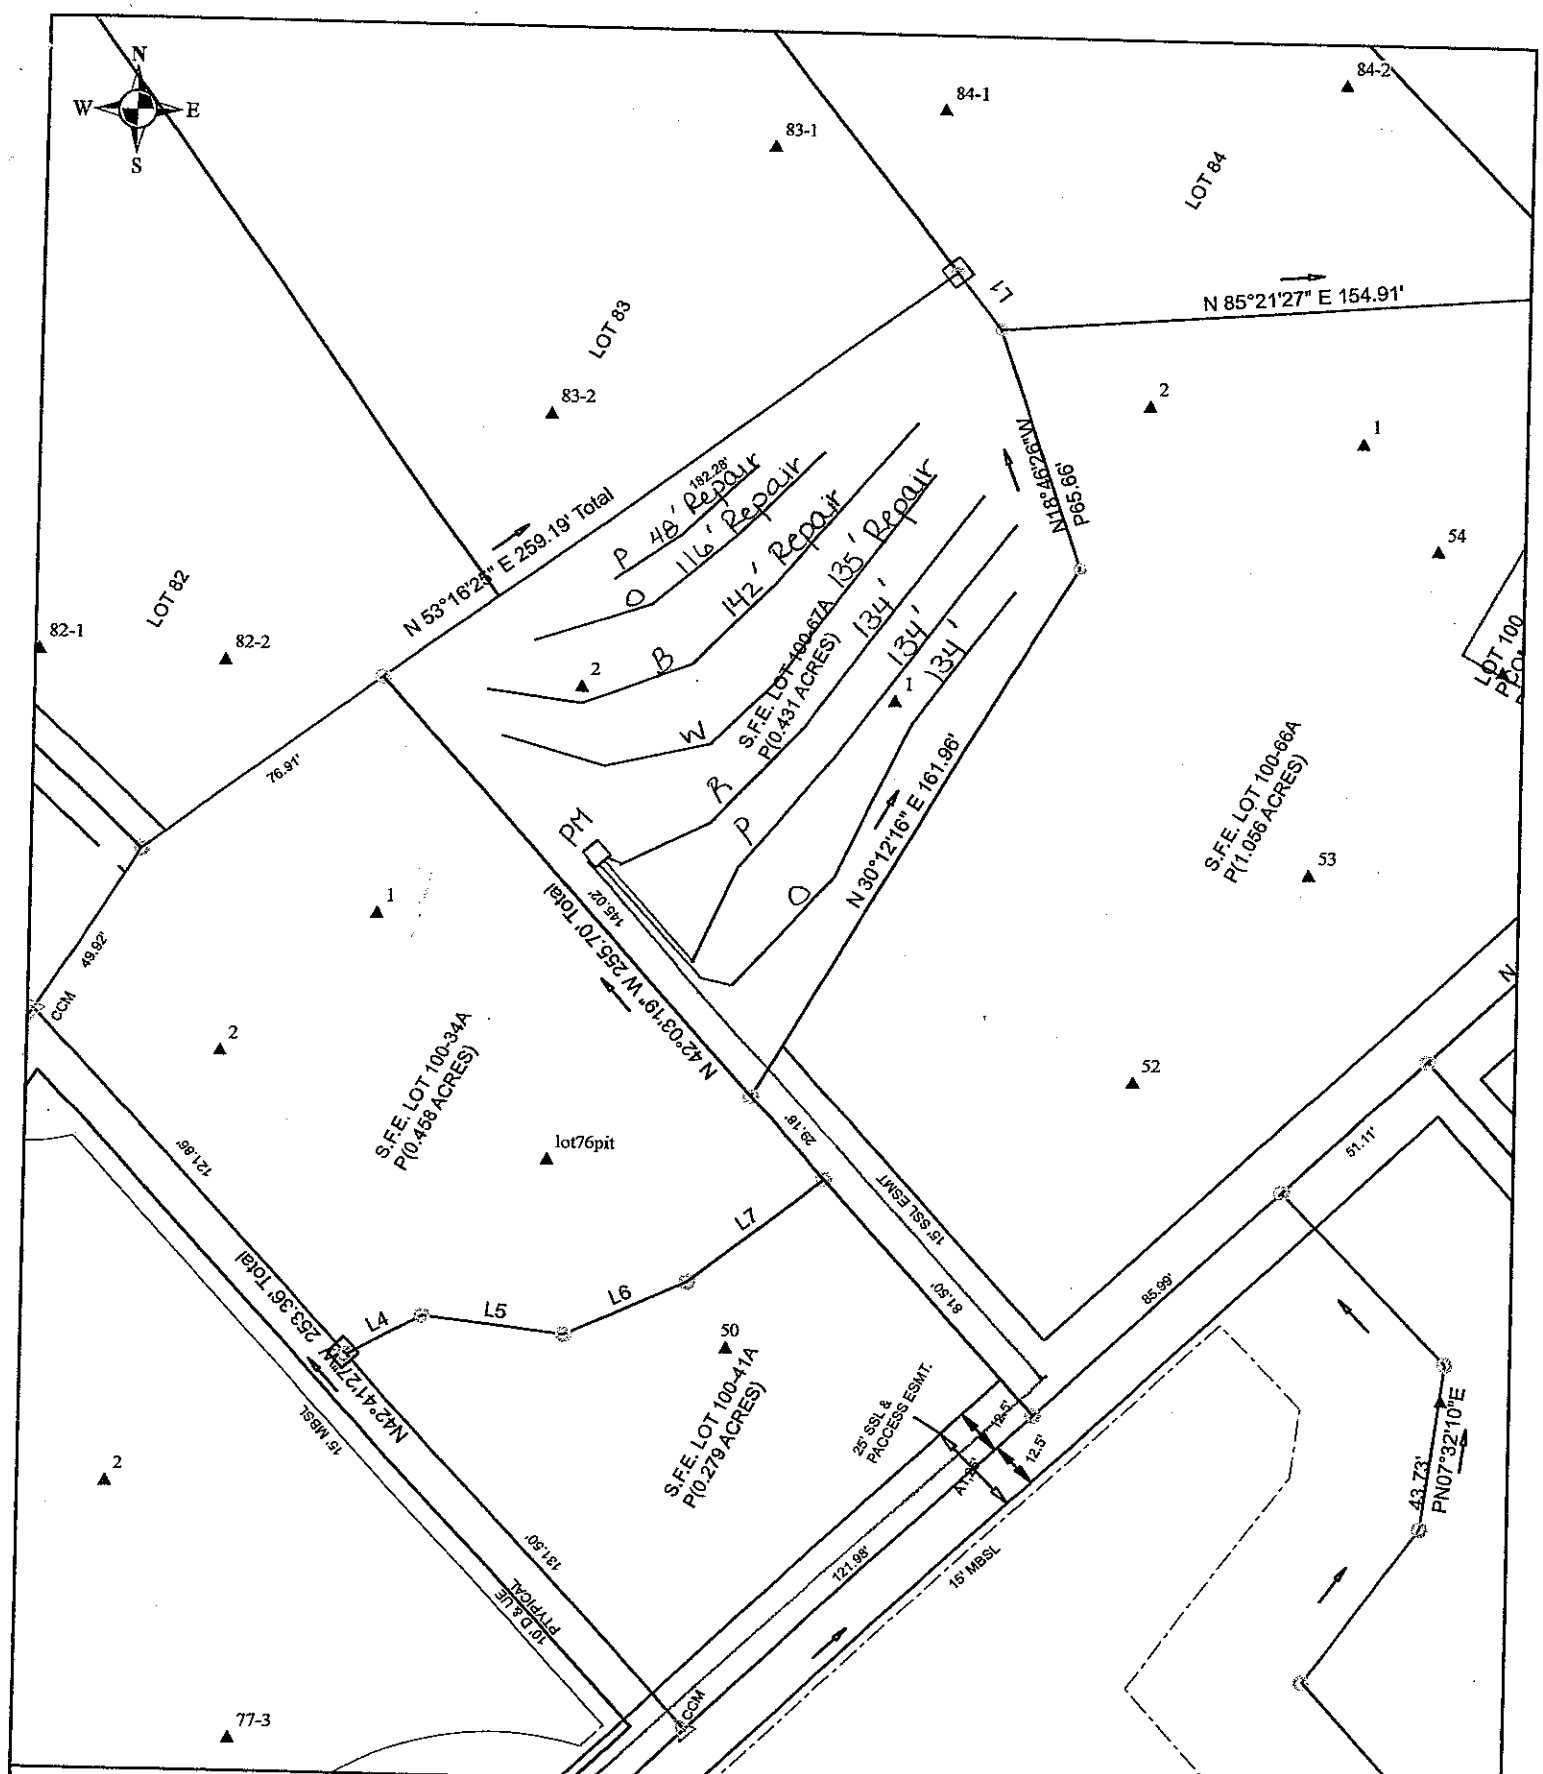

Scale: 1 inch equals 50 feet	S&ME	S.F.E Lot 100-67A Chesapeke Point	FIGURE
Drawn by: JBP		Detailed, Scaled Site Plan	1
Reviewed by: KS		Iredell County, NC	
Date: December, 2006	ENVIRONMENTAL SERVICES • ENGINEERING • TESTING	S&ME Project #1588-04-011	