IREDELL COUNTY HEALTH DEPARTMENT

Statesville Office (704) 878-5305 Mooresville Office (704) 660-3625 PERMIT # 212295

IMPROVEMENT PERMIT / AUTHORIZATION TO CONSTRUCT / OPERATION PERMIT / EXISTING SYSTEM

PIN # 4636-02-6381

APPLICANT: CP II LLC APPLICANT ADDRESS: 3125 PRESIDENTIAL PKWY, ATLANTA GA

SITE ADDRESS: 115 CHART HOUSE LN; MRSVL PHONE: ALT. PHONE:

SITE DIRECTIONS: ISLE OF PINES, TR COVE CREEK, TL CHART HOUSE

SUBDIVISION: CHESAPEAKE POINT SECTION: 4 LOT # 105 LOT AREA: .699 AC DESIGN FLOW: 480 L.T.A.R.: .5

Septic Tank 1000 (gal) STB 799 Date 3-14-16
Pump Tank 1000 (gal) PT 283 Date 5-1-16
Pump Make Liberty Model 280 Serial #
Nitrification Fields 4 # Lines 5 Linear Ft: 400'
Trench Width 36" Max. Trench Bottom Depth 24-36" Gravel Depth —

☒ New System ☐ Repair ☐ Expansion System Type: I II III IV V VI
System Description: PM 25% RED.
Repair System Description: PANEL BLOCK
Maintenance Agreement Required: ☐ YES ☒ NO
☐ GRAVITY ☒ PRESSURE

☒ Residence No. Bedrooms 4
☐ Business No. Persons 8
☐ Other No. Employees
☒ Slab ☒ Crawl Space
☐ Basement w/plumbing ☐ Basement w/o plumbing

Water Supply: ☐ Private ☐ Public ☒ Community

Comments / Conditions:


6-15-16 lines & tanks Checked by TS
7/19/16 PM set pressure, elect & alarm by MD
7/22/16 set pressure,

INITIAL SITE SKETCH

SEE PLAN FROM MICHAEL ATHANAS & ASSOCIATES

APPROVED AUG 21 2015

AS BUILT SKETCH

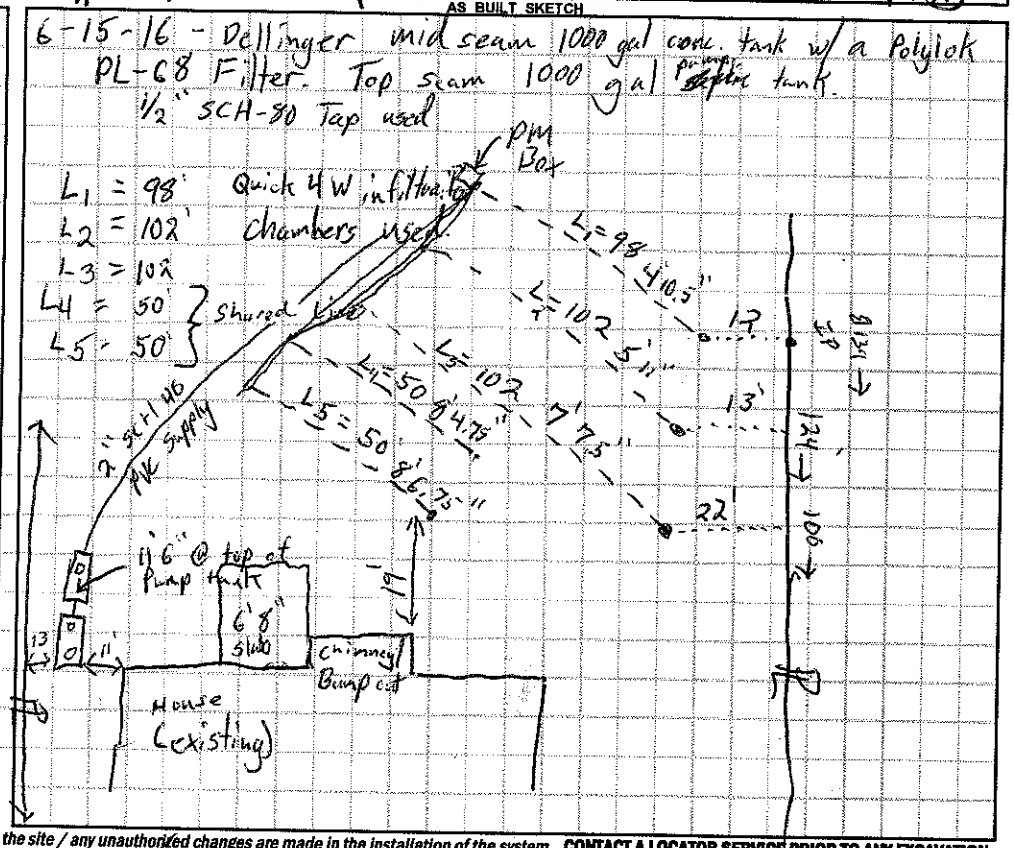

Permit can be suspended or revoked if any false information is supplied toward securing the permit / any unauthorized changes are made to the site / any unauthorized changes are made in the installation of the system. CONTACT A LOCATOR SERVICE PRIOR TO ANY EXCAVATION


☐ IMPROVEMENT PERMIT *with plat* valid without expiration. ☒ IMPROVEMENT PERMIT *with site plan* valid for 60 mos. ☒ AUTHORIZATION TO CONSTRUCT valid for period equal to IMPROVEMENT PERMIT--not to exceed 60 mo.

Owner / Applicant Signature: Date: 9/17/15 Installed by: Abernathy

IMPROVEMENT PERMIT by: APPROVED AUG 21 2015 OPERATION PERMIT by: Date: 7/22/16

AUTHORIZATION TO CONSTRUCT by: APPROVED NOV 24 2015 Existing System Inspected by: Date:

Health Dept. Copy - WHITE Applicant (Final Approval) - YELLOW Applicant (Conditional Approval) - PINK

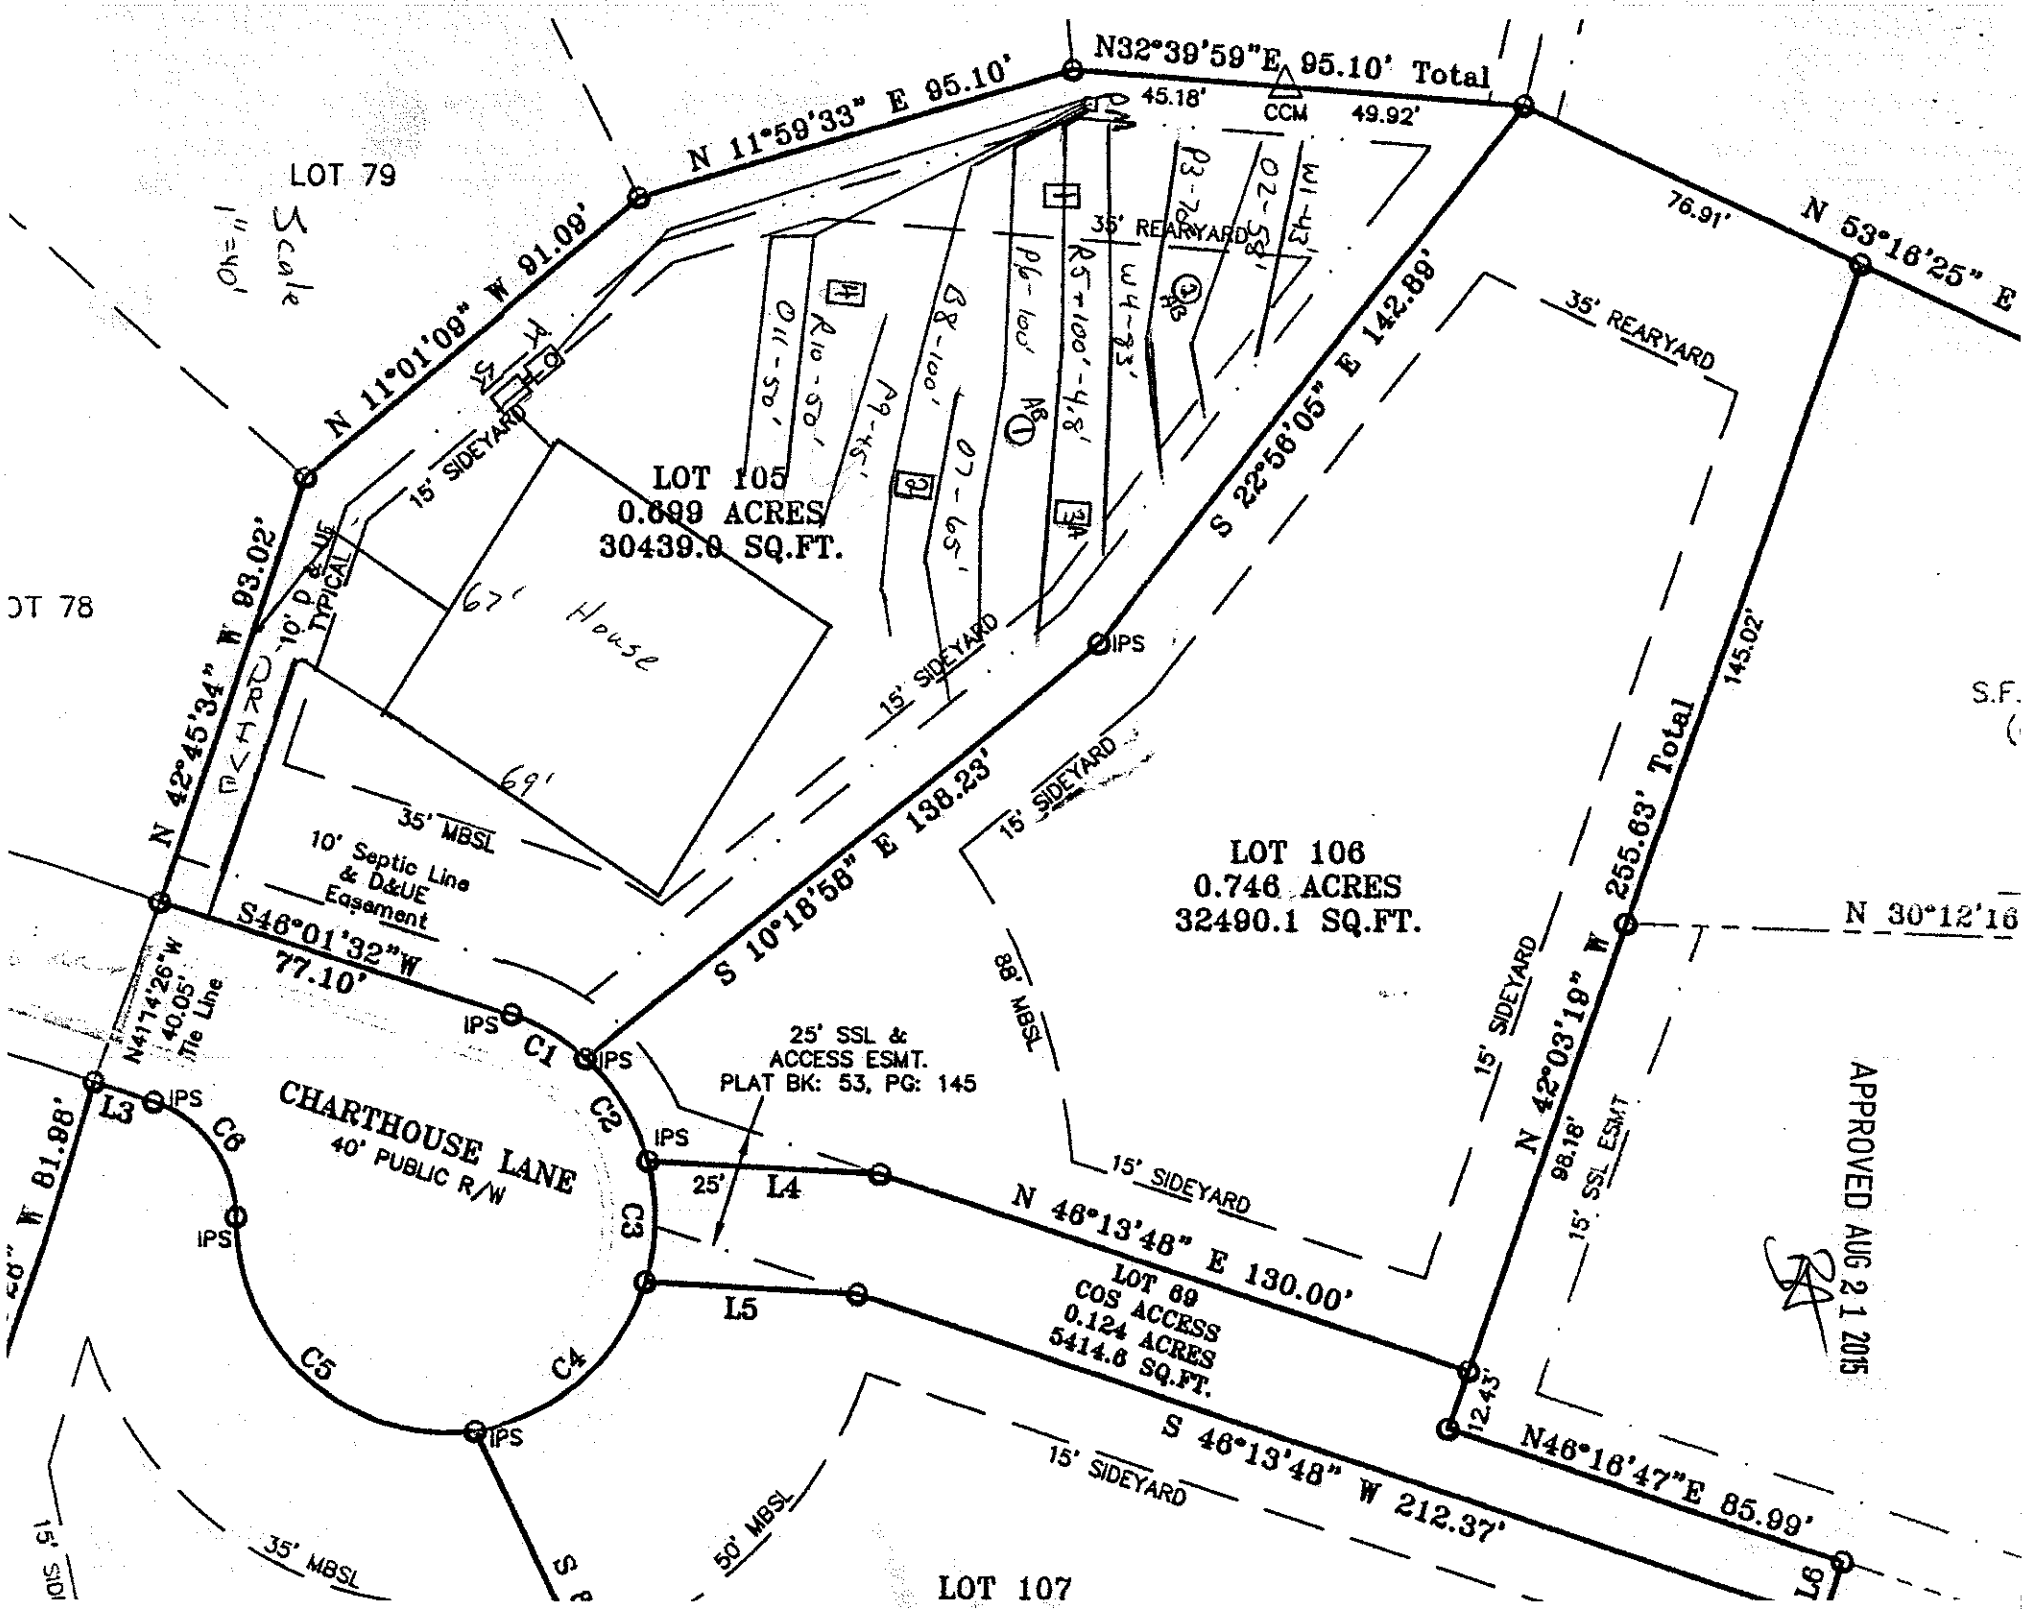
N32°39'59"E 95.10' Total
N 11°59'33" E 95.10'
N 11°01'09" W 91.09'
N 42°45'34" W 93.02'
S 22°56'05" E 142.89'
S 10°18'58" E 138.23'
N 53°16'25" E
76.91'
145.02'
255.63' Total
N 42°03'19" W
98.18'
N 46°13'48" E 130.00'
S 46°13'48" W 212.37'
N46°16'47"E 85.99'
12.43'
S46°01'32"W 77.10'
N41°14'26"W 40.05' Tie Line
81.98'
45.18'
CCM
49.92'
LOT 79
LOT 78
LOT 105
0.699 ACRES
30439.0 SQ.FT.
LOT 106
0.746 ACRES
32490.1 SQ.FT.
LOT 69
COS ACCESS
0.124 ACRES
5414.6 SQ.FT.
LOT 107
CHARTHOUSE LANE
40' PUBLIC R/W
25' SSL & ACCESS ESMT.
PLAT BK: 53, PG: 145
15' SSL ESMT
10' Septic Line & D&UE Easement
10' D & UE TYPICAL
35' REARYARD
15' SIDEYARD
35' MBSL
50' MBSL
88' MBSL
67' House
69'
IPS
C1
C2
C3
C4
C5
C6
L3
L4
L5
L9
N 30°12'16
APPROVED AUG 21 2015
Scale 1"=40'