IREDELL COUNTY HEALTH DEPARTMENT

STATESVILLE 704-878-5305 MOORESVILLE 704-664-5281

IMPROVEMENT PERMIT / AUTHORIZATION TO CONSTRUCT / OPERATION PERMIT / EXISTING SYSTEM INSPECTION

PERMIT# 13729 L 10977 PIN# 4636 02 6524 DATE October 25, 2006

OWNER OR APPLICANT Chesapeake Pointe LLC Orleans Hom PHONE: Business 678-300-8521 Home

ADDRESS 7360 McGinnis Ferry Rd. Suwanee, Ga. 30024

LOCATION BSR to Isle of Pines, TR Cove Creek Rd on left

SUBDIVISION Chesapeake Pointe BLOCK / SECTION LOT 81 LOT AREA .69Ac SITE CLASS. PS DESIGN FLOW 460gpd L.T.A.R. .3

Septic Tank: 1000 Gallons: STB 312 Date 6-11-12
Pump Tank: 1000 Gallons: PT 27 Date 6-19-12
Pump Make Hydromatic Model SHEF45 Serial No.
Nitrification Field: No Fields 1 Square Feet 540 Linear Feet 270
No Lines 3 Trench Width 24" Max Trench Bottom Depth 36"

☒ New System ☐ Repair ☐ Expansion System Type: I II III IV V VI
System Description: LP PPBPS
Repair System Description: LP PPBPS
Maintenance Agreement Required: ☒ Yes ☐ No

☒ House/Mod. Home No. Bedrooms 4
☐ Mobile Home No. Persons
☐ Business No. Employees
☐ Other

Water Supply: ☐ Individual ☒ Public ☒ Community

Gravel Depth NA ☐ Gravity ☒ Pressure ☐ Slab ☒ Crawl Space ☐ Basement w/plumbing ☐ Basement wo/plumbing


Comments/Conditions:
Shave off any old burms in septic system area.
Build House as Shown on Septic plan 2/27/12 Reviewed Floor plans

Comments/Conditions: 3/16" Hole

INITIAL SITE SKETCH

SEE Plan from SHME

AS BUILT SKETCH

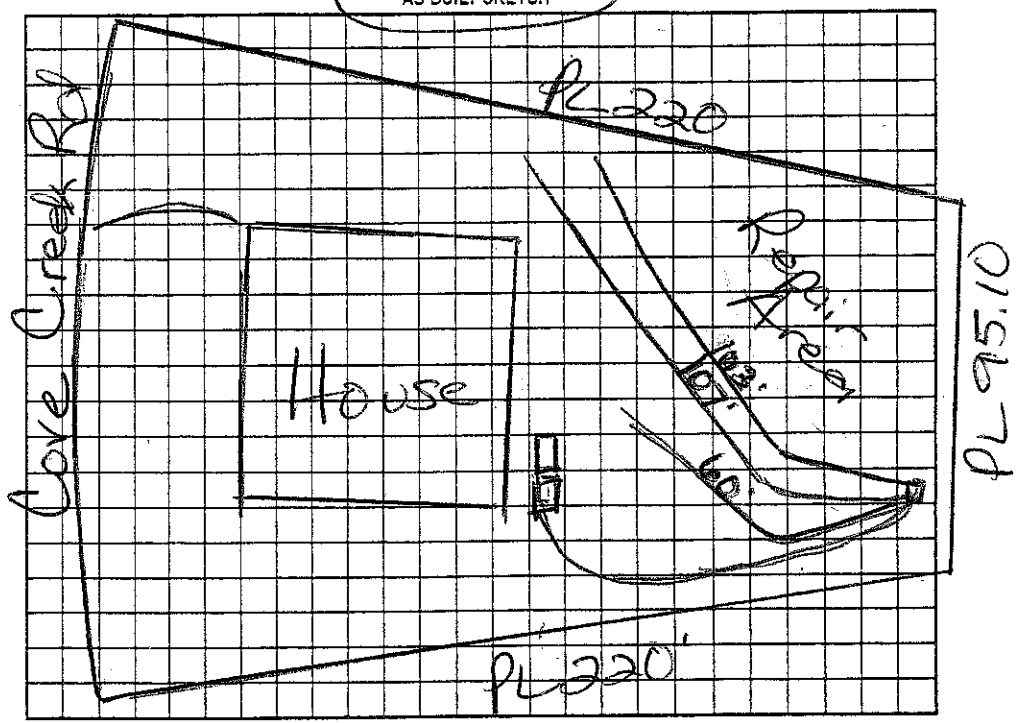

Permit can be suspended or revoked if any false information is supplied toward securing the permit/any unauthorized changes are made to the site/any unauthorized changes are made in the installation of the system. Improvement Permit with plat valid without expiration ☐ Improvement Permit with site plan valid for sixty months ☒ Authorization to Construct is valid for a period equal to that of Improvement Permit – not to exceed sixty months.

Signed: date 12-12-06 Installed by: Willie Christianbury

Improvement Permit by: date 10-25-06 Operation Permit by: date 9/5/12

Authorization to Construct by: date 4-16-07 Existing System Inspection by: date

HEALTH DEPT. COPY: WHITE OWNER COPY (FINAL): YELLOW OWNER COPY (INITIAL): PINK

Issued by 2/27/12