IREDELL COUNTY HEALTH DEPARTMENT

Statesville Office (704) 878-5305 Mooresville Office (704) 660-3625

MD 211179 PERMIT # Z11029

IMPROVEMENT PERMIT / AUTHORIZATION TO CONSTRUCT / OPERATION PERMIT / EXISTING SYSTEM

PIN # 4636-03-~~6127~~ 6261

APPLICANT: CP II LLC APPLICANT ADDRESS: 3125 Presidential Pkwy, Atlanta GA

SITE ADDRESS: 321 Cove Creek Loop, Mrsvl. PHONE: ALT. PHONE:

SITE DIRECTIONS: Isle of Pines, TR Cove Creek, on R

SUBDIVISION: Chesapeake Point SECTION: 2 LOT # 29 LOT AREA: 1.24AC DESIGN FLOW: 480 L.T.A.R.: .3

Septic Tank 1000 (gal) STB NPLTHATP Date

Pump Tank (gal) PT Date

Pump Make Model Serial #

Nitrification Fields 1 # Lines 5 Linear Ft: 400'

Trench Width 30" Max. Trench Bottom Depth * 30" * Gravel Depth —

☑ New System ☐ Repair ☐ Expansion System Type: I II (III) IV V VI

System Description: 25% Reduction

Repair System Description: Panel Block

Maintenance Agreement Required: ☐ YES ☑ NO

☑ GRAVITY ☐ PRESSURE

☑ Residence No. Bedrooms 4

☐ Business No. Persons

☐ Other No. Employees

☐ Slab ☑ Crawl Space

☐ Basement w/plumbing ☐ Basement w/o plumbing

Water Supply: ☐ Private ☐ Public ☑ Community

Comments / Conditions:

Checked Lines & Tank 2-22-16 BA
412' Installed

INITIAL SITE SKETCH

See Plan From Michael Athanas & Associates

AS BUILT SKETCH

Permit can be suspended or revoked if any false information is supplied toward securing the permit / any unauthorized changes are made to the site / any unauthorized changes are made in the installation of the system. **CONTACT A LOCATOR SERVICE PRIOR TO ANY EXCAVATION**

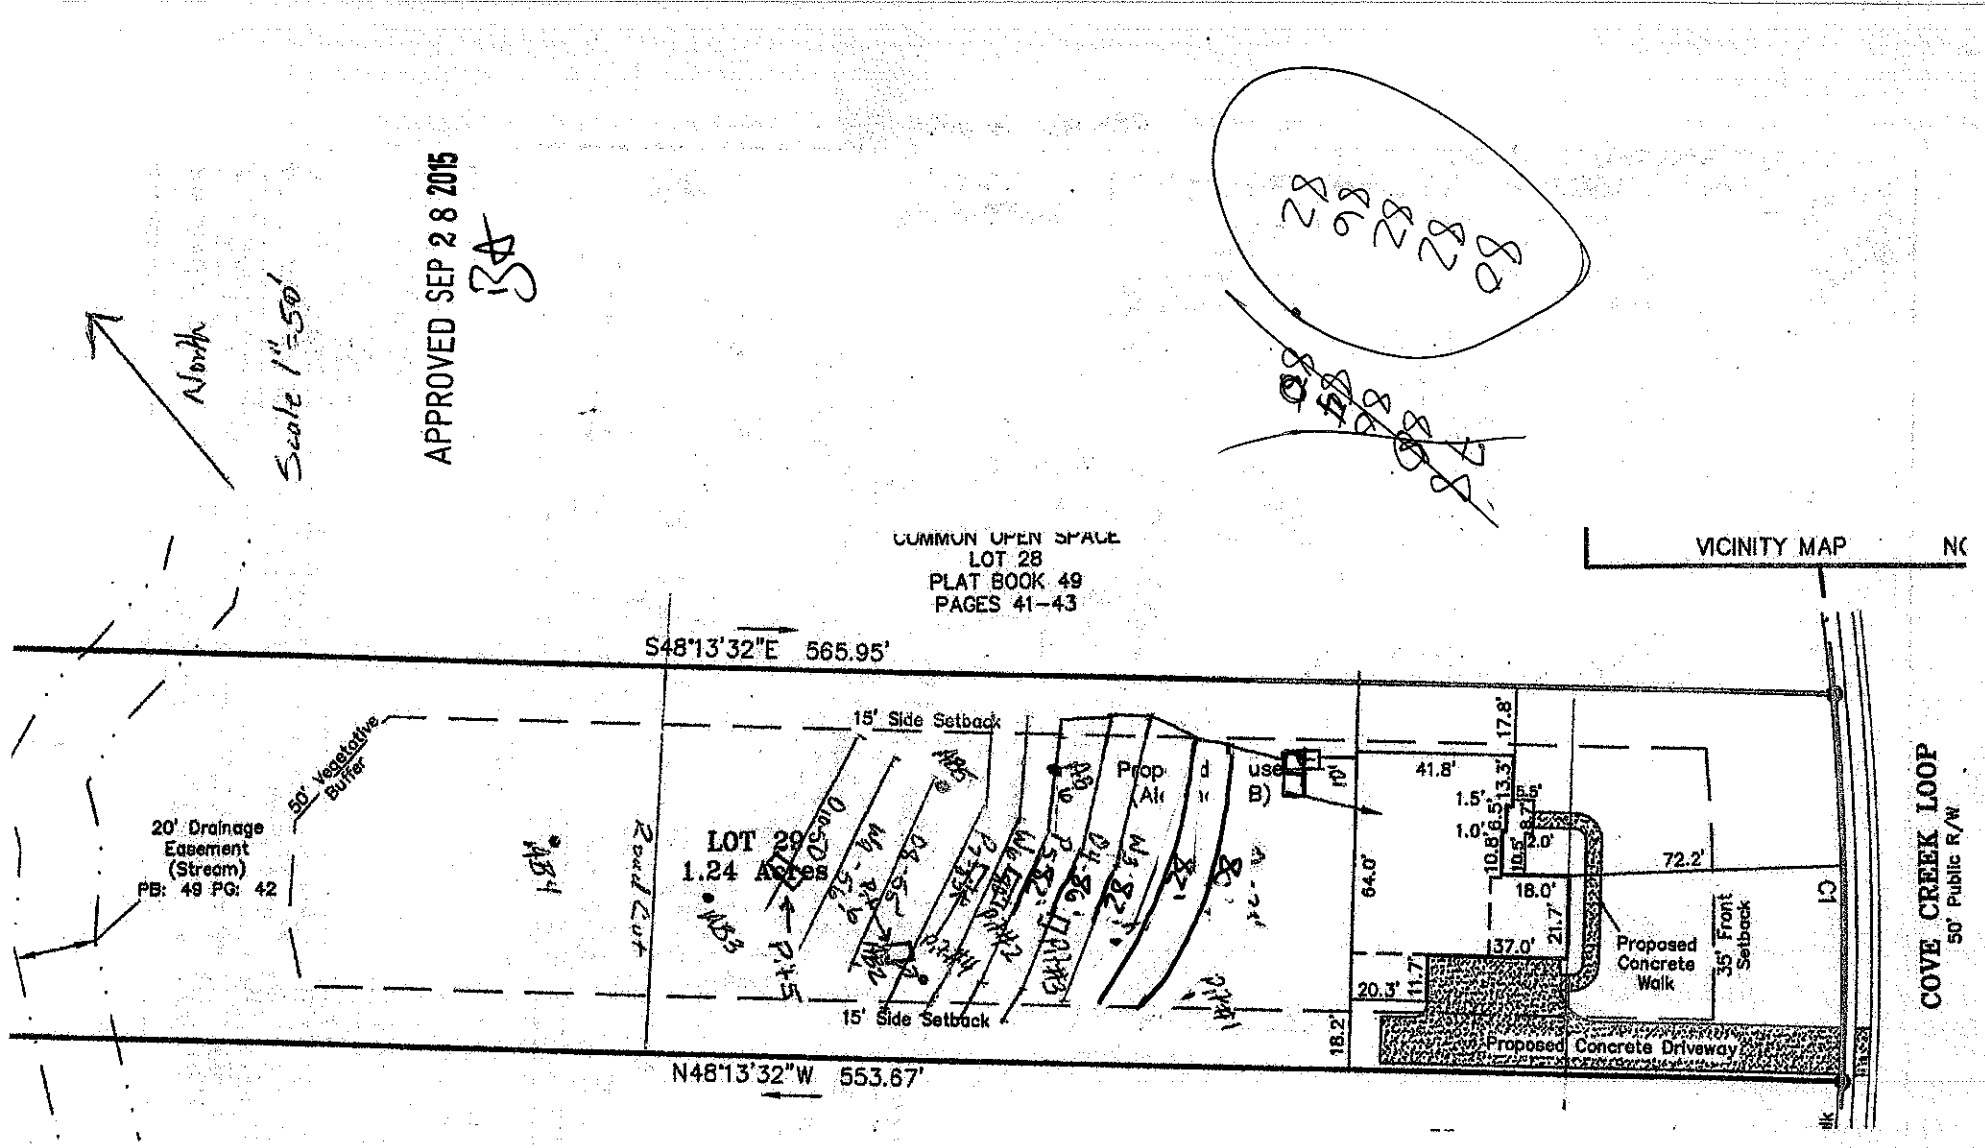
☐ **IMPROVEMENT PERMIT** *with plat valid without expiration.* ☐ **IMPROVEMENT PERMIT** *with site plan valid for 60 mos.* ☑ **AUTHORIZATION TO CONSTRUCT** *valid for period equal to IMPROVEMENT PERMIT--not to exceed 60 mo.*

Owner / Applicant Signature: Date: 10/21/15 Installed by: Abernathy

IMPROVEMENT PERMIT by: APPROVED Date: SEP 28 2015 OPERATION PERMIT by: Date: 2-22-16

AUTHORIZATION TO CONSTRUCT by: APPROVED Date: SEP 28 2015 Existing System Inspected by: Date:

Health Dept. Copy - WHITE Applicant (Final Approval) - YELLOW Applicant (Conditional Approval) - PINK


North
Scale 1"=50'
APPROVED SEP 2 8 2015
VICINITY MAP
COMMON OPEN SPACE
LOT 28
PLAT BOOK 49
PAGES 41-43
S48°13'32"E 565.95'
N48°13'32"W 553.67'
15' Side Setback
15' Side Setback
50' Vegetative Buffer
20' Drainage Easement (Stream) PB: 49 PG: 42
LOT 29
1.24 Acres
Prop
41.8'
17.8'
13.3'
1.5'
1.0'
10.8'
6.5'
10.5'
2.0'
72.2'
18.0'
64.0'
21.7'
137.0'
20.3'
11.7'
18.2'
Proposed Concrete Walk
35' Front Setback
Proposed Concrete Driveway
C1
COVE CREEK LOOP
50' Public R/W