IREDELL COUNTY HEALTH DEPARTMENT

Statesville Office (704) 878-5305 Mooresville Office (704) 660-3625 PERMIT # 206139

IMPROVEMENT PERMIT / AUTHORIZATION TO CONSTRUCT / OPERATION PERMIT / EXISTING SYSTEM

PIN # 4636-03-7487

APPLICANT: PEACHTREE RES. PROPERTY APPLICANT ADDRESS: 1930 CENTER PARK DR. #3 CHARLOTTE

SITE ADDRESS: 343 COVE CREEK LOOP PHONE: ALT. PHONE:

SITE DIRECTIONS: BSR, TL ISLE OF PINES, TR COVE CREEK LOOP, ON R

SUBDIVISION: CHESAPEAKE POINT SECTION: II LOT # 27 LOT AREA: 2.35AC DESIGN FLOW: 480 L.T.A.R.: .25 (.1R)

Septic Tank	1000 (gal)	STB 794	Date 10/9/15	☒ New System ☐ Repair ☐ Expansion	System Type: I II (III) IV V VI	☒ Residence	No. Bedrooms 4	Water Supply
Pump Tank	(gal)	PT	Date	System Description:	SHALLOW 25% REDUCTION	☐ Business	No. Persons	☐ Private
Pump Make	Model		Serial #	Repair System Description:	TS-1 DRIP	☐ Other	No. Employees	☐ Public
# Nitrification Fields 1	# Lines 7		Linear Ft: 485'	Maintenance Agreement Required:	☐ YES ☒ NO	☐ Slab	☒ Crawl Space	☒ Community
Trench Width 36"	Max. Trench Bottom Depth X 12" X		Gravel Depth		☒ GRAVITY ☐ PRESSURE	☐ Basement w/plumbing	☐ Basement w/o plumbing	

Comments / Conditions:

INITIAL SITE SKETCH

SEE PLAN FROM MICHAEL ATHANAS & ASSOCIATES

AS BUILT SKETCH

ESSENTIALLY INSTALLED AS DRAWN 7/15/15

NEED TO CHECK FILL DEPTH

FILL DEPTH VERIFIED 6"-12". 7/24/15

Permit can be suspended or revoked if any false information is supplied toward securing the permit / any unauthorized changes are made to the site / any unauthorized changes are made in the installation of the system. **CONTACT A LOCATOR SERVICE PRIOR TO ANY EXCAVATION**

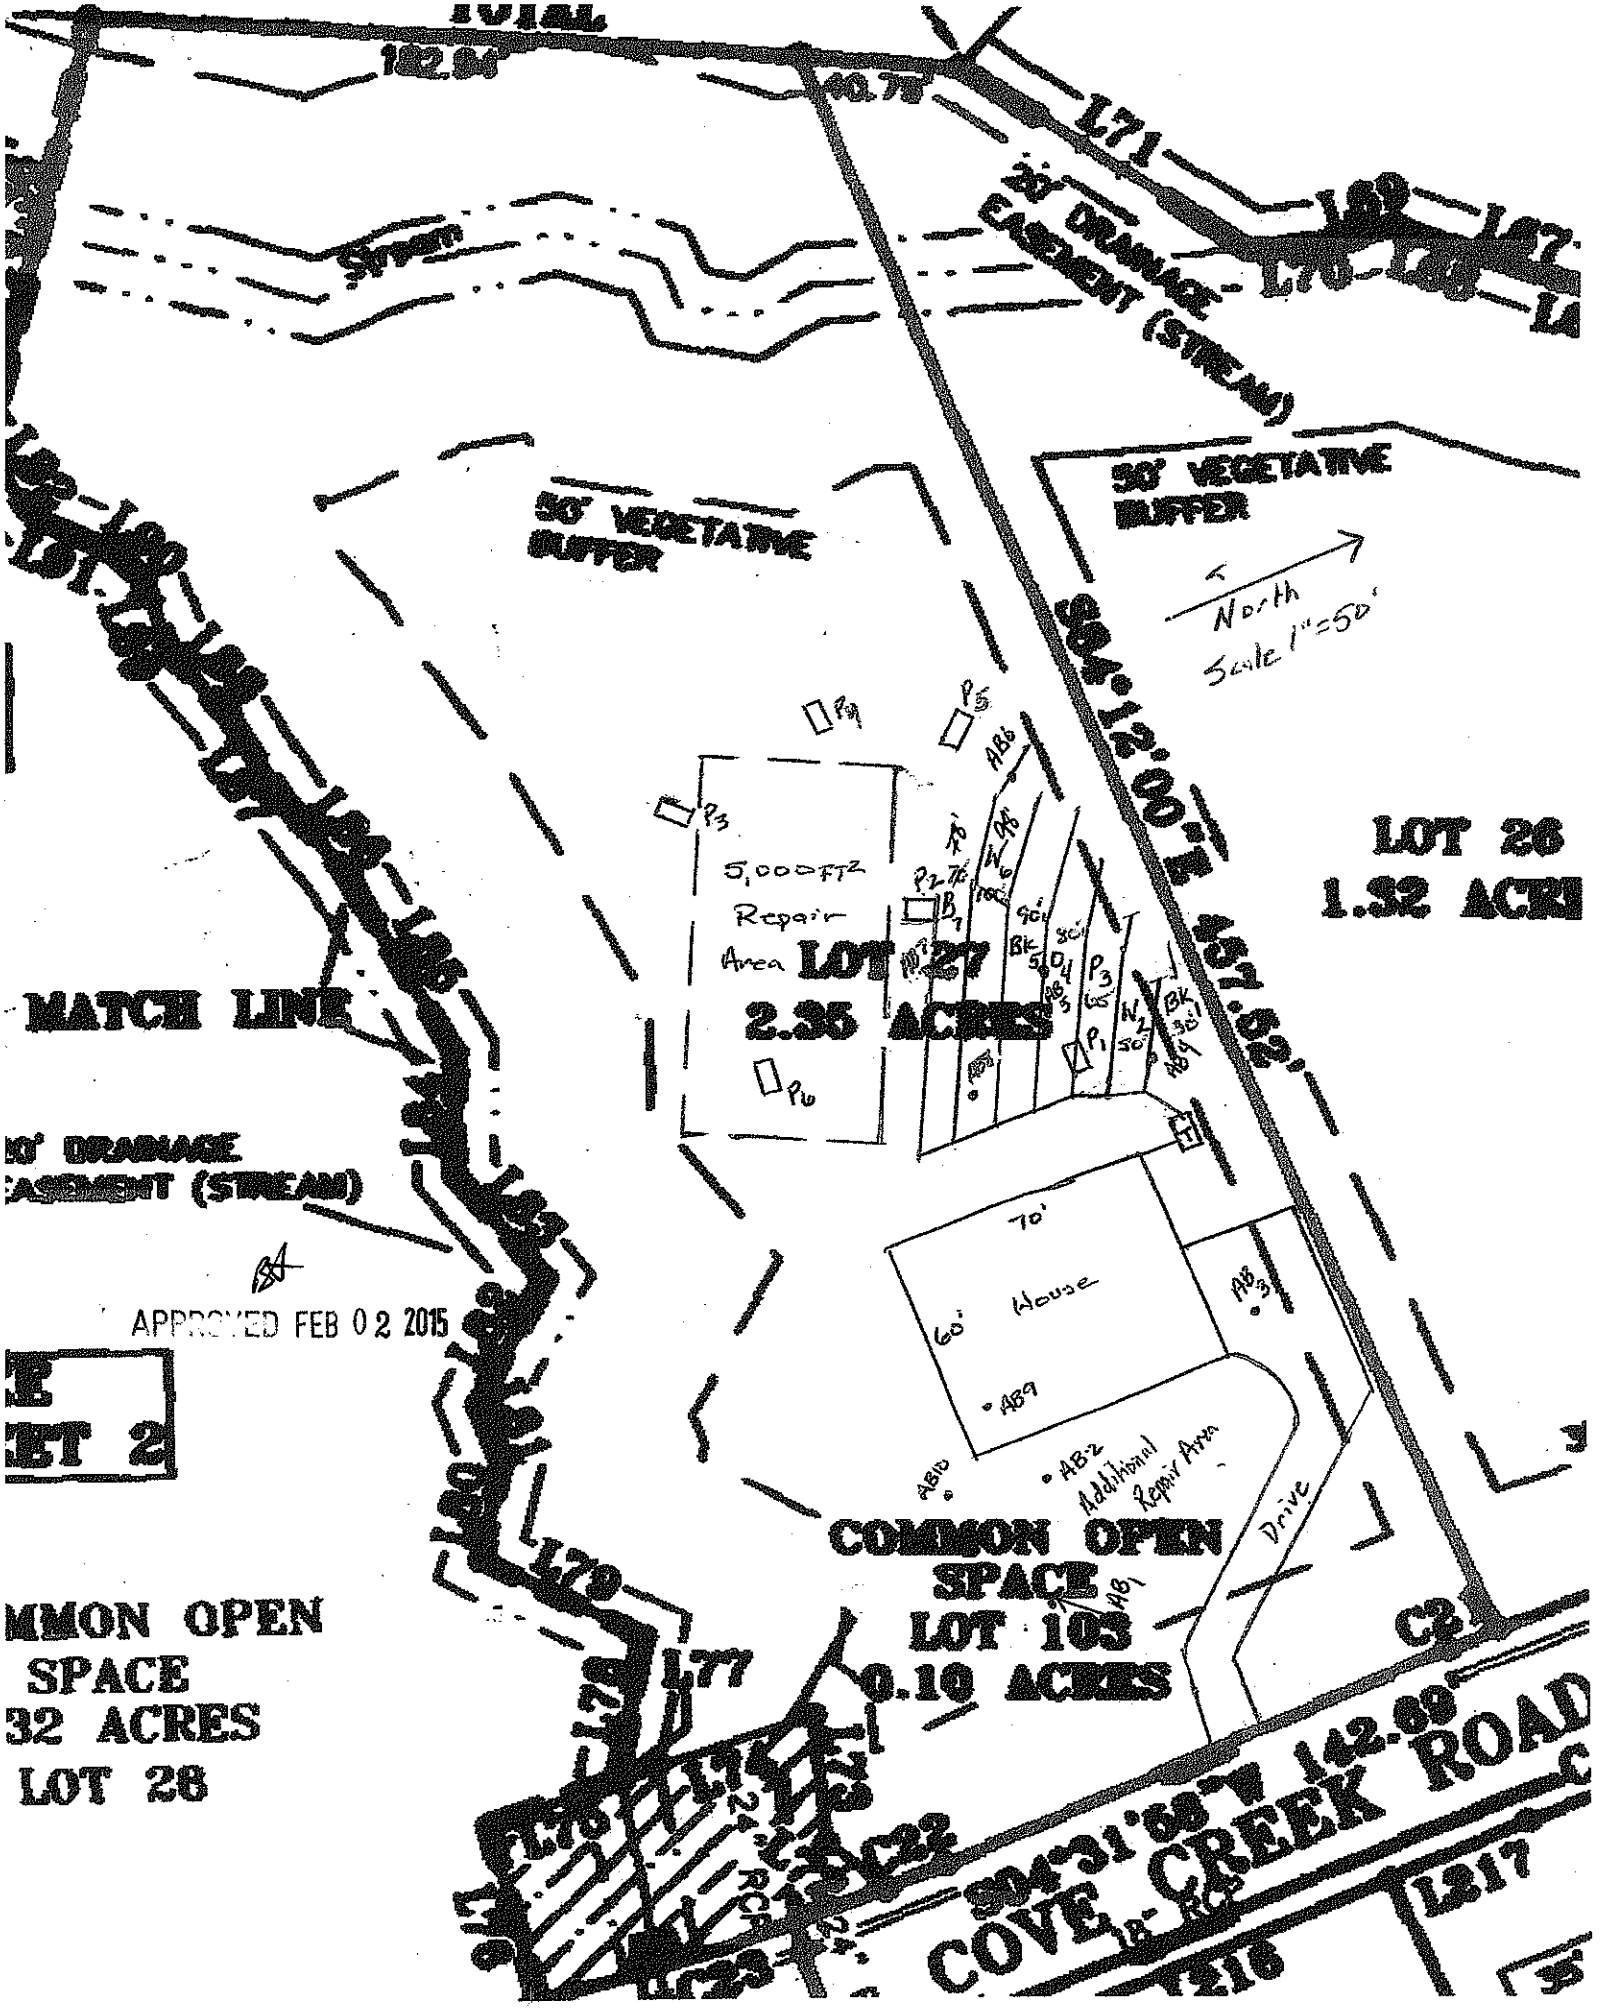
☐ **IMPROVEMENT PERMIT** *with plat valid without expiration.* ☒ **IMPROVEMENT PERMIT** *with site plan valid for 60 mos.* ☐ **AUTHORIZATION TO CONSTRUCT** *valid for period equal to IMPROVEMENT PERMIT--not to exceed 60 mo.*

Owner / Applicant Signature: Date: Feb 3-15 Installed by: RICHARD HOUGHTALING

IMPROVEMENT PERMIT by: APPROVED Date: FEB 02 2015 OPERATION PERMIT by: APPROVED Date: JUL 24 2015

AUTHORIZATION TO CONSTRUCT by: APPROVED Date: FEB 02 2015 Existing System Inspected by: Date:

Health Dept. Copy - WHITE Applicant (Final Approval) - YELLOW Applicant (Conditional Approval) - PINK


30' VEGETATIVE BUFFER
30' VEGETATIVE BUFFER
30' DRAINAGE EASEMENT (STREAM)
North
Scale 1"=50'
5,000FT2 Repair Area
LOT 27
2.35 ACRES
LOT 26
1.32 ACRE
MATCH LINE
APPROVED FEB 02 2015
70'
60'
House
Additional Repair Area
Drive
COMMON OPEN SPACE
LOT 103
0.10 ACRES
COMMON OPEN SPACE
32 ACRES
LOT 26
COVE CREEK ROAD