IREDELL COUNTY HEALTH DEPARTMENT

Statesville Office (704) 878-5305 | Mooresville Office (704) 660-3625 | PERMIT # 206140

IMPROVEMENT PERMIT / AUTHORIZATION TO CONSTRUCT / OPERATION PERMIT / EXISTING SYSTEM

PIN # 4636-03-8634

APPLICANT: PEACHTREE RES. PROP. APPLICANT ADDRESS: 1930 CENTER PARK DR. #3 CHARLOTTE

SITE ADDRESS: 349 COVE CREEK LOOP PHONE: ALT. PHONE:

SITE DIRECTIONS: BSR, TL ISLE OF PINES, TR COVE CREEK LOOP, ON R

SUBDIVISION: CHESAPEAKE POINT SECTION: 2 LOT # 26 LOT AREA: 1.32 AC DESIGN FLOW: 480 L.T.A.R.: .3(.25R)

Septic Tank 1000 (gal) STB INFILTRATOR Date —
Pump Tank 1000 (gal) PT INFILTRATOR Date —
Pump Make — Model — Serial # —
Nitrification Fields 1 # Lines 4 Linear Ft: 400'
Trench Width 36" Max. Trench Bottom Depth 36" Gravel Depth —

☒ New System ☐ Repair ☐ Expansion System Type: I II (III)B IV V VI
System Description: PM 75% REDUCTION
Repair System Description: PANEL BLOCK
Maintenance Agreement Required: ☐ YES ☒ NO ☐ GRAVITY ☒ PRESSURE

☒ Residence ☐ Business ☐ Other ☐ Slab ☐ Basement w/plumbing
No. Bedrooms 4 No. Persons — No. Employees — ☒ Crawl Space ☐ Basement w/o plumbing

Water Supply: ☐ Private ☐ Public ☒ Community

Comments / Conditions:

INITIAL SITE SKETCH

SEE PLAN FROM MICHAEL ATHANAS & ASSOCIATES

AS BUILT SKETCH

CHECKED LINES & TANKS 6-14-15 BA
SET 2' PM / ELEC & ALARM 9-11-15 BA

Permit can be suspended or revoked if any false information is supplied toward securing the permit / any unauthorized changes are made to the site / any unauthorized changes are made in the installation of the system. **CONTACT A LOCATOR SERVICE PRIOR TO ANY EXCAVATION**

☐ **IMPROVEMENT PERMIT** *with plat valid without expiration.* ☐ **IMPROVEMENT PERMIT** *with site plan valid for 60 mos.* ☒ **AUTHORIZATION TO CONSTRUCT** *valid for period equal to IMPROVEMENT PERMIT--not to exceed 60 mo.*

Owner / Applicant Signature: Date: Feb-2-15 Installed by: ABERNATHY


IMPROVEMENT PERMIT by: APPROVED FEB 02 2015 Date: OPERATION PERMIT by: APPROVED Date: SEP 11 2015

AUTHORIZATION TO CONSTRUCT by: APPROVED FEB 02 2015 Existing System Inspected by: Date:

Health Dept. Copy - WHITE Applicant (Final Approval) - YELLOW Applicant (Conditional Approval) - PINK

PRELIMINARY PLAT

JIMMY N. FAIRES, PLS
LICENSE NUMBER: L-4311

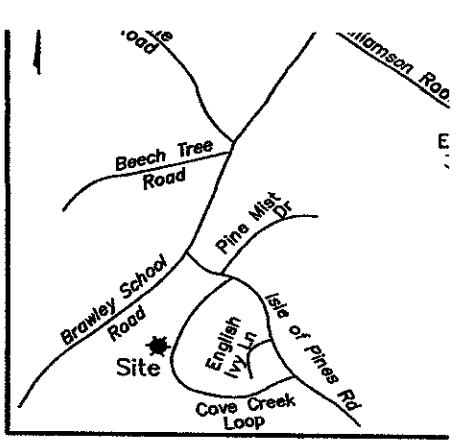


PRELIMINARY PLA
NOT FOR RECORDAT
CONVEYANCES AND/OR

APPROVED FEB 02 2015

Plat Book 51 Page 76
Dated: 3/22/2007

Scale 1"=50'

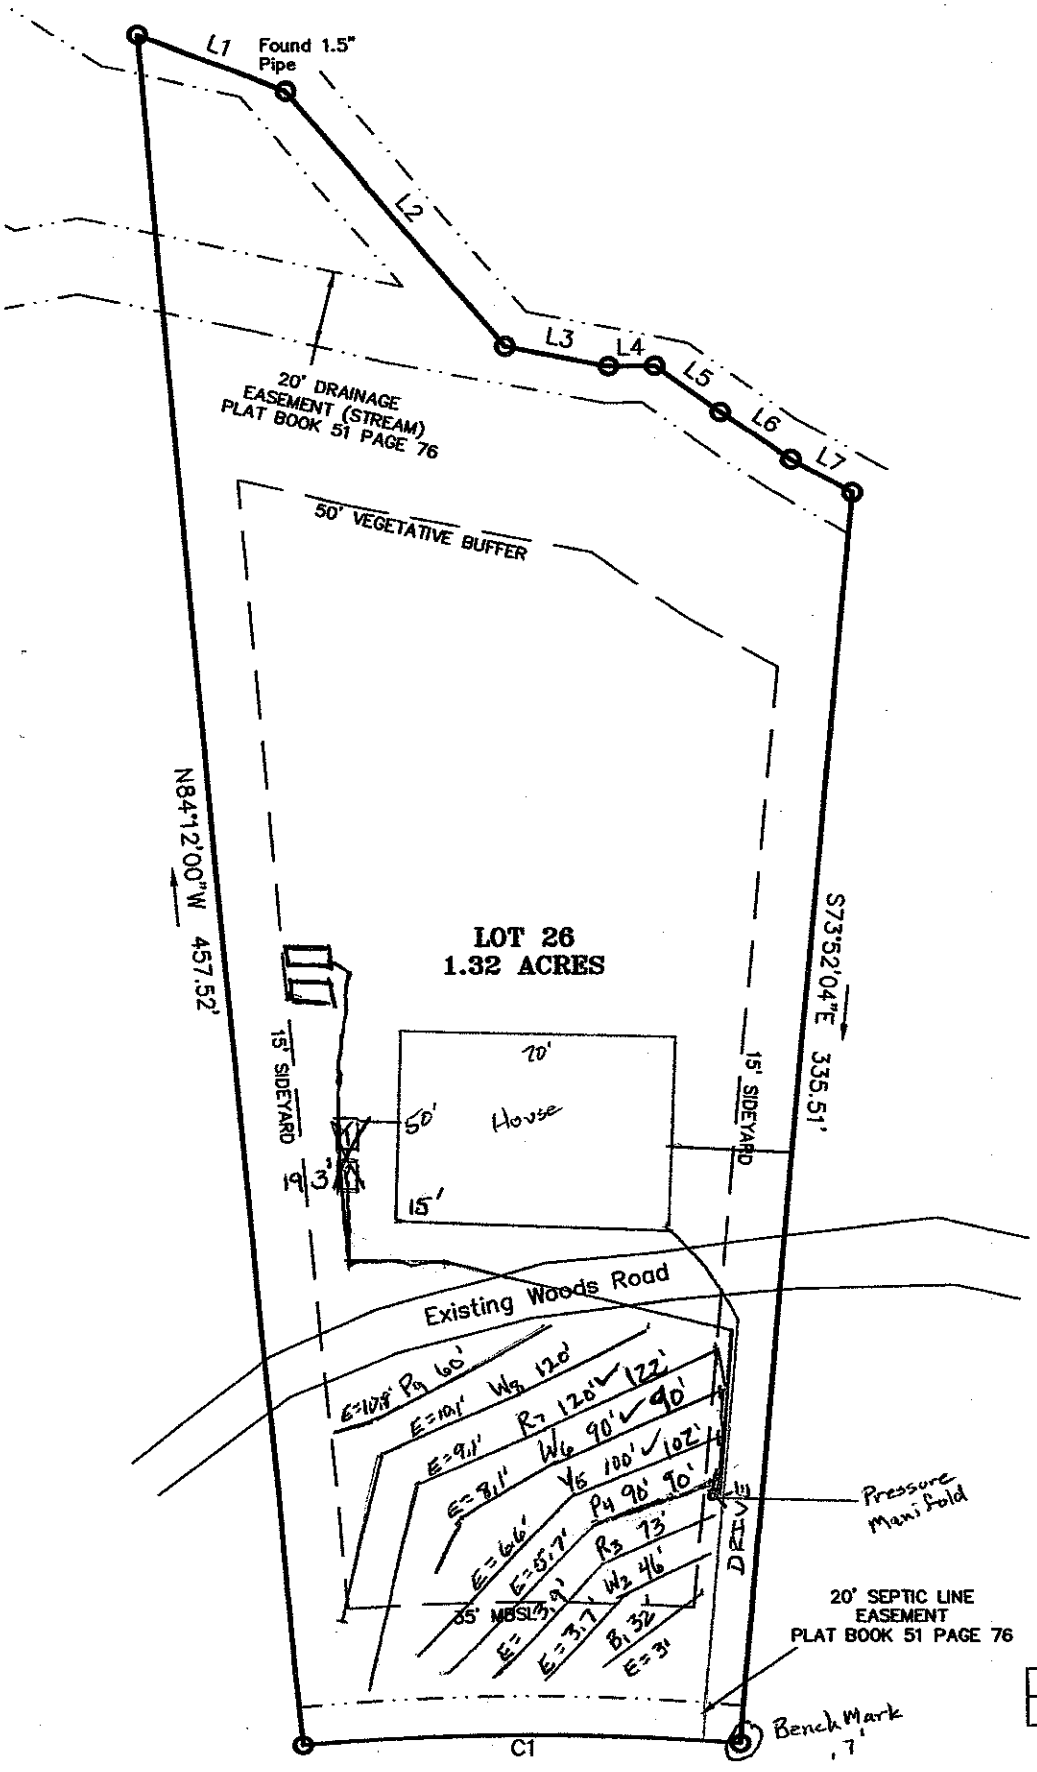

LINE	BEARING
L1	N31°55'39"E
L2	N61°03'32"E
L3	N22°03'35"E
L4	N10°18'16"E
L5	N47°42'29"E
L6	N45°59'45"E
L7	N40°33'45"E

CURVE	RADIUS	ARC	CHORD BEARING
C1	625.00'	112.71'	S10°57'58"W