IREDELL COUNTY HEALTH DEPARTMENT

STATESVILLE 704-878-5305 MOORESVILLE 704-664-5281

IMPROVEMENT PERMIT / AUTHORIZATION TO CONSTRUCT / OPERATION PERMIT / EXISTING SYSTEM INSPECTION

PERMIT# DOT EXPANSION/REPAIR PIN# 4636 05 0299 DATE 5/20/08

OWNER OR APPLICANT DINA HINSON PHONE: Business 704-664-6282 Home 704-660-6867

ADDRESS 1348 BRAINLEY SCHOOL RD. (LOT 1)

LOCATION 1100 TR PINE MEADOW ON (L) CORNER

SUBDIVISION _____ BLOCK / SECTION _____ LOT 1 LOT AREA _____ SITE CLASS. PS DESIGN FLOW 360 L.T.A.R. .3

Septic Tank: EXISTING/1000 Gallons: STB _____ Date _____

Pump Tank: _____ Gallons: PT _____ Date _____

Pump Make: _____ Model _____ Serial No. _____

Nitrification Field: No Fields 1 Square Feet 225 Linear Feet 75

No Lines 1 Trench Width 36" Max Trench Bottom Depth 36"

☐ New System ☒ Repair ☒ Expansion System Type: I (II) III IV V VI

System Description: 25% REDUCTION

Repair System Description: LP - PPBPS

Maintenance Agreement Required: ☐ Yes ☒ No

☐ House/Mod. Home No. Bedrooms 3

☐ Mobile Home No. Persons ____

☐ Business No. Employees ____

☐ Other _____

Water Supply: ☒ Individual ☐ Public ☐ Community

Gravel Depth No ☒ Gravity ☐ Pressure ☐ Slab ☒ Crawl Space ☐ Basement w/plumbing ☐ Basement wo/plumbing

Comments:/Conditions: EASEMENT RECORDED?

THIS SYSTEM MOVED TO ACCOMODATE DOT ROAD EXPANSION

Comments:/Conditions:


INITIAL SITE SKETCH

(1) 3 LINES CUT AT R/W AND FILLED WITH COMPACTED SOIL

(2) D/B's HOOKED UP AS SHOWN HERE

(3) SPECIAL LEVELERS FOR ALL LINES

AS BUILT SKETCH

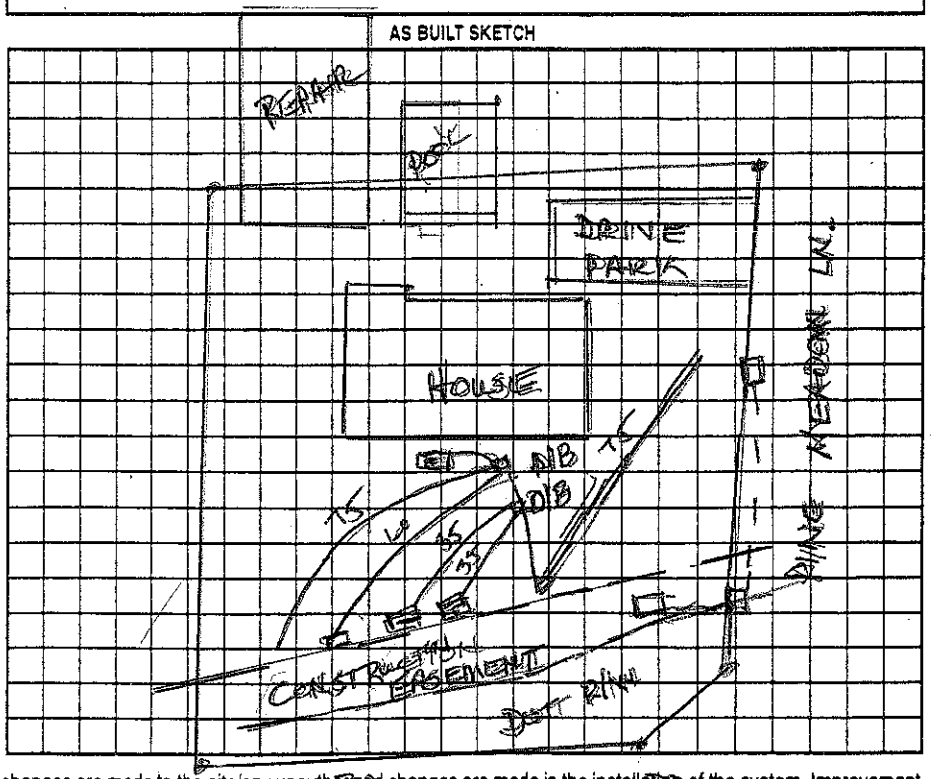

Permit can be suspended or revoked if any false information is supplied toward securing the permit/any unauthorized changes are made to the site/any unauthorized changes are made in the installation of the system. Improvement Permit with plat valid without expiration ☐ Improvement Permit with site plan valid for sixty months ☐ Authorization to Construct is valid for a period equal to that of Improvement Permit – not to exceed sixty months.

Signed: _____ date _____

Improvement Permit by: JM date 12/4/06

Authorization to Construct by: JM date 9/4/07

Installed by: RICHARD ABERNATHY

Operation Permit by: Wesley Sparks RS. date 5/20/08

Existing System Inspection by: _____ date _____

HEALTH DEPT. COPY: WHITE OWNER COPY (FINAL): YELLOW OWNER COPY (INITIAL): PINK