IREDELL COUNTY HEALTH DEPARTMENT

Authorization to Construct

4636 05 0452

STATESVILLE 704-878-5305 MOORESVILLE 704-664-5281

IMPROVEMENT PERMIT / ~~CERTIFICATE OF COMPLETION~~ / OPERATION PERMIT / EXISTING SYSTEM INSPECTION

PROPERTY DESCRIPTION NO. 22391 DATE 11/7/95 TAX MAP NO. 2F A 16 Ptof Watershed: [X] Yes [ ] No

OWNER OR CONTRACTOR Dina Kay Hinson PHONE: Business Home 664-6282

ADDRESS 1348 Brawley School Rd. Mooresville, NC. 28115

LOCATION Brawley Sch Rd, TR Pine Meadow Ln. to 2ND lot on (L)

SUBDIVISION N/A BLOCK / SECTION LOT LOT AREA .51 AC SITE CLASS. PS DESIGN FLOW 360 L.T.A.R. .3

Septic Tank: 1000 Gallons; STB 794 Date 7/27/95

Pump Tank: Gallons; PT Date

Pump Make: Model Serial No.

Nitrification Field: No Fields 1 Square Feet 1200 Linear Feet ~~X~~ 400

No Lines 4 Trench Width 36" Max Trench Bottom Depth 36" Gravel Depth 12"

[X] New System [ ] Repair System Type: I, II, III, IV, V, VI

System Description: CRAV. CONVENTIONAL

Repair System Description: SAME

Maintenance Agreement Required: [ ] Yes [X] No

[X] House [Mod. Home] No. Bedrooms 3

[ ] Mobile Home No. Bathrooms 2

[ ] Business No. Employees

[ ] Other


[ ] Slab [X] Crawl Space [ ] Basement w/plumbing [ ] Basement wo/plumbing

Water Supply: [X] Individual [ ] Community [ ] Public

Comments: ~~X~~ 3 sept of slope tuation

Comments: Installed as drawn

INITIAL SITE SKETCH

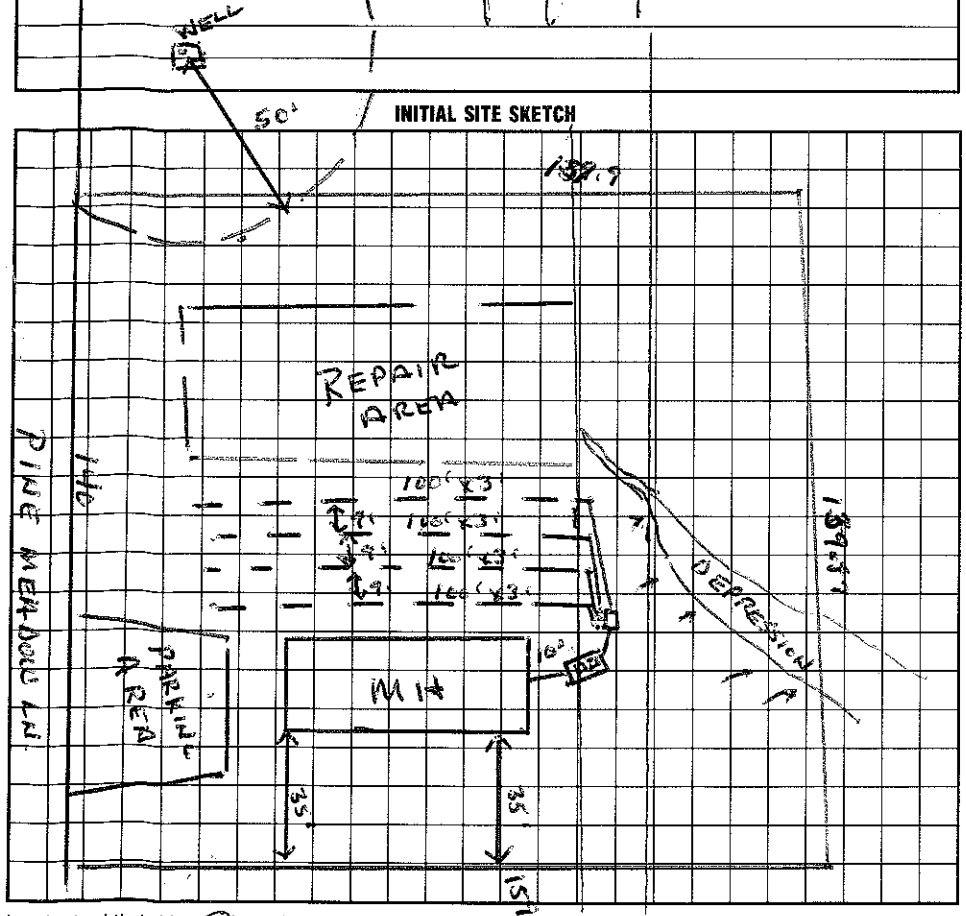

AS BUILT SKETCH

I understand that this permit can be suspended or revoked if any false information is supplied toward securing the permit/any unauthorized changes are made to the site/any unauthorized changes are made in the installation of the system.

Signed: X

Improvement Permit by: Wesley Sparks RS. date 11/7/95

Authorization to Construct by: Wesley Sparks RS. date 11/7/95

Existing System Inspection by:

Installed by: Barry Thompson

Certificate of Completion by: Wesley Sparks RS date 11/22/95

Operation Permit by: Wesley Sparks RS date 11/22/95

HEALTH DEPT. COPY: WHITE INSPECTION COPY (FINAL): GREEN OWNER COPY (FINAL): YELLOW INSPECTION COPY (INITIAL): PINK OWNER COPY (INITIAL): GOLD