IREDELL COUNTY HEALTH DEPARTMENT

STATESVILLE 704-878-5305 MOORESVILLE 704-664-5281

IMPROVEMENT PERMIT / AUTHORIZATION TO CONSTRUCT / OPERATION PERMIT / EXISTING SYSTEM INSPECTION

PERMIT # REPAIR PIN # 4636-05-5671 DATE 1-25-10

OWNER or APPLICANT HERMAN KRUGER PHONE: Business 704-634-8477 Home:

OWNER or APPLICANT ADDRESS

LOCATION / DIRECTIONS BSR, TR ISLAND FOREST, #8 ON L

SUBDIVISION LOPEZ MH PARK BLOCK / SECTION LOT # 8 LOT AREA DESIGN FLOW 240GPD L.T.A.R. .3

Septic Tank 1000 Gallons: STB 794 Date 10-23-09 ☐ New System ☒ Repair ☐ Expansion System Type I II III IV V VI

Pump Tank Gallons: P T Date System Description:

Pump Make Model Serial # Repair System Description: GRAVITY 25% REDUCTION

Nitrification Field No Fields 1 No Lines 3 Linear Feet 204' Maintenance Agreement Required ☐ YES ☒ NO


Trench Width 36" Max. Trench Bottom Depth 24" Gravel Depth — ☒ GRAVITY ☐ PRESSURE

☒ Residence No. Bedrooms 2 ☐ Business No. Persons ☐ Other No. Employees ☐ Slab ☒ Crawl Space ☐ Basement w/plumbing ☐ Basement w/o plumbing

Water Supply: ☐ Private ☐ Public ☒ Community


Comments / Conditions: 1) USE SHALLOW TRENCH TO STAY OUT OF OLD SYSTEM 2) USE STEP DOWNS AS NEEDED 3) SPEED LEVELERS IN D-BOX 4) PUMP + CRUSH OLD TANK / OR REMOVE AS NEEDED

INITIAL SITE SKETCH

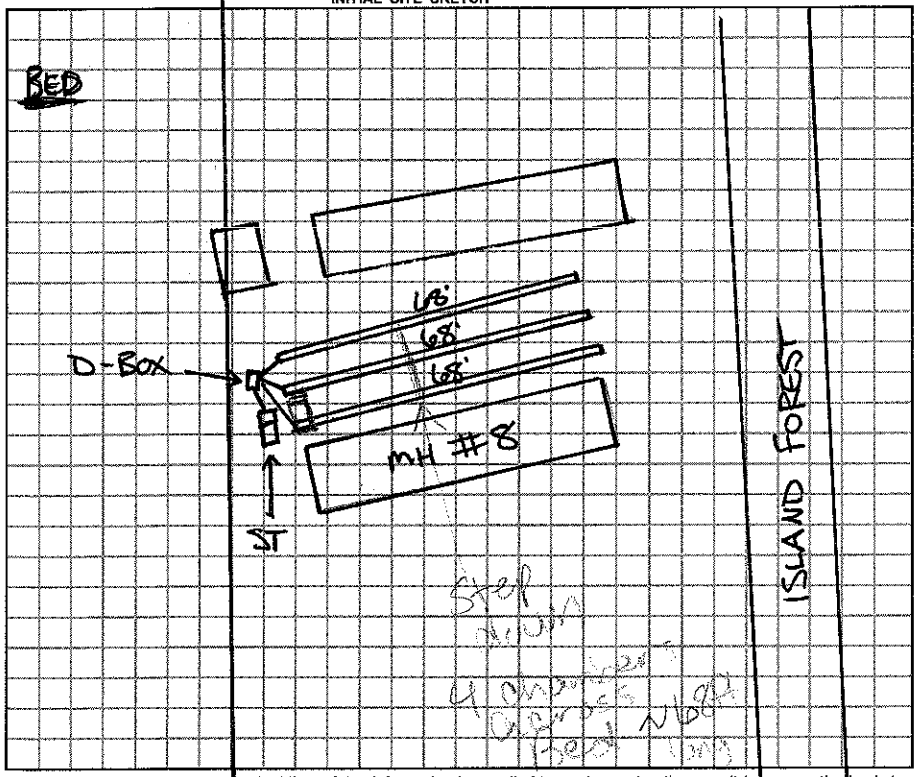

Comments / Conditions: Used Arc 36 Plastic Chambers
BA checked ST 2/11/2010
MD checked drainfield 2/12/2010

AS BUILT SKETCH

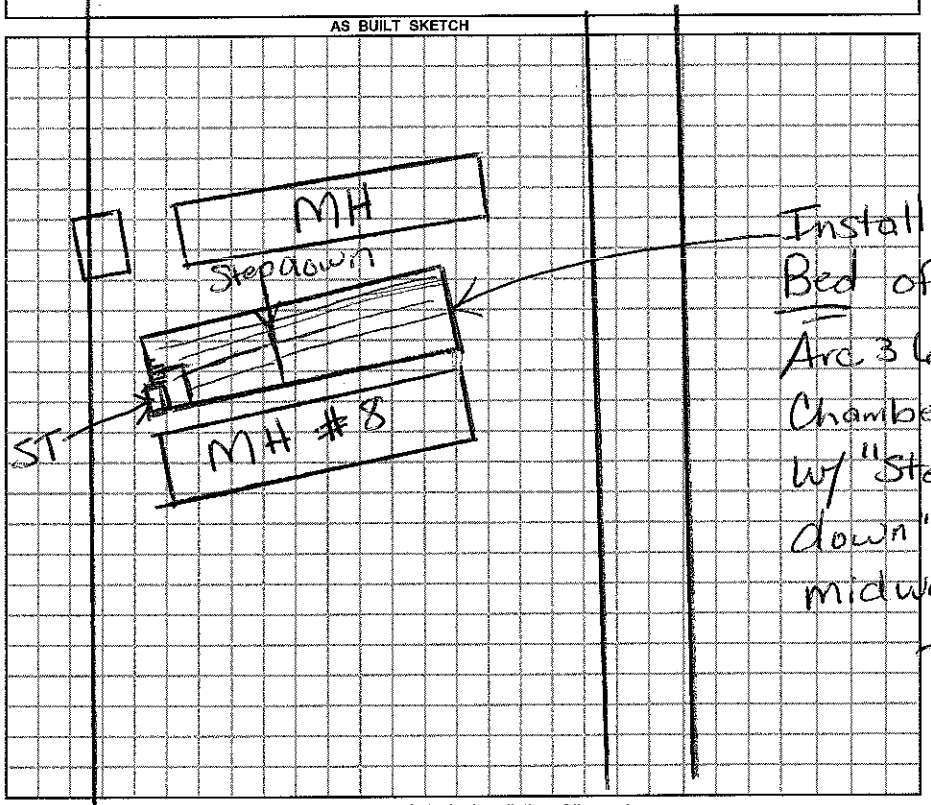

Permit can be suspended or revoked if any false information is supplied toward securing the permit / any unauthorized changes are made to the site / any unauthorized changes are made in the installation of the system.

☐ *IMPROVEMENT PERMIT w / plat valid without expiration.* ☐ *IMPROVEMENT PERMIT w / site plan valid for 60 mos.* ☐ *AUTHORIZATION TO CONSTRUCT valid for period equal to IMPROVEMENT PERMIT-not to exceed 60 mo.*

Owner / Applicant Signature: Date 1-27-10 Installed by: Richard Abernathy

Improvement Permit by: REHS Date 1-25-10 Operation Permit by: REHS Date: 2-12-10

Authorization to Construct by: REHS Date 1-25-10 Existing System Inspected by: Date:

YOU SHOULD CONTACT A LOCATOR SERVICE PRIOR TO ANY EXCAVATION.

WHITE COPY Environmental Health YELLOW COPY (Final) Owner / Applicant PINK COPY (Initial) Owner / Applicant