IREDELL COUNTY HEALTH DEPARTMENT

STATESVILLE 704-878-5305 MOORESVILLE 704-664-5281

IMPROVEMENT PERMIT / AUTHORIZATION TO CONSTRUCT / OPERATION PERMIT / EXISTING SYSTEM INSPECTION

PERMIT# 119279 PIN# 4636 05 5449 4636-05-5671 DATE 3/26/04

OWNER OR CONTRACTOR Jesus Lopez - Lopez MH Park PHONE: Business 704-664-3632 Home

ADDRESS 1302 Brawley School Rd. Mooresville, NC. 28117

LOCATION 1100 TR Island Forest on (R) where yellow block building is located.

SUBDIVISION Lopez MH Park BLOCK / SECTION LOT LOT AREA SITE CLASS. PS DESIGN FLOW 150 GPD L.T.A.R. .3

Septic Tank: 1000 Gallons; STB 794 Date 7/17/04
Pump Tank: Gallons; PT Date
Pump Make: Model Serial No.
Nitrification Field: No Fields 1 Square Feet 800 Linear Feet 300
No Lines 3@100' Trench Width 3' Max Trench Bottom Depth 3' Gravel Depth 12"

☒ New System ☐ Repair System Type: I, (II), III, IV, V, VI
System Description: GRAVITY - CONVENTIONAL
Repair System Description: SAME
Maintenance Agreement Required: ☐ Yes ☒ No


☐ House/Mod. Home No. Bedrooms
☐ Mobile Home No. Bathrooms
☐ Business No. Employees
☒ Other BUILDING WITH WASHING MACHINE
☐ Slab ☒ Crawl Space ☐ Basement w/plumbing ☐ Basement w/o plumbing

Water Supply:
☐ Individual
☐ Public
☒ Community


Comments:/Conditions:

Comments:/Conditions:

INITIAL SITE SKETCH

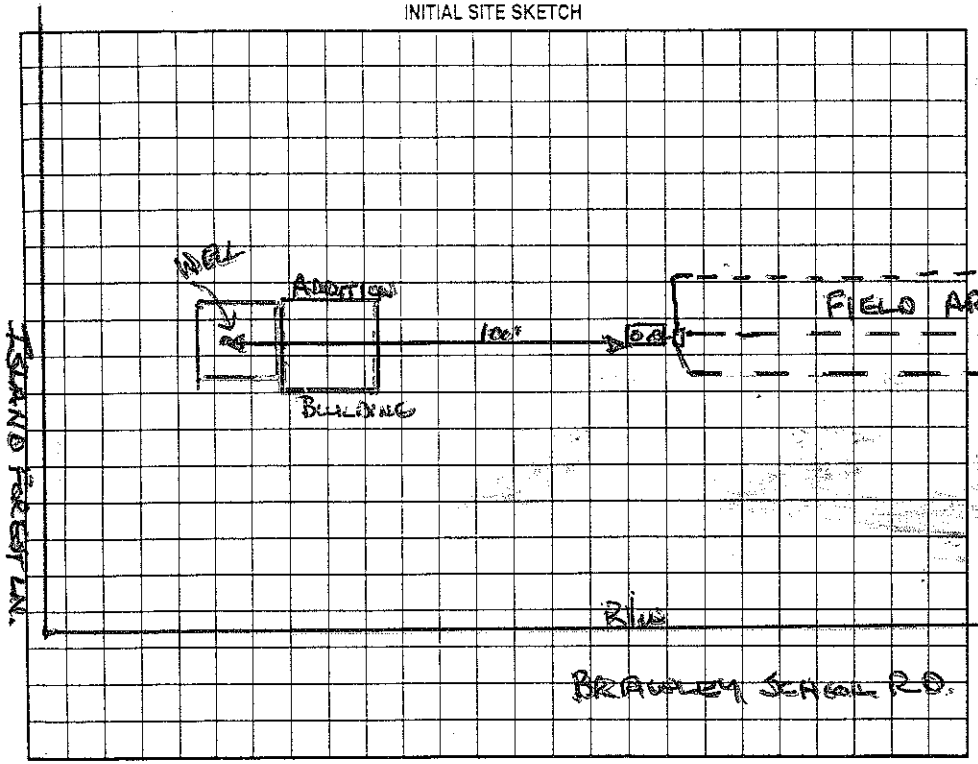

AS BUILT SKETCH

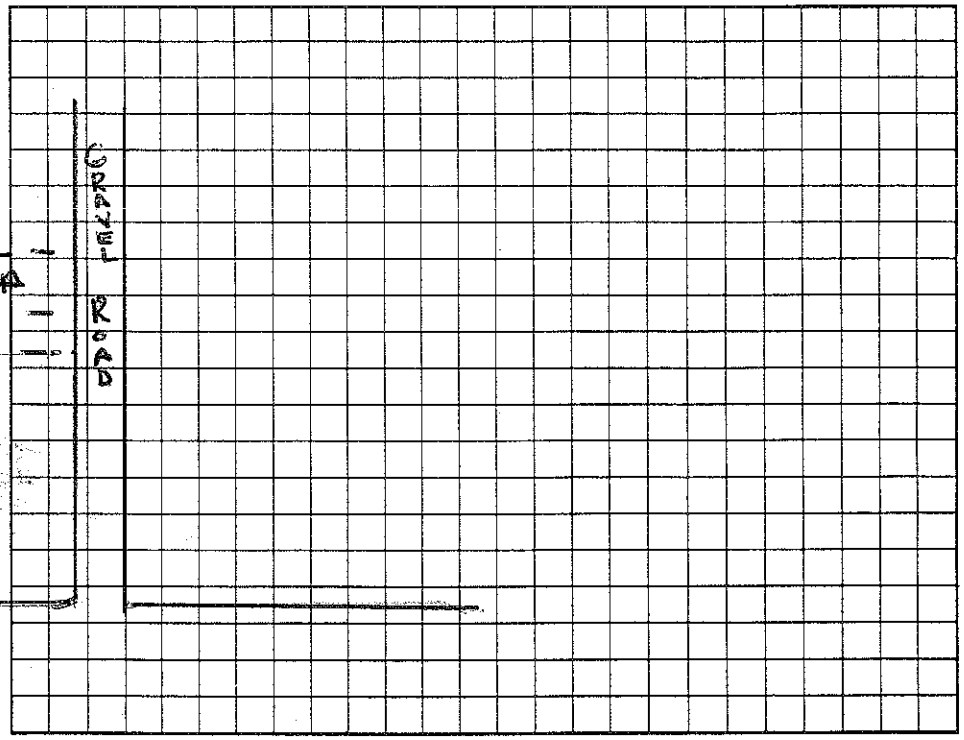

Permit can be suspended or revoked if any false information is supplied toward securing the permit/any unauthorized changes are made to the site/any unauthorized changes are made in the installation of the system. Improvement Permit with plat valid without expiration. Improvement Permit with site plan valid for sixty months. Authorization to Construct is valid for a period equal to that of Improvement Permit – not to exceed sixty months.

Signed: date

Improvement Permit by: Wesley Sparks RS. date 3/26/04

Authorization to Construct by: Wesley Sparks RS. date 3/26/04

Installed by: Richard Abernathy

Operation Permit by: Wesley Sparks RS. date 8/19/04

Existing System Inspection by: date

HEALTH DEPT. COPY: WHITE OWNER COPY (FINAL): YELLOW OWNER COPY (INITIAL): PINK