3.00

IREDELL COUNTY HEALTH DEPARTMENT

STATESVILLE 704-878-5305 MOORESVILLE 704-664-5281

IMPROVEMENT PERMIT / AUTHORIZATION TO CONSTRUCT / OPERATION PERMIT / EXISTING SYSTEM INSPECTION

PERMIT# Repair PIN# 4636-05-8682 DATE 3/26/07

OWNER OR APPLICANT Jesus Lopez PHONE: Business Home 634-8477 Herman Kruger

ADDRESS 1308 Brawley School Rd Mooresville, NC 28117

LOCATION Brawley School Rd

SUBDIVISION Lopez Mt Park BLOCK / SECTION LOT 1 LOT AREA .57 Acre SITE CLASS PS DESIGN FLOW 240gpd L.T.A.R. .3

Exist Septic Tank: 1000 Gallons: STB Date

Pump Tank: Gallons: PT Date

Pump Make: Model Serial No.

Nitrification Field: No Fields 1 Square Feet 1600 Linear Feet 2000

No Lines 20/100' Trench Width 36" Max Trench Bottom Depth 36"

~~X~~ New System ☒ Repair ☐ Expansion ~~S~~

System Description: Grav. 25% Reduction

Repair System Description: Grav – 25% Reduction

Maintenance Agreement Required: ☐ Yes ~~X~~ No

~~X~~ House/Mod. Home ☐ Mobile Home ☐ Business ☐ Other

No. Bedrooms 2 No. Persons No. Employees

Water Supply: ~~X~~ Individual ~~X~~ Public ☒ Community

Gravel Depth ~~X~~ Gravity ☐ Pressure ☐ Slab ☒ Crawl Space ☐ Basement w/plumbing ☐ Basement wo/plumbing


Comments:/Conditions: ~~X~~ If water line encountered, reinstall at least 10ft from Septic System

Comments:/Conditions:

INITIAL SITE SKETCH

PL 115

Scale ~ 1:50

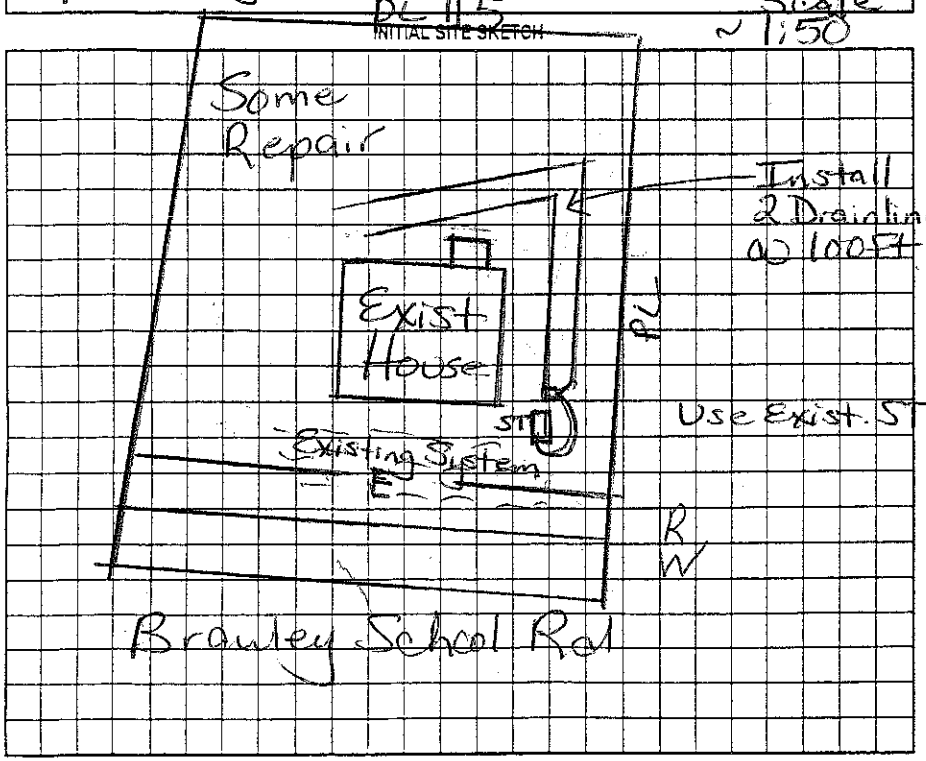

AS BUILT SKETCH

Permit can be suspended or revoked if any false information is supplied toward securing the permit/any unauthorized changes are made to the site/any unauthorized changes are made in the installation of the system. Improvement Permit with plat valid without expiration ☐ Improvement Permit with site plan valid for sixty months ☐ Authorization to Construct is valid for a period equal to that of Improvement Permit – not to exceed sixty months.

Signed: Kathleen Saunders date 5/3/07 Installed by: Richard Abernathy

Improvement Permit by: Marion H. Tolson date 3/26/07 Operation Permit by: Richard Abernathy date 5/12/09

Authorization to Construct by: Marion H. Tolson date 3/26/07 Existing System Inspection by: date

HEALTH DEPT. COPY: WHITE OWNER COPY (FINAL): YELLOW OWNER COPY (INITIAL): PINK