IREDELL COUNTY HEALTH DEPARTMENT

STATESVILLE 704-878-5305 MOORESVILLE 704-664-5281

IMPROVEMENT PERMIT / AUTHORIZATION TO CONSTRUCT / OPERATION PERMIT / EXISTING SYSTEM INSPECTION

PERMIT # 161671 PIN # 4636-06-0881 DATE 7-7-10

OWNER or APPLICANT MATT MCMULLEN PHONE: Business 704-400-1710 Home:

OWNER or APPLICANT ADDRESS 555 DELRURG ST. DAVIDSON NC 28036

LOCATION / DIRECTIONS BSR, TR POPLAR GROVE, TR TAWNY BARK, TL SYCAMORE SLOPE, ON R

SUBDIVISION POPLAR GROVE BLOCK / SECTION LOT # 33 LOT AREA .878 AC DESIGN FLOW 480 GPD L.T.A.R. .3

Septic Tank 1000 Gallons: STB 312 Date 2-26-10

Pump Tank Gallons: P T Date

Pump Make Model Serial #

Nitrification Field No Fields 1 No Lines 5 Linear Feet 400'

Trench Width 36" Max. Trench Bottom Depth 36" Gravel Depth —

☒ New System ☐ Repair ☐ Expansion System Type I II III IV V VI

System Description: GRAVITY 25% REDUCTION

Repair System Description: SAME

Maintenance Agreement Required ☐ YES ☒ NO

☒ GRAVITY ☐ PRESSURE


☒ Residence No. Bedrooms 4 ☐ Business No. Persons ☐ Other No. Employees ☒ Slab ☐ Crawl Space ☐ Basement w/plumbing ☐ Basement w/o plumbing

Water Supply: ☒ Private ☐ Public ☐ Community


Comments / Conditions 1) SETBACK FROM WELL TO SEPTIC MUST BE MIN 100' 2) MEET ALL REQUIRED SETBACKS

Comments / Conditions 130, 120, 85, 65

INITIAL SITE SKETCH

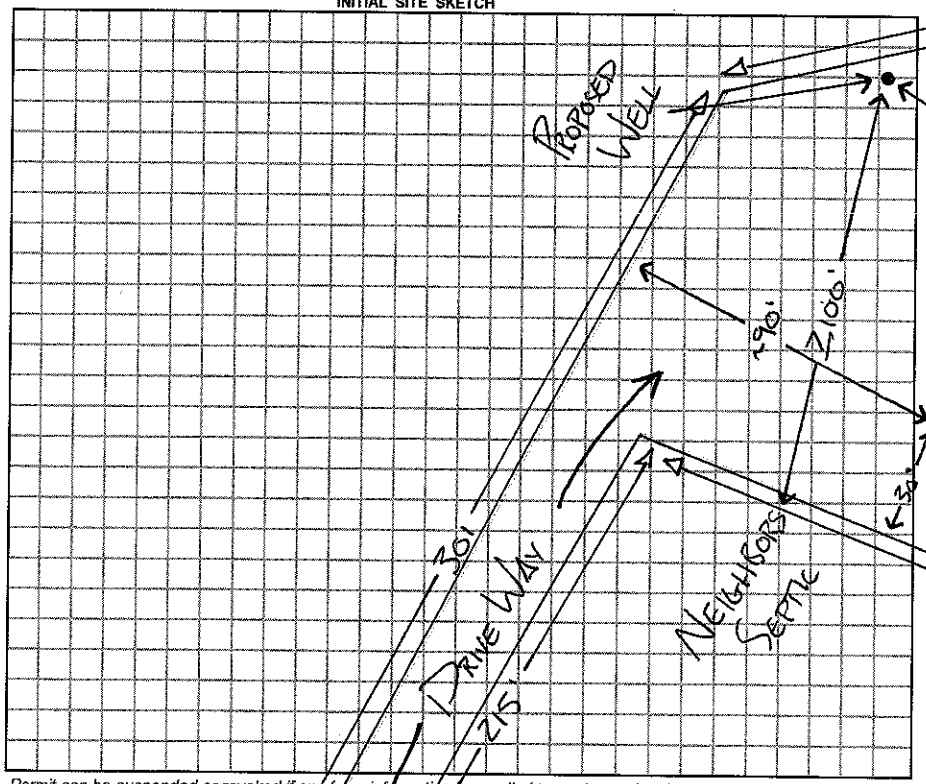

AS BUILT SKETCH

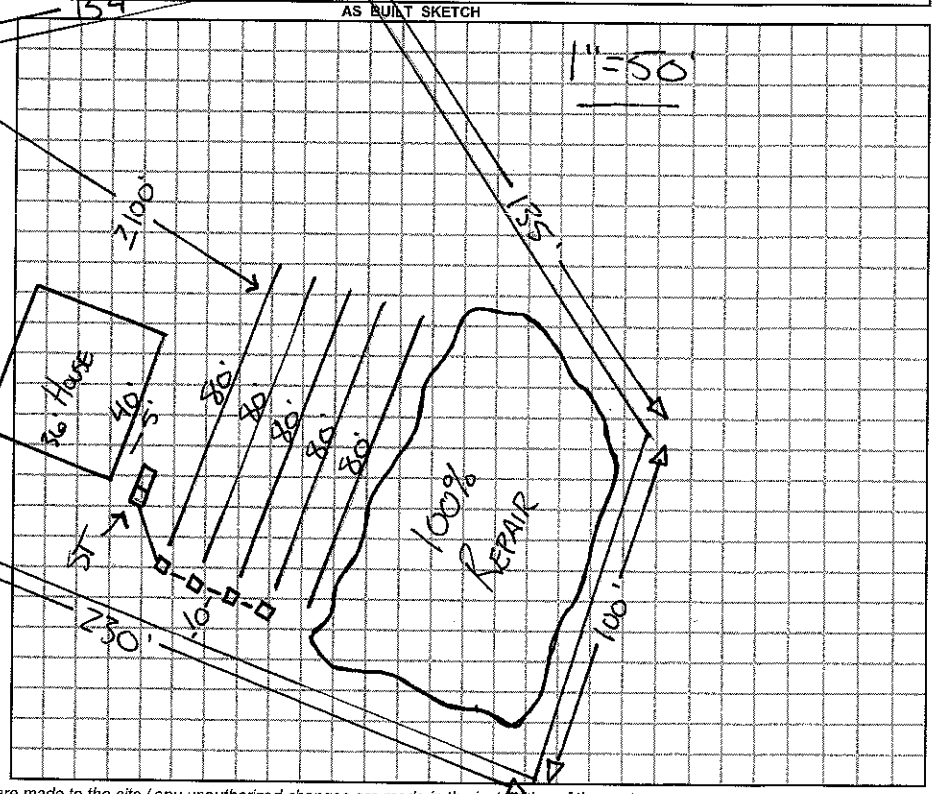

Permit can be suspended or revoked if any false information is supplied toward securing the permit / any unauthorized changes are made to the site / any unauthorized changes are made in the installation of the system.

☐ *IMPROVEMENT PERMIT w / plat valid without expiration.* ☒ *IMPROVEMENT PERMIT w / site plan valid for 60 mos.* ☒ *AUTHORIZATION TO CONSTRUCT valid for period equal to IMPROVEMENT PERMIT-not to exceed 60 mo.*

Owner / Applicant Signature: Matthew R McMullen Date 7-8-10

Improvement Permit by: RCH Date 7-7-10

Authorization to Construct by: RCH Date 7-29-10

Installed by: Willie Christensberry

Operation Permit by: RCH Date: 11

Existing System Inspected by: Date:

YOU SHOULD CONTACT A LOCATOR SERVICE PRIOR TO ANY EXCAVATION.

WHITE COPY Environmental Health YELLOW COPY (Final) Owner / Applicant PINK COPY (Initial) Owner