# IREDELL COUNTY HEALTH DEPARTMENT

STATESVILLE 704-878-5305 MOORESVILLE 704-664-5281

## IMPROVEMENT PERMIT / AUTHORIZATION TO CONSTRUCT / OPERATION PERMIT / EXISTING SYSTEM INSPECTION

PERMIT# 125142 PIN# 4636181696.007 4636-08-0892 DATE Feb 21, 2006

OWNER OR APPLICANT Dockside Development / GP Invest PHONE: Business 704-439-2029 Home

ADDRESS 17824 Statesville Rd, Suite 122, Cornelius N.C. 28031

LOCATION Brawley Sch Rd. TR Home immediately TL Beechtree Rd. ~1/4 mile TR Chestnut Bay Ln. At End

SUBDIVISION Beechtree Bay BLOCK / SECTION ______ LOT 7/7A LOT AREA .87Ac + SFE SITE CLASS. PS SFE DESIGN FLOW 480gpd L.T.A.R. .35 SFE 7A

Septic Tank: 1000 Gallons; STB 524 Date 2-24-07
Pump Tank: 1000 Gallons; PT 283 Date 3-16-07
Pump Make: Myers (Goulds) Model P102 WE20240 Serial No.
Nitrification Field: No. Fields 1 Square Feet 1050 Linear Feet 350
No Lines 5@70 Trench Width 36" Max Trench Bottom Depth 36" Gravel Depth N/A ☐ Gravity ☒ Pressure


☒ New System ☐ Repair ☐ Expansion System Type: I II (III) IV V VI
System Description: PM 25% Reduction
Repair System Description: LPP PBPS
Maintenance Agreement Required: ☐ Yes ☒ No initially

☒ House/Mod. Home ☐ Mobile Home ☐ Business ☐ Other
No. Bedrooms 4 No. Persons ___ No. Employees ___
Water Supply: ☒ Individual ☐ Public ☐ Community
☐ Slab ☐ Crawl Space ☒ Basement w/plumbing ☐ Basement wo/plumbing

Comments:/Conditions: Place septic & Pump tank behind terrace. maintain 100' between tanks & well, 50' from well to 760' line. May have tanks less than 100' from well but no less than 50' if proven water-tight

Comments:/Conditions: Installed EZ Flow
Drainfield Checked 4/18/07
Tanks Checked 4/23/07

INITIAL SITE SKETCH

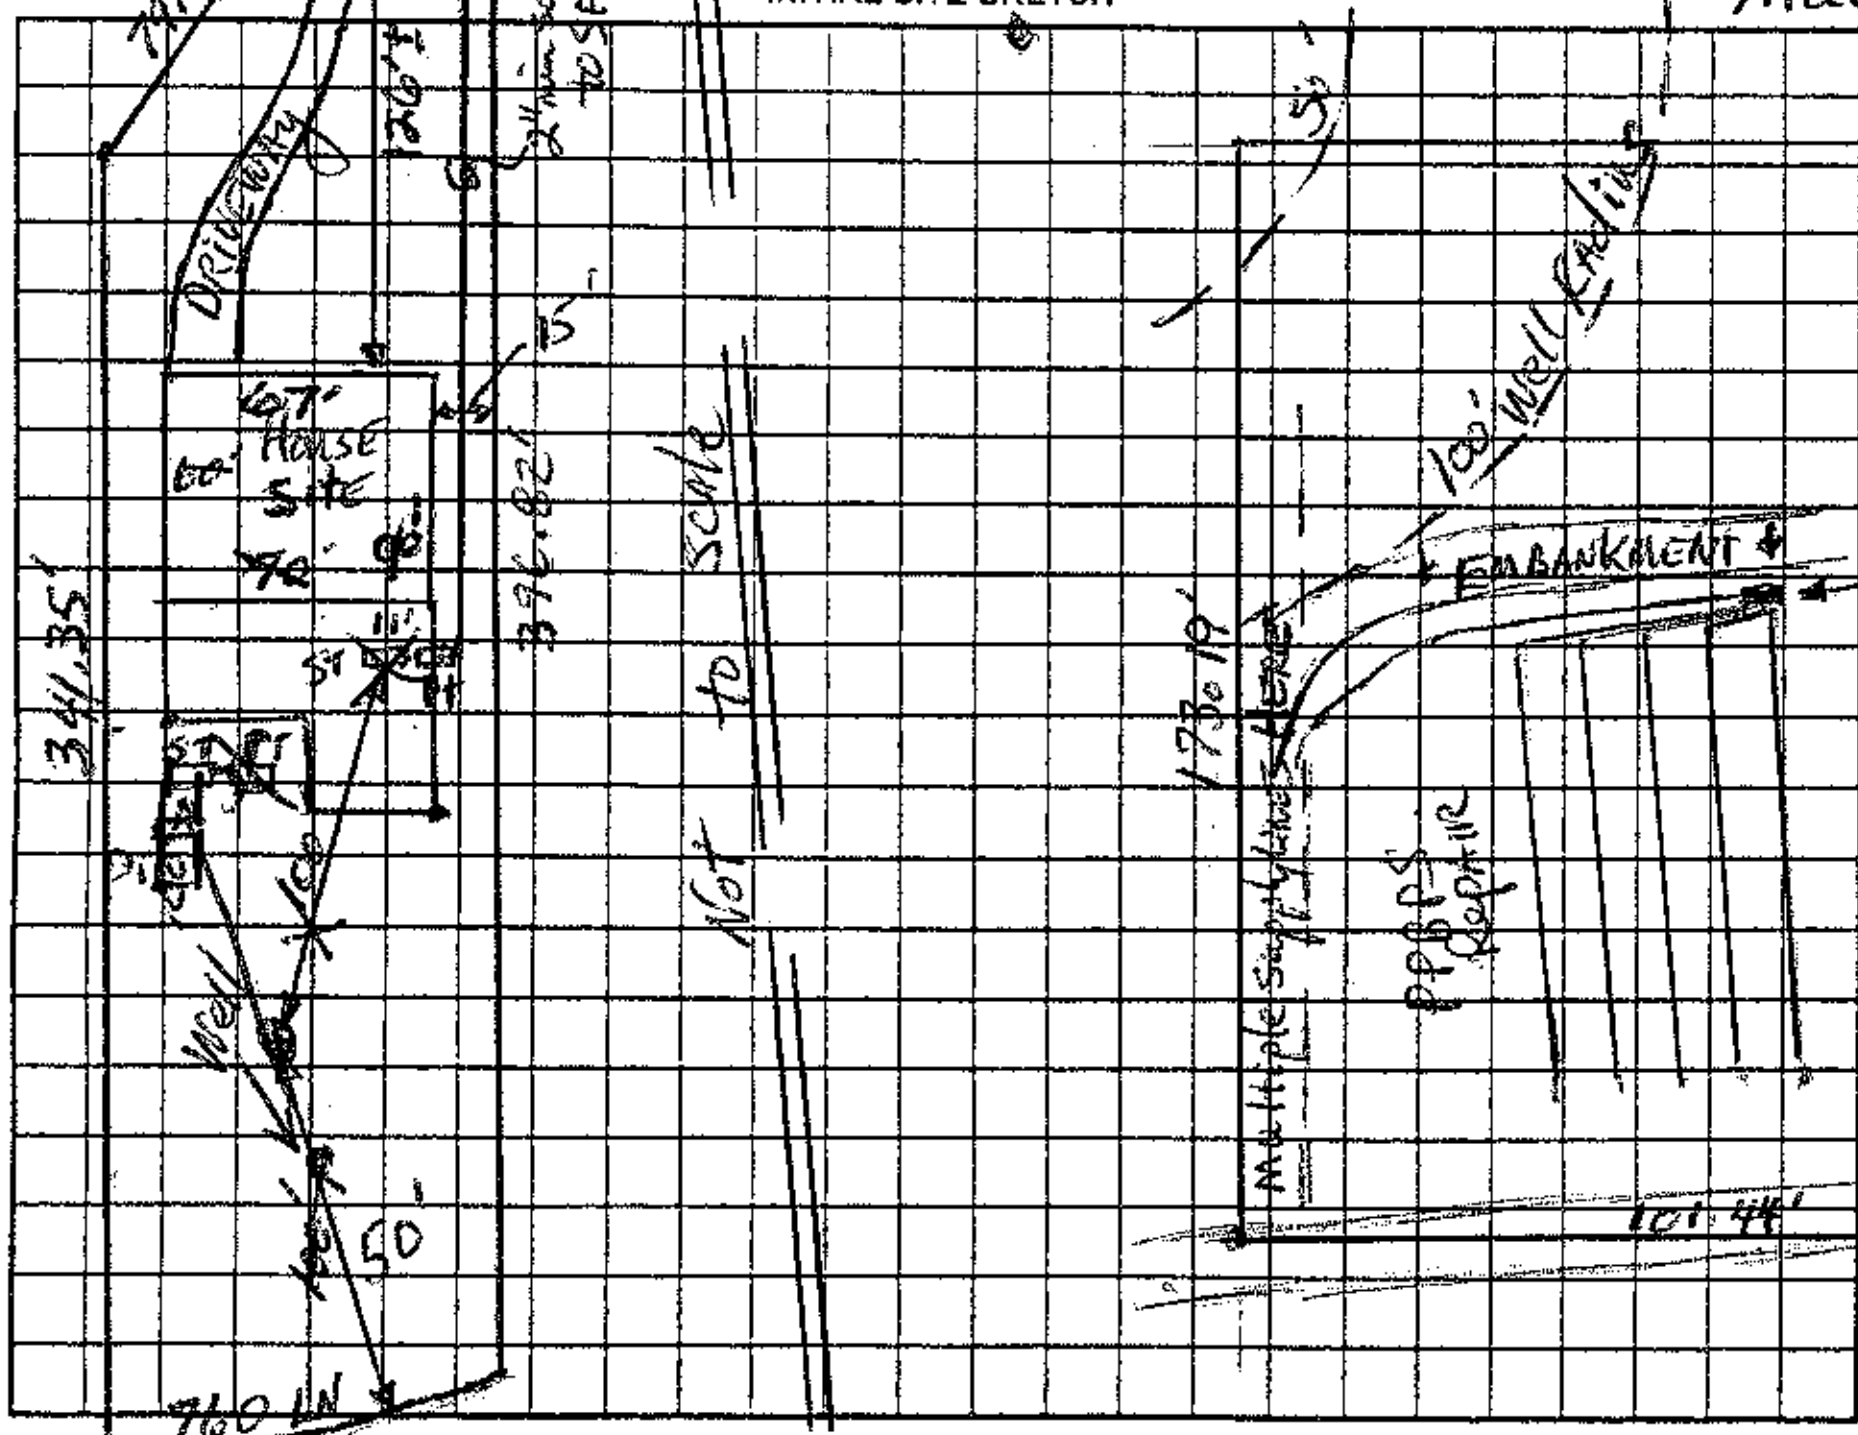


AS BUILT SKETCH

Permit can be suspended or revoked if any false information is supplied toward securing the permit/any unauthorized changes are made to the site/any unauthorized changes are made in the installation of the system. Improvement Permit with plat valid without expiration ☐ Improvement Permit with site plan valid for sixty months ☒ Authorization to Construct is valid for a period equal to that of Improvement Permit – not to exceed sixty months.

Signed: [signature] for Dockside Dev. date 3-24-06

Improvement Permit by: [signature] RS date 2-21-06

Authorization to Construct by: [signature] date 8-3-06

Installed by: [signature]

Operation Permit by: [signature] RS date 6/1/07

Existing System Inspection by: ______ date ______

HEALTH DEPT. COPY: WHITE OWNER COPY (FINAL): YELLOW OWNER COPY (INITIAL): PINK