2100

IREDELL COUNTY HEALTH DEPARTMENT

STATESVILLE 704-878-5305 MOORESVILLE 704-664-5281

IMPROVEMENT PERMIT / AUTHORIZATION TO CONSTRUCT / OPERATION PERMIT / EXISTING SYSTEM INSPECTION

PERMIT# 125136 PIN# 4636 18 1696 and 4636 08 4545 DATE Feb 20, 2006

OWNER OR APPLICANT Dockside Development / GRAYSON Builders PHONE: Business 704 439-2029 Home

ADDRESS 17824 Statesville Rd Suite 120 Cornelius, N.C. 28031

LOCATION Brawley Sub Rd. TR Blume, immediately TL Beechtree w/4 mile TR Chestnut Bay Ln. 3rd lot on left

SUBDIVISION Beechtree Bay BLOCK / SECTION LOT 3/3A LOT AREA ±93ac ± SFE SITE CLASS. PS SFE DESIGN FLOW 480gpd L.T.A.R. ±3 SFE 3A

Septic Tank: 1000 Gallons; STB 1000 Date 7-2-14

Pump Tank: 1000 Gallons; PT 2 Date 7-7-14

Pump Make: Myers Model P102 Serial No.

Nitrification Field: No Fields 1 Square Feet 540 Linear Feet 270

No Lines 4 Trench Width 24" min 36" max Trench Bottom Depth 36" Gravel Depth 12" ☐ Gravity ☒ Pressure

☒ New System ☐ Repair ☐ Expansion System Type: I II III IV V VI

System Description: LPPBDS

Repair System Description: LPPBDS

Maintenance Agreement Required: ☒ Yes ☐ No

☒ House/Mod. Home ☐ Mobile Home ☐ Business ☐ Other


No. Bedrooms 4 No. Persons No. Employees

Water Supply: ☒ Individual ☐ Public ☐ Community

☐ Slab ☐ Crawl Space ☒ Basement w/plumbing ☐ Basement wo/plumbing


Comments/Conditions: Properly fill open trench and eroded areas.

INITIAL SITE SKETCH

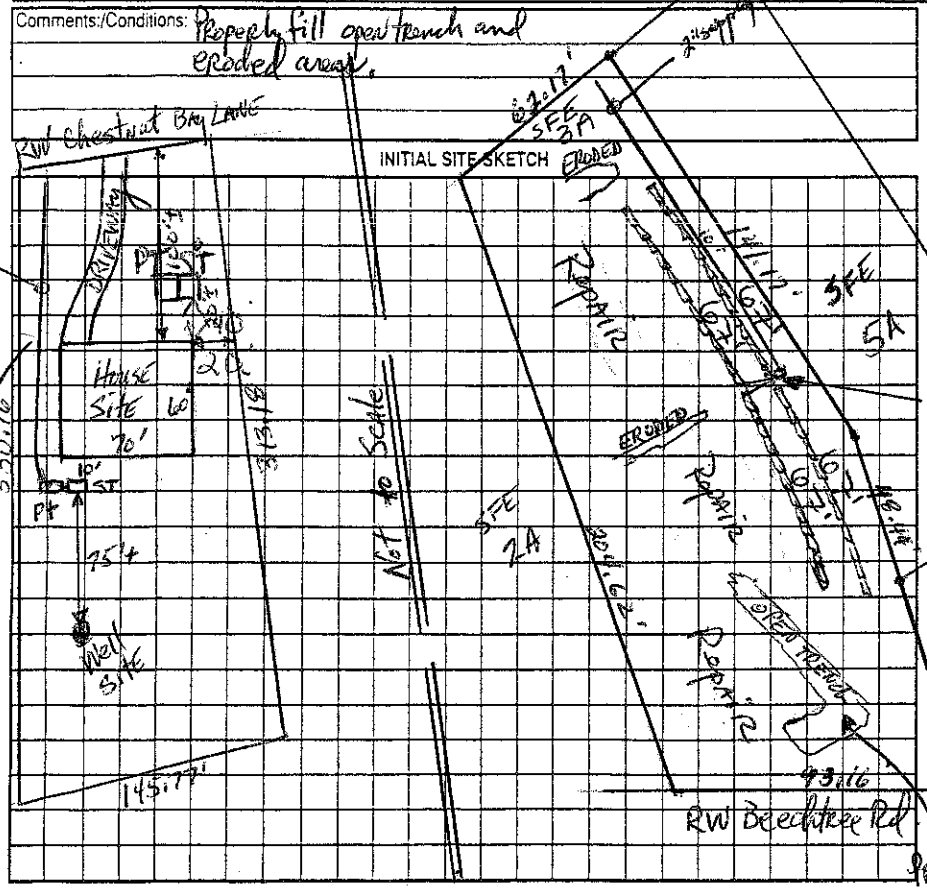

Comments/Conditions: 7/31/13 Reviewed Floor plans in compliance with original. House footprint bigger than house in Septic plan but drainfield in offsite

AS BUILT SKETCH

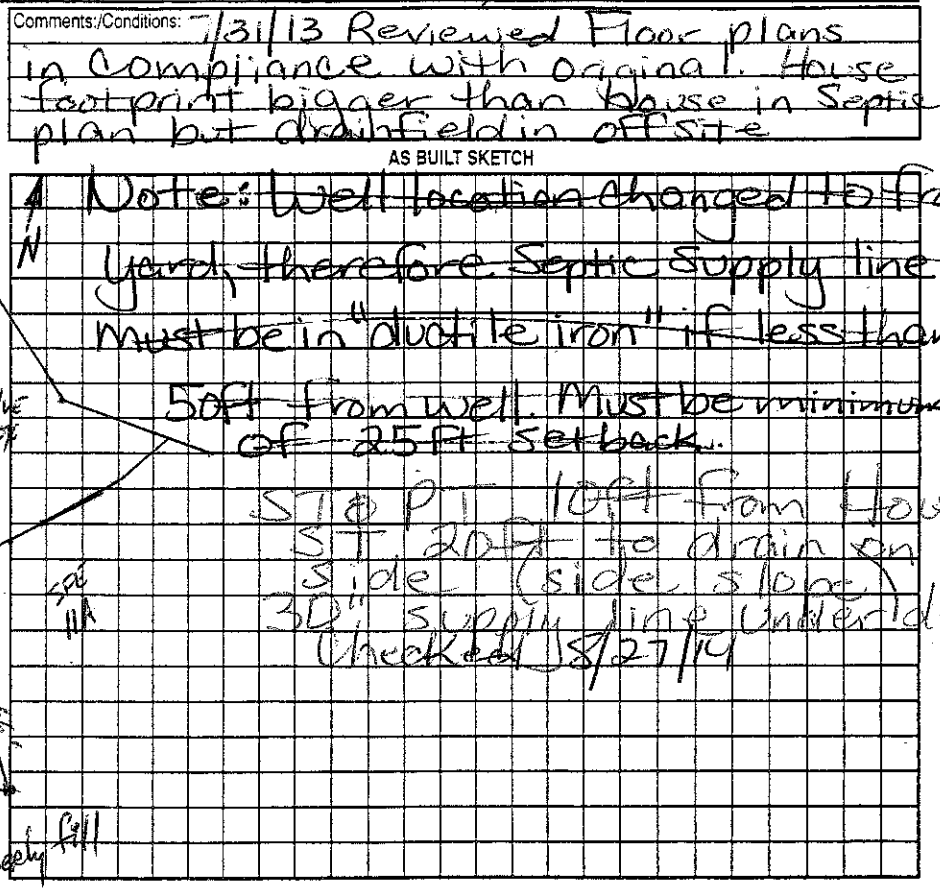

Permit can be suspended or revoked if any false information is supplied toward securing the permit/any unauthorized changes are made to the site/any unauthorized changes are made in the installation of the system. Improvement Permit with plat valid without expiration ☐ Improvement Permit with site plan valid for sixty months ☒ Authorization to Construct is valid for a period equal to that of Improvement Permit – not to exceed sixty months.

Signed: for Dockside Dev. date 3-24-06

Improvement Permit by: date 2-20-06

Authorization to Construct by: RS date 8/1/13

Installed by: date

Operation Permit by: RS date 10/8/14

Existing System Inspection by: date

HEALTH DEPT. COPY: WHITE OWNER COPY (FINAL): YELLOW OWNER COPY (INITIAL): PINK