3120

IREDELL COUNTY HEALTH DEPARTMENT

STATESVILLE 704-878-5305 MOORESVILLE 704-664-5281

IMPROVEMENT PERMIT / AUTHORIZATION TO CONSTRUCT / OPERATION PERMIT / EXISTING SYSTEM INSPECTION

PERMIT# 125145 PIN# 4636.18.1696.610 4636-084963 DATE 3-2-07

OWNER OR APPLICANT Zande Homes, Inc PHONE: Business 375-5999 Home

ADDRESS 909 East Blvd Charlotte, NC 28203

LOCATION Brawley School Rd TR Blume, immediately TL Beechtree Rd ~ 1/4 mile TR Chestnut Bay Ln at end on right

SUBDIVISION Beechtree Bay BLOCK / SECTION LOT 10/10A LOT AREA .69 +SFE SITE CLASS PS on SFE DESIGN FLOW 480gpd L.T.A.R. .3

Septic Tank: 1000 Gallons; STB 524 Date 3-8-05
Pump Tank: 1000 Gallons; PT 283 Date 1-21-07
Pump Make: Myers Model ME 50 Serial No.
Nitrification Field: No Fields 1 Square Feet 1200 Linear Feet 400
No Lines 3 @ 133' Trench Width 36" Max Trench Bottom Depth 36"

☒ New System ☐ Repair ☐ Expansion System Type: I II (III) IV V VI
System Description: Pump - 25% Reduction
Repair System Description: LP PPBPS
Maintenance Agreement Required: ☐ Yes ☒ No Not Initially

☒ House/Mod. Home No. Bedrooms 4
☐ Mobile Home No. Persons
☐ Business No. Employees
☐ Other


Water Supply: ☒ Individual ☐ Public ☐ Community

Gravel Depth N/A ☐ Gravity ☐ Pressure ☐ Slab ☒ Crawl Space ☐ Basement w/plumbing ☐ Basement wo/plumbing


Comments/Conditions: ~~X~~ Use "one piece" Septic tank

Comments/Conditions:

Scale 1:100 INITIAL SITE SKETCH

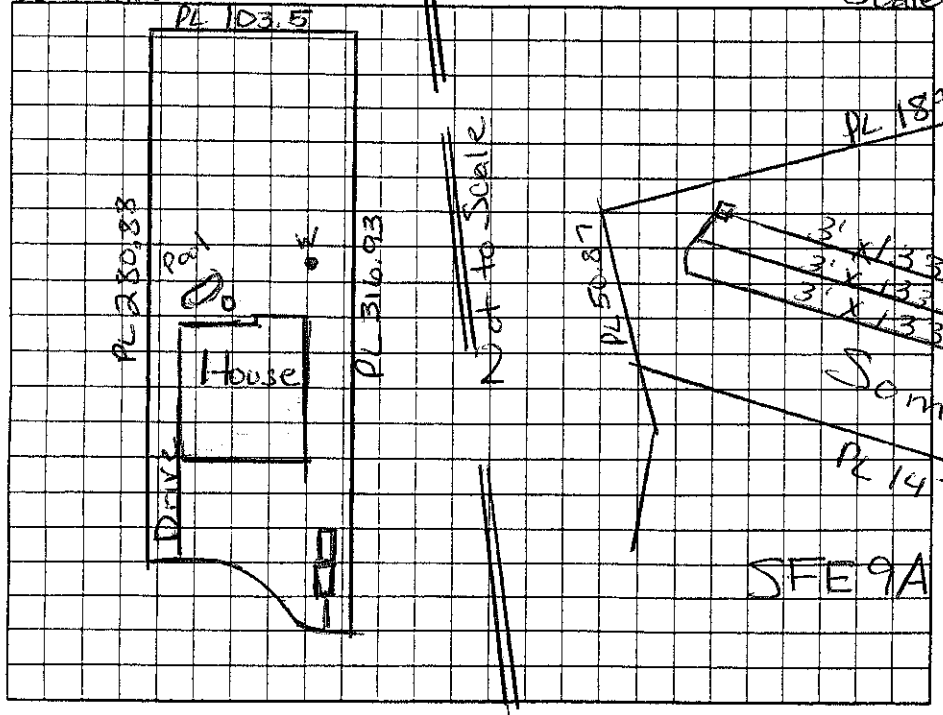

Scale 1:60 AS BUILT SKETCH

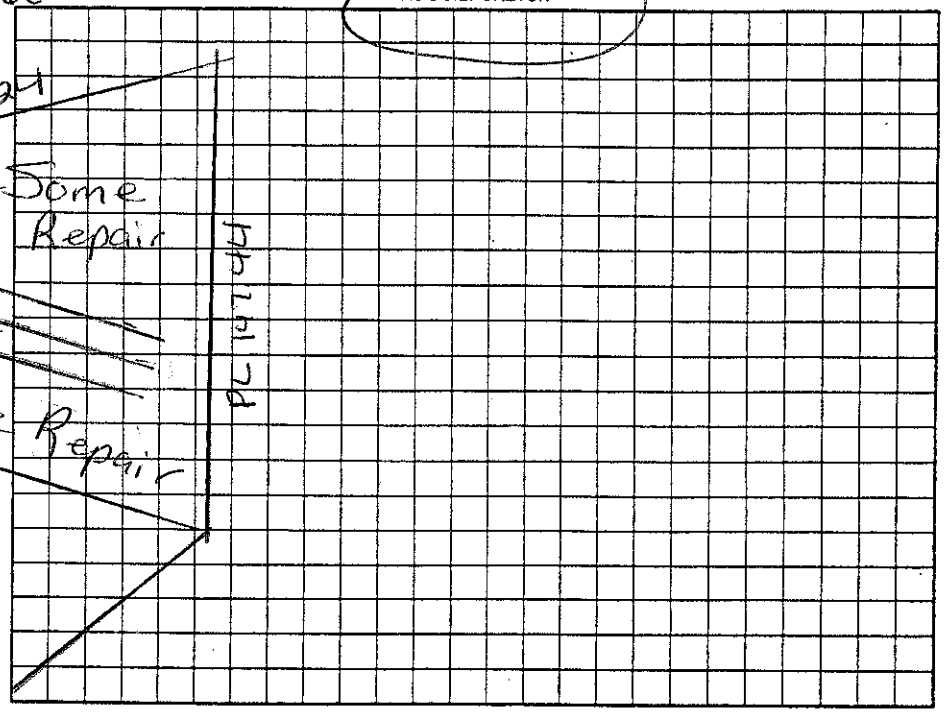

Permit can be suspended or revoked if any false information is supplied toward securing the permit/any unauthorized changes are made to the site/any unauthorized changes are made in the installation of the system. Improvement Permit with plat valid without expiration ☐ Improvement Permit with site plan valid for sixty months ☐ Authorization to Construct is valid for a period equal to that of Improvement Permit – not to exceed sixty months.

Signed: Laura J. Conley date 3/7/07

Improvement Permit by: Maria H. Dolgos RS date 3/2/07

Authorization to Construct by: Maria H. Dolgos RS date 3/2/07

Installed by: R&H Dolgos RS

Operation Permit by: Maria H. Dolgos date 3/30/07

Existing System Inspection by: date

HEALTH DEPT. COPY: WHITE OWNER COPY (FINAL): YELLOW OWNER COPY (INITIAL): PINK