2130

IREDELL COUNTY HEALTH DEPARTMENT

STATESVILLE 704-878-5305 MOORESVILLE 704-664-5281

IMPROVEMENT PERMIT / AUTHORIZATION TO CONSTRUCT / OPERATION PERMIT / EXISTING SYSTEM INSPECTION

PERMIT# 125146 PIN# 4636 18 1696.011 4636-08-5838 DATE Feb 22, 2006

OWNER OR APPLICANT Dockside Development / Zande PHONE: Business 704 439-2029 Home

ADDRESS 17824 Statesville Rd Suite 122 Cornelius, N.C. 28031

LOCATION Brawley School Rd. TR Blume immediately TL Beechtree Rd. ~¼ mile TR Chestnut Bay Lane, on Right near end

SUBDIVISION Beechtree Bay BLOCK / SECTION LOT 11/11A LOT AREA .72Ac+SFE SITE CLASS. PSSFE DESIGN FLOW 360 gpd L.T.A.R. .03 SFE 11A

Septic Tank: 1000 Gallons; STB 348 Date 11-5-07

Pump Tank: 1000 Gallons; PT 203 Date 12-22-07

Pump Make: Myers Model ME 75-21 Serial No.

Nitrification Field: No Fields 1 Square Feet 540 Linear Feet 270

No Lines 3@90'± Trench Width 24" Max Trench Bottom Depth 36"

☒ New System ☐ Repair ☐ Expansion System Type: I II III IV V VI

System Description: LPPPBPS

Repair System Description: LPPPBPS

Maintenance Agreement Required: ☒ Yes ☐ No

☒ House/Mod. Home No. Bedrooms 4

☐ Mobile Home No. Persons

☐ Business No. Employees

☐ Other

Water Supply: ☒ Individual ☐ Public ☐ Community


Gravel Depth N/A ☐ Gravity ☒ Pressure ☐ Slab ☒ Crawl Space ~~☐ Basement w/plumbing~~ ☐ Basement wo/plumbing

Comments/Conditions:


Comments/Conditions: 3/14/08 Checked lines installed as drawn

3/26/08 - Tanks moved to front of house to avoid adjacent well

INITIAL SITE SKETCH

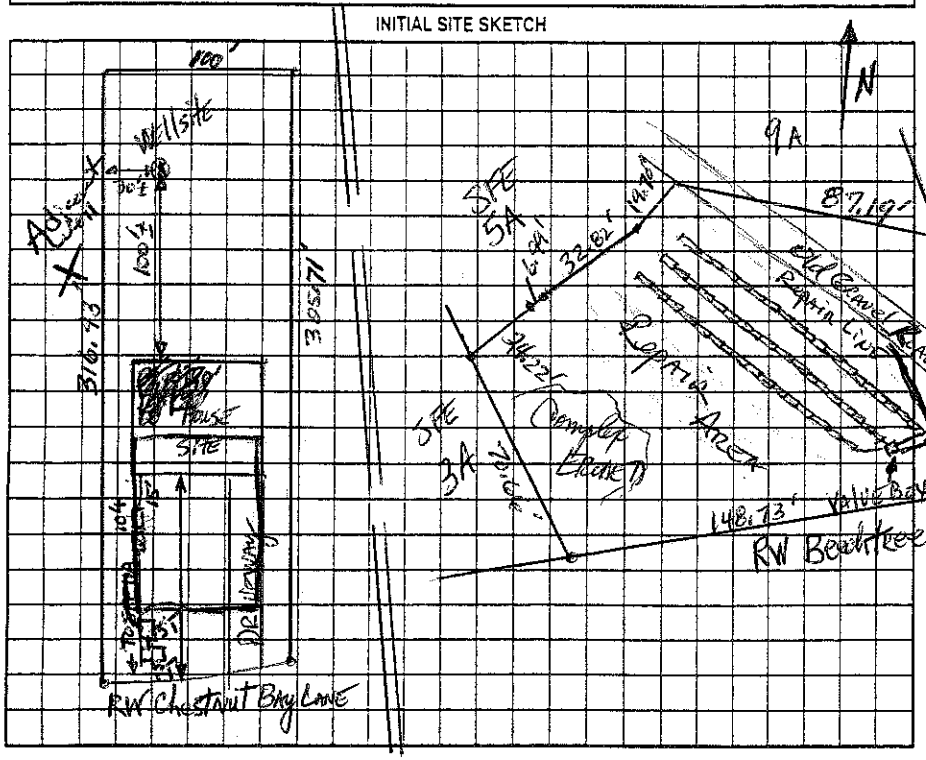

AS BUILT SKETCH

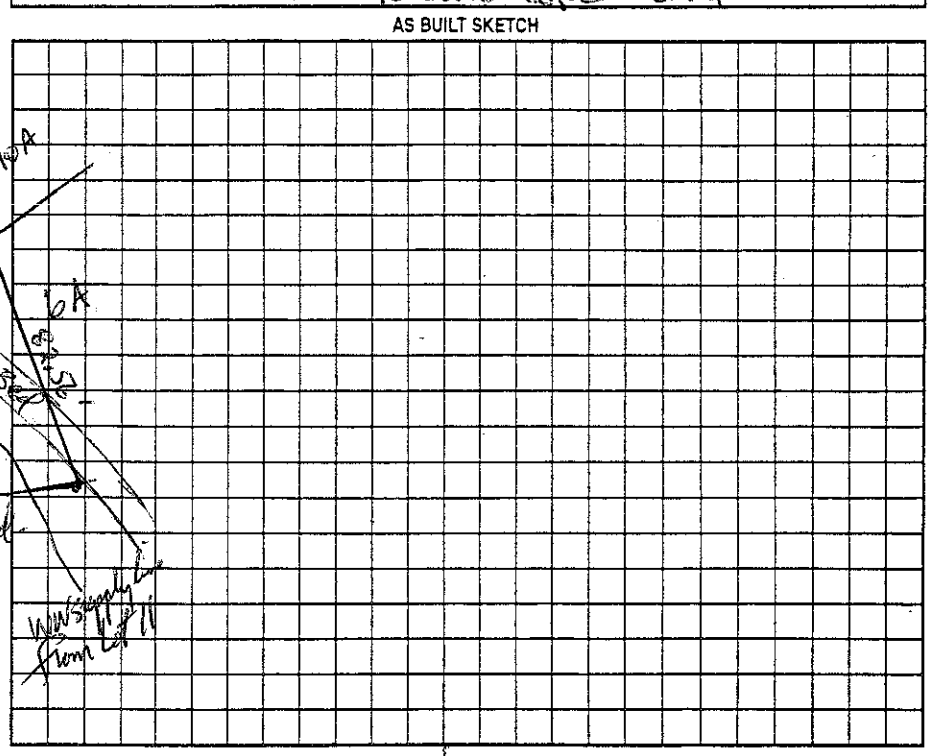

Permit can be suspended or revoked if any false information is supplied toward securing the permit/any unauthorized changes are made to the site/any unauthorized changes are made in the installation of the system. Improvement Permit with plat valid without expiration ☐ Improvement Permit with site plan valid for sixty months ☒ Authorization to Construct is valid for a period equal to that of Improvement Permit – not to exceed sixty months.

Signed John M. Klendinger for Dockside Dev date 3-24-06

Improvement Permit by: date 3-22-06

Authorization to Construct by: date 12-3-07

Installed by: R & H Dolan RS

Operation Permit by: Mark H Dolan date 5/15/08

Existing System Inspection by: date

HEALTH DEPT. COPY: WHITE OWNER COPY (FINAL): YELLOW OWNER COPY (INITIAL): PINK