IREDELL COUNTY HEALTH DEPARTMENT

STATESVILLE 704-878-5305 MOORESVILLE 704-664-5281

IMPROVEMENT PERMIT / AUTHORIZATION TO CONSTRUCT / OPERATION PERMIT / EXISTING SYSTEM INSPECTION

PERMIT# 12562 PIN# 4636186096.012 4636-08-6822 DATE 2-26-07

OWNER OR APPLICANT Zande Homes PHONE: Business 375-5999 Home

ADDRESS 8809 East Blvd Charlotte, NC 28203

LOCATION Brawley School Rd TR Blume immediately TL Beechtree Rd TR Chestnut Bay Ln on right

SUBDIVISION Beechtree Bay BLOCK / SECTION ~~12~~ LOT 12/12A LOT AREA .69Acre SITE CLASS PS DESIGN FLOW 480gpd L.T.A.R ~.25 SFE 12A

Septic Tank: 1000 Gallons: STB 312 Date 12-23-06
Pump Tank: 1000 Gallons: PT 238 Date 1-27-06
Pump Make: Myers Model P102 Serial No.
Nitrification Field: No. Fields 1 Square Feet 640 Linear Feet 320
No Lines 5 Trench Width 36" Max Trench Bottom Depth 36"

[X] New System [ ] Repair [ ] Expansion System Type: I II III IV V VI
System Description: Pump-Lp- Panel Block
Repair System Description: Same
Maintenance Agreement Required: [X] Yes [ ] No
Gravel Depth N/A [ ] Gravity [X] Pressure [ ] Slab [ ] Crawl Space [X] Basement w/plumbing [ ] Basement wo/plumbing


[X] House/Mod. Home No. Bedrooms 4
[ ] Mobile Home No. Persons
[ ] Business No. Employees
[ ] Other

Water Supply: [X] Individual [ ] Public [ ] Community


Comments:/Conditions: *Create shallow stormwater ditch Where Shown in SFA 12A Need slight Shaping here 10' 44'

Comments:/Conditions: *Replaces previous permit from Feb. 22, 2006. Pressleat alarm Checked 4/5/07

INITIAL SITE SKETCH

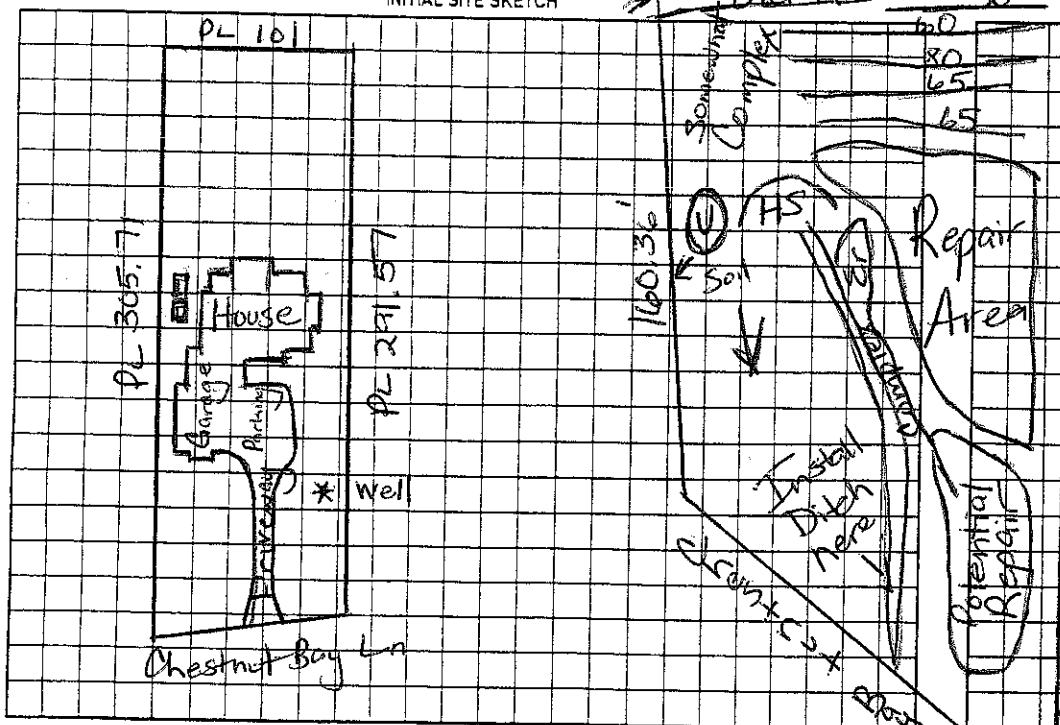

AS BUILT SKETCH

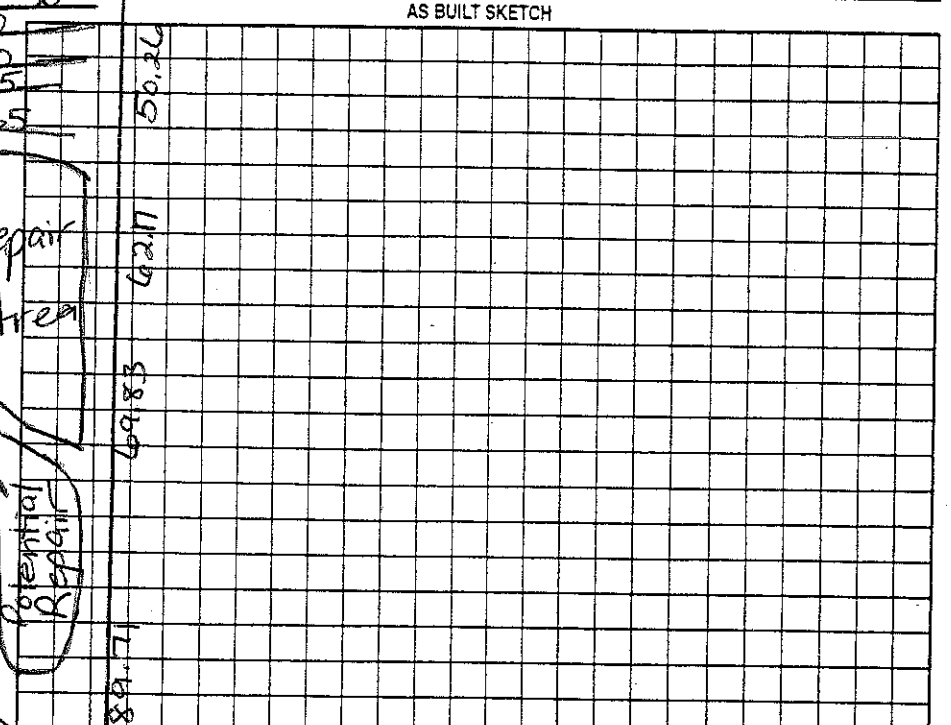

Permit can be suspended or revoked if any false information is supplied toward securing the permit/any unauthorized changes are made to the site/any unauthorized changes are made in the installation of the system. Improvement Permit with plat valid without expiration ☐ Improvement Permit with site plan valid for sixty months ☐ Authorization to Construct is valid for a period equal to that of Improvement Permit – not to exceed sixty months.

Signed: [signature] date 3-1-07

Improvement Permit by: Maria H. Dotson RS date 2/26/07

Authorization to Construct by: Maria H. Dotson RS date 2/26/07

Installed by: R&E date

Operation Permit by: Maria H. Dotson RS date 4/16/07

Existing System Inspection by: date

HEALTH DEPT. COPY: WHITE OWNER COPY (FINAL): YELLOW OWNER COPY (INITIAL): PINK