IREDELL COUNTY HEALTH DEPARTMENT

STATESVILLE 704-878-5305 — MOORESVILLE 704-664-5281

IMPROVEMENT PERMIT / AUTHORIZATION TO CONSTRUCT / OPERATION PERMIT / EXISTING SYSTEM INSPECTION

900.00 Paid

PERMIT# REPAIR PIN# 4627 90 7412.316 4636-09-0806 DATE 6/5/06

OWNER OR APPLICANT MIKE McLAUGHLIN PHONE: Business 704-799-7931 Home

ADDRESS 143 PALMER MARSH RD. MOORESVILLE, NC. 28117

LOCATION 1100 TR BLUME TL BEATEN PATH TL CICERO TL SHAVENDERS TL PALMER MARSH ON L

SUBDIVISION SHAVENDERS ~~BUILDING~~ SECTION 3 LOT 316 LOT AREA SITE CLASS. RS DESIGN FLOW 480 L.T.A.R. .3

Septic Tank: 1000 Gallons: STB Date

Pump Tank: 1000 Gallons: PT Samco Date for

Pump Make: Goulds Model WE0.5I2 Serial No.

Nitrification Field: No Fields 1 Square Feet 1200 Linear Feet 400

No Lines 4 Trench Width 3 Max Trench Bottom Depth 3

☐ New System ☒ Repair ☐ Expansion System Type: I II III IV V VI

System Description: ~~PM-25%~~

Repair System Description: PM - 25% Reduced

Maintenance Agreement Required: ☐ Yes ☒ No

☒ House/Mod. Home ☐ Mobile Home ☐ Business ☐ Other


No. Bedrooms 4 No. Persons 4 No. Employees

Water Supply: ☒ Individual ☐ Public ☐ Community

Gravel Depth No ☐ Gravity ☐ Pressure ☐ Slab ☐ Crawl Space ☒ Basement w/plumbing ☐ Basement wo/plumbing


Comments:/Conditions: 218

INITIAL SITE SKETCH

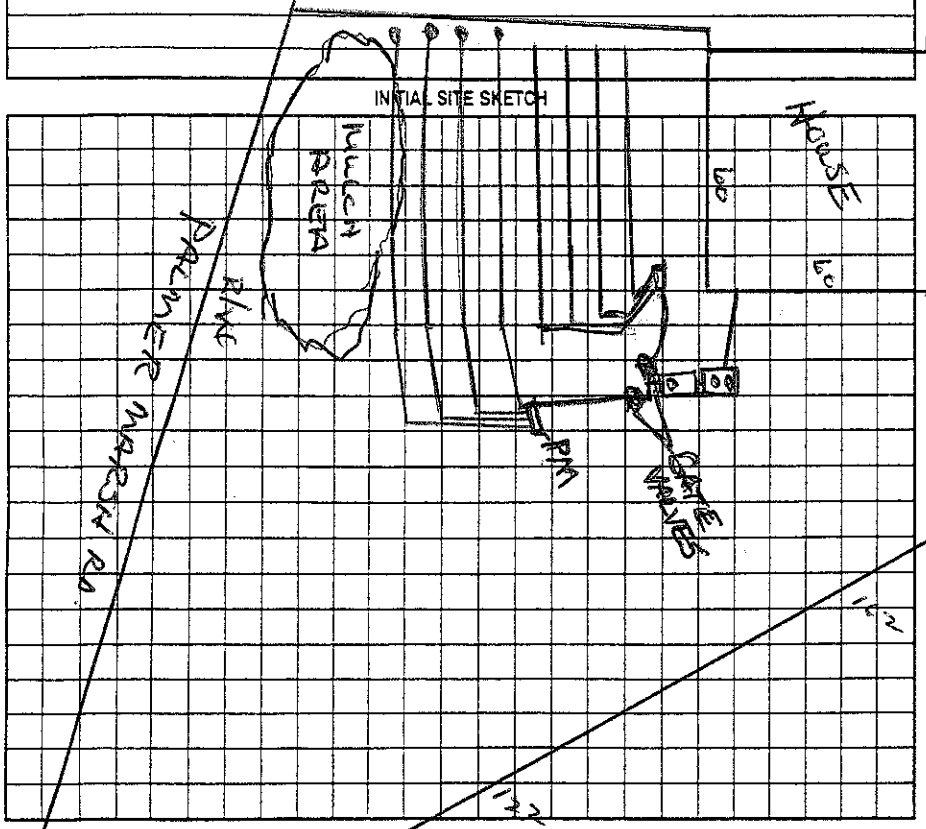

Comments:/Conditions: 90

AS BUILT SKETCH

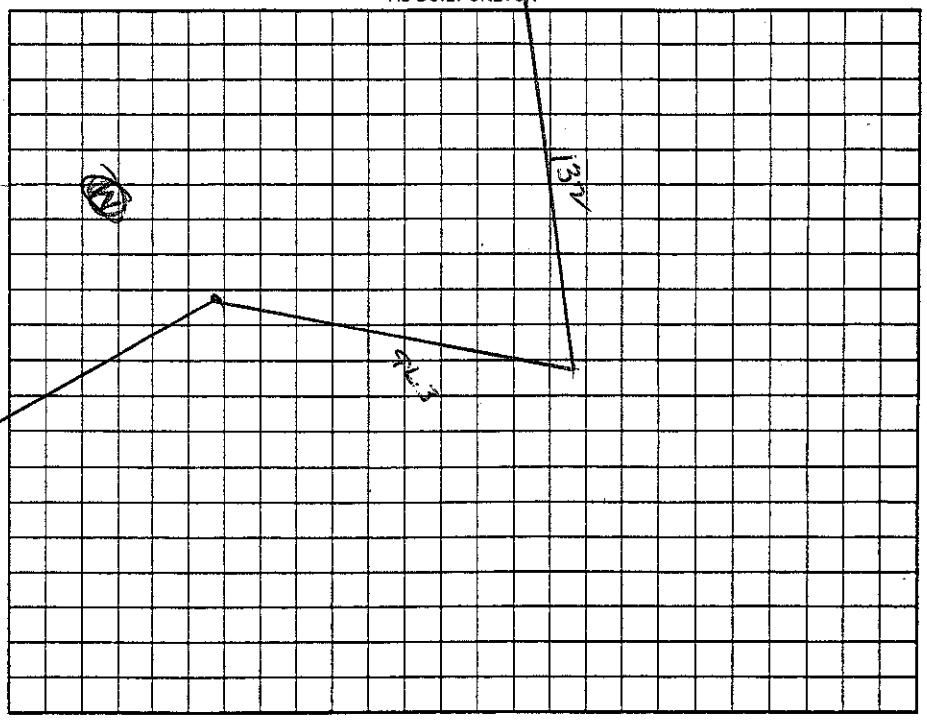

Permit can be suspended or revoked if any false information is supplied toward securing the permit/any unauthorized changes are made to the site/any unauthorized changes are made in the installation of the system. Improvement Permit with plat valid without expiration ☐ Improvement Permit with site plan valid for sixty months ☐ Authorization to Construct is valid for a period equal to that of Improvement Permit -- not to exceed sixty months.

Signed: X date 6/8/06

Improvement Permit by: Wesley Sparks RS date 6/5/06

Authorization to Construct by: Wesley Sparks RS date 6/5/06

Installed by: A+S

Operation Permit by: Wesley Sparks RS date 6/12/06

Existing System Inspection by: date

HEALTH DEPT. COPY: WHITE OWNER COPY (FINAL): YELLOW OWNER COPY (INITIAL): PINK