
Acknowledgement Of
Plans Submittal ONLY!

Date 2/18/05

Date 2/18/05

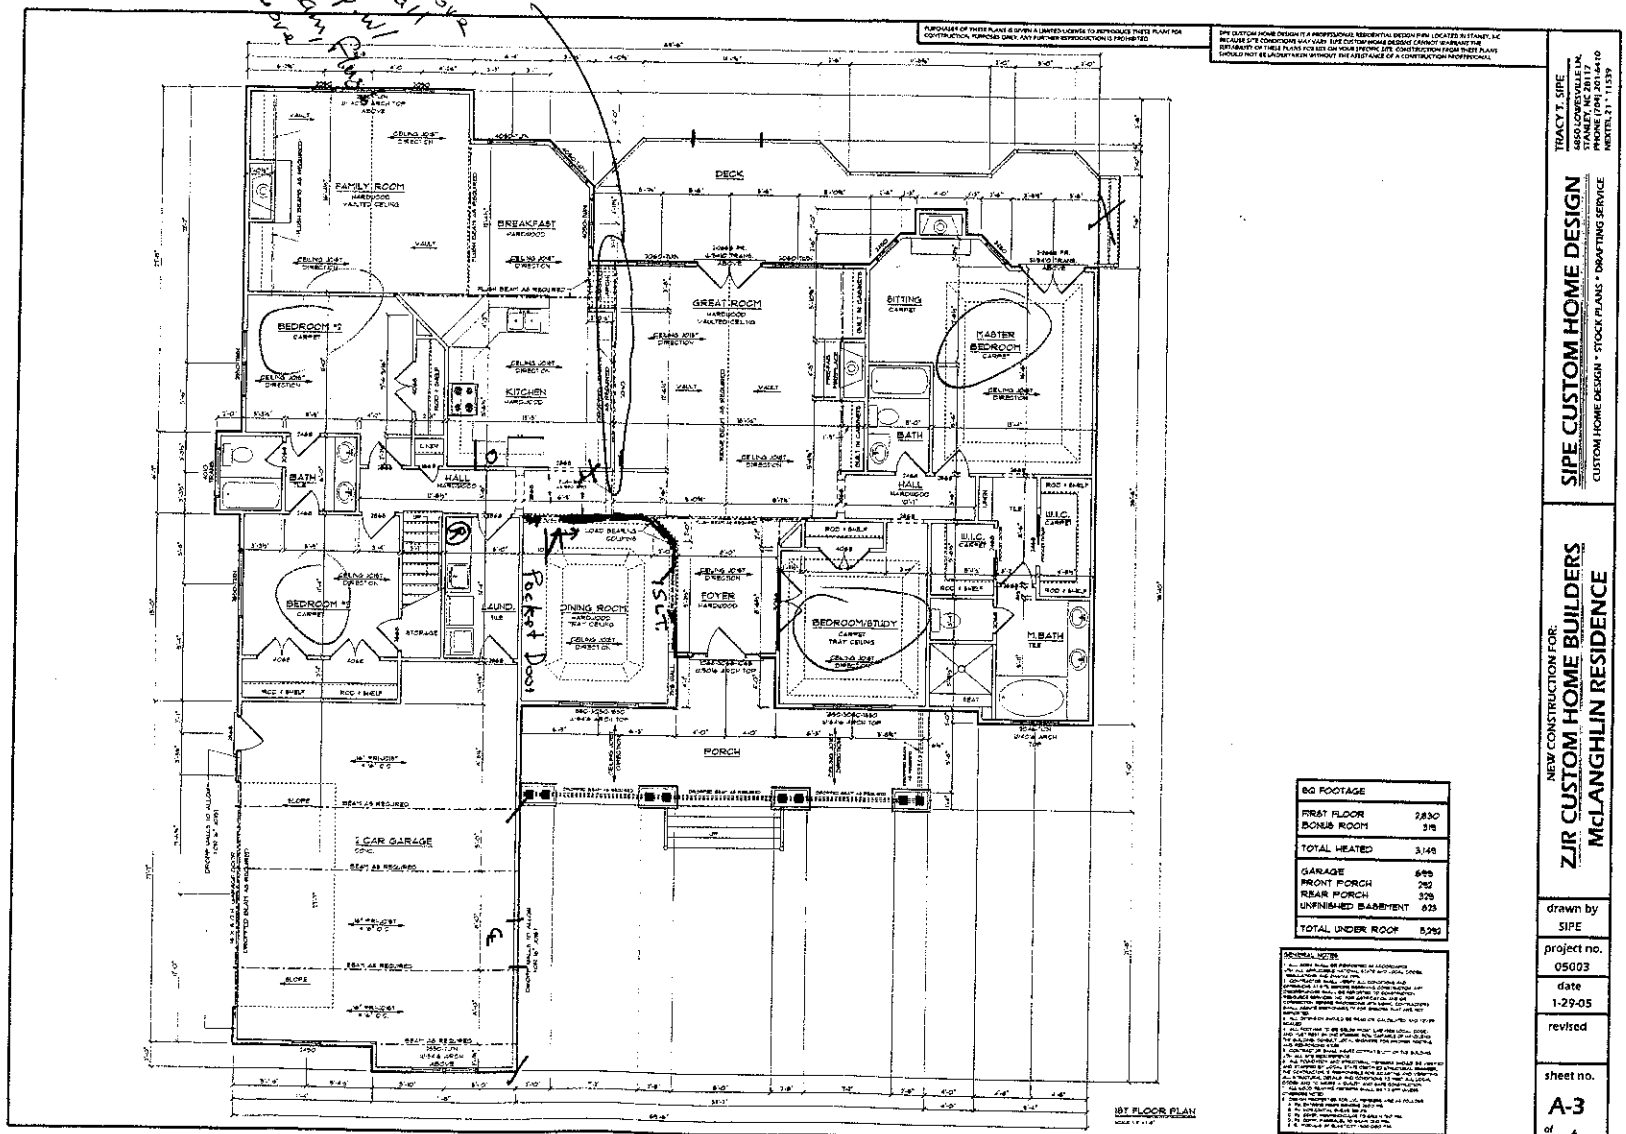

SQ FOOTAGE	
FIRST FLOOR	2,830
BONUS ROOM	318
TOTAL HEATED	3,148
GARAGE	668
FRONT PORCH	282
REAR PORCH	378
UNFINISHED BASEMENT	823
TOTAL UNDER ROOF	5,299

GENERAL NOTES

1. ALL WORK SHALL BE PERFORMED IN ACCORDANCE WITH THE 2003 NORTH CAROLINA STATE AND LOCAL CODES.
2. CONTRACTOR SHALL VERIFY ALL CONDITIONS AND DIMENSIONS AT JOB SITE AND SHALL NOTIFY SIPE CUSTOM HOME DESIGN OF ANY DISCREPANCIES BEFORE PROCEEDING WITH CONSTRUCTION. CONTRACTOR SHALL COORDINATE ALL WORK WITH ALL OTHER TRADES.

PURCHASER OF THESE PLANS IS GIVEN A LIMITED LICENSE TO REPRODUCE THESE PLANS FOR CONSTRUCTION PURPOSES ONLY. ANY FURTHER REPRODUCTION IS PROHIBITED.

SIPE CUSTOM HOME DESIGN IS A PROFESSIONAL RESIDENTIAL DESIGN FIRM LOCATED IN STANLEY, NC BECAUSE SITE CONDITIONS MAY VARY, SIPE CUSTOM HOME DESIGN CANNOT WARRANT THE SUITABILITY OF THESE PLANS FOR USE ON YOUR SPECIFIC SITE. CONSTRUCTION FROM THESE PLANS SHOULD NOT BE UNDERTAKEN WITHOUT THE ASSISTANCE OF A CONSTRUCTION PROFESSIONAL

TRACY T. SIPE
6850 LOWESVILLE RD.
STANLEY, NC 28164
PHONE (704) 263-6410
MOBILE (704) 913-1539

SIPE CUSTOM HOME DESIGN
CUSTOM HOME DESIGN * STOCK PLANS * DRAFTING SERVICE

NEW CONSTRUCTION FOR:
ZJR CUSTOM HOME BUILDERS
McLANGHLIN RESIDENCE

drawn by	SIPE
project no.	05003
date	1-29-05
revised	
sheet no.	A-3 of 6