IREDELL COUNTY HEALTH DEPARTMENT

STATESVILLE 704-878-5305 MOORESVILLE 704-664-5281

IMPROVEMENT PERMIT / ~~CERTIFICATE OF COMPLETION~~ / OPERATION PERMIT / EXISTING SYSTEM INSPECTION

Authorization to Construct

PROPERTY DESCRIPTION NO. 23453 DATE 4/1/96 TAX MAP NO. 2G-23-12 4636 10 2034 Watershed: [X] Yes [ ] No

OWNER OR CONTRACTOR Robert Wynn Homes PHONE: Business 391-3715 Home

ADDRESS 2900 B I 85 Service Rd. S Charlotte, NC. ~~28208~~ 28211

LOCATION Wynwood Lane - Brawley Sch TL Old Pines TR Cove Creek Rd. TL Wynwood Apt TL Wynwood ~500' on (L)

SUBDIVISION North Shore BLOCK (SECTION) II PH1 LOT 12 LOT AREA ~ .96 AC. SITE CLASS. PS DESIGN FLOW 360 L.T.A.R. 3

Septic Tank: 1000 Gallons; STB 794 Date 9/22/95

Pump Tank: 1000 Gallons; PT 27 Date 7/19/96

Pump Make: ZOELLER Model E-165C Serial No.

Nitrification Field: No Fields 1 Square Feet 1200 Linear Feet 400

No Lines 5 Trench Width 36" Max Trench Bottom Depth 36" Gravel Depth 12"

[X] New System [ ] Repair System Type: I, II, III, IV, V, VI

System Description: Pressure Manifold ~~Conventional~~ CH PLASTIC

Repair System Description: Same

Maintenance Agreement Required: [ ] Yes [X] No

[X] House/Mod. Home [ ] Mobile Home [ ] Business [ ] Other

No. Bedrooms 3 No. Bathrooms 2.5 No. Employees


[ ] Slab [X] Crawl Space [ ] Basement w/plumbing [ ] Basement wo/plumbing

Water Supply: [ ] Individual [X] Community [ ] Public


Comments:

Comments:

INITIAL SITE SKETCH

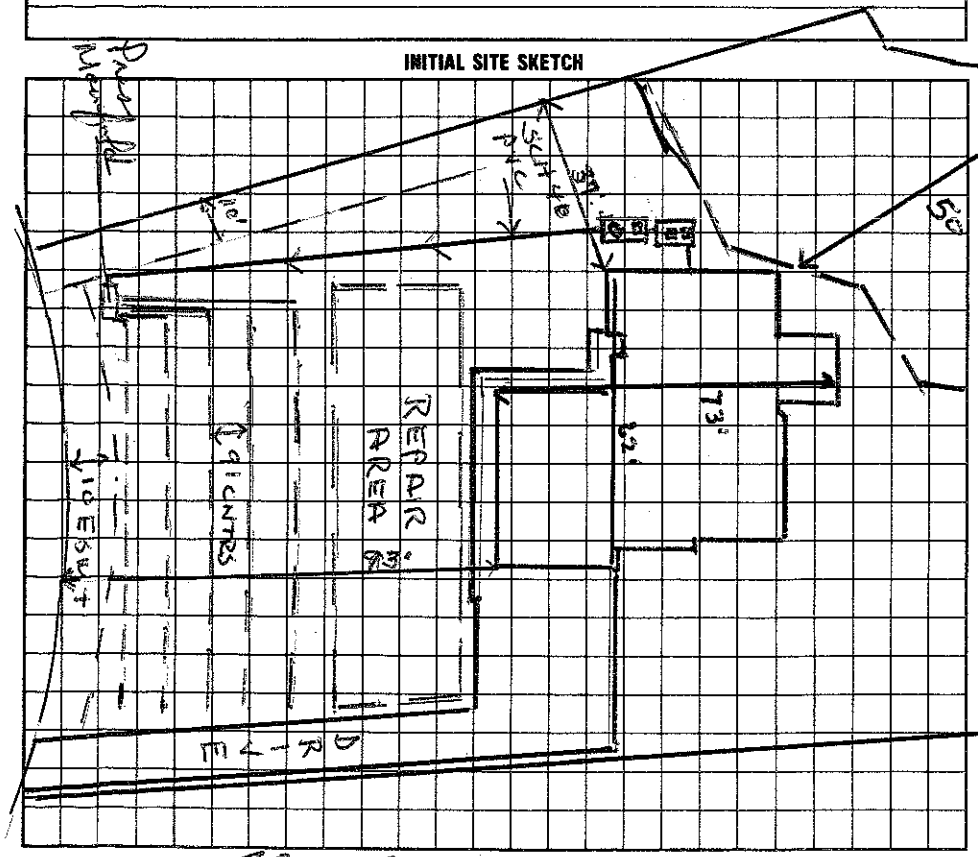

AS BUILT SKETCH

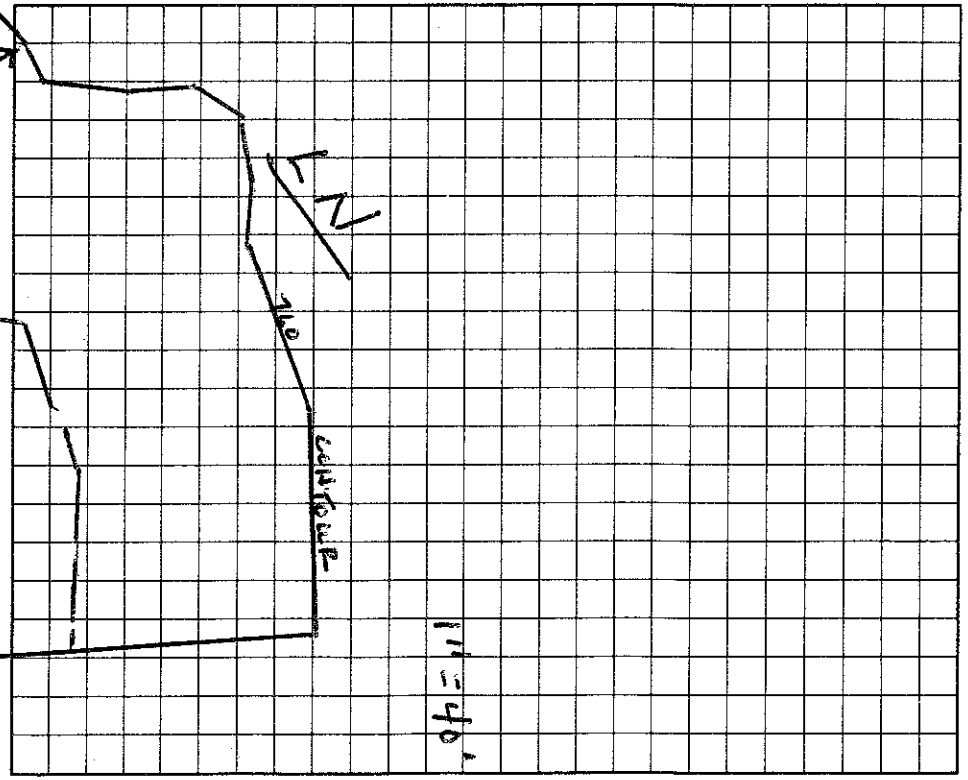

I understand that this permit can be suspended or revoked if any false information is supplied toward securing the permit/any unauthorized changes are made to the site/any unauthorized changes are made in the installation of the system.

Authorization to construct valid 5 years.

Signed:

Improvement Permit by: Wesley Sparks, RS. date 4/1/96

Existing System Inspection by: Authorization to Construct Wesley Sparks RS date 4/1/96

Installed by: Don Howe Grading

Certificate of Completion by: date

Operation Permit by: Wesley Sparks RS. date 11/7/96

HEALTH DEPT. COPY: WHITE INSPECTION COPY (FINAL): GREEN OWNER COPY (FINAL): YELLOW INSPECTION COPY (INITIAL): PINK OWNER COPY (INITIAL): GOLD