IREDELL COUNTY HEALTH DEPARTMENT

Statesville Office (704) 878-5305 Mooresville Office (704) 660-3625

IMPROVEMENT PERMIT / AUTHORIZATION TO CONSTRUCT / OPERATION PERMIT / EXISTING SYSTEM

Repair PERMIT # 203358

PIN # 4636102787

APPLICANT: Jarrid Lentz / Hans Richle APPLICANT ADDRESS:

SITE ADDRESS: 136 Wynsinkept Dr. Mooresville, NC PHONE: 704 902-4602 ALT. PHONE:

SITE DIRECTIONS: Brawley School Rd TL Isle of Pines

SUBDIVISION: Northshore II SECTION: II LOT # 51 LOT AREA: DESIGN FLOW: 480 gpd W.T.A.R.: .3

Septic Tank 1000 (gal) STB Infi Hunter IM-1060 Date

Pump Tank (gal) PT Date

Pump Make Model Serial #

Nitrification Fields 1 # Lines 5 Linear Ft: 270'

Trench Width 24" Max. Trench Bottom Depth 30-36" Gravel Depth N/A

☐ New System ☒ Repair ☐ Expansion System Type: I II III IV V VI

System Description: ~~Pump-LP-Panel Block~~ Same

Repair System Description:

Maintenance Agreement Required: ☐ YES ☐ NO ☐ GRAVITY ☐ PRESSURE

☒ Residence ☐ Business ☐ Other ☐ Slab ☒ Crawl Space ☐ Basement w/ plumbing

No. Bedrooms 4 No. Persons 8 No. Employees


Water Supply: ☐ Private ☐ Public ☒ Community ☐ Basement w/o plumbing

Existing

Comments / Conditions: ~~Install New ST only and hook onto Existing PT and Drainfield.~~ ~~Must reset pressure to Drainfield~~

~~Must have Current Contract with OSIWW Certified Operator for Septic System Maintenance prior to Operation permit being Approved~~


INITIAL SITE SKETCH

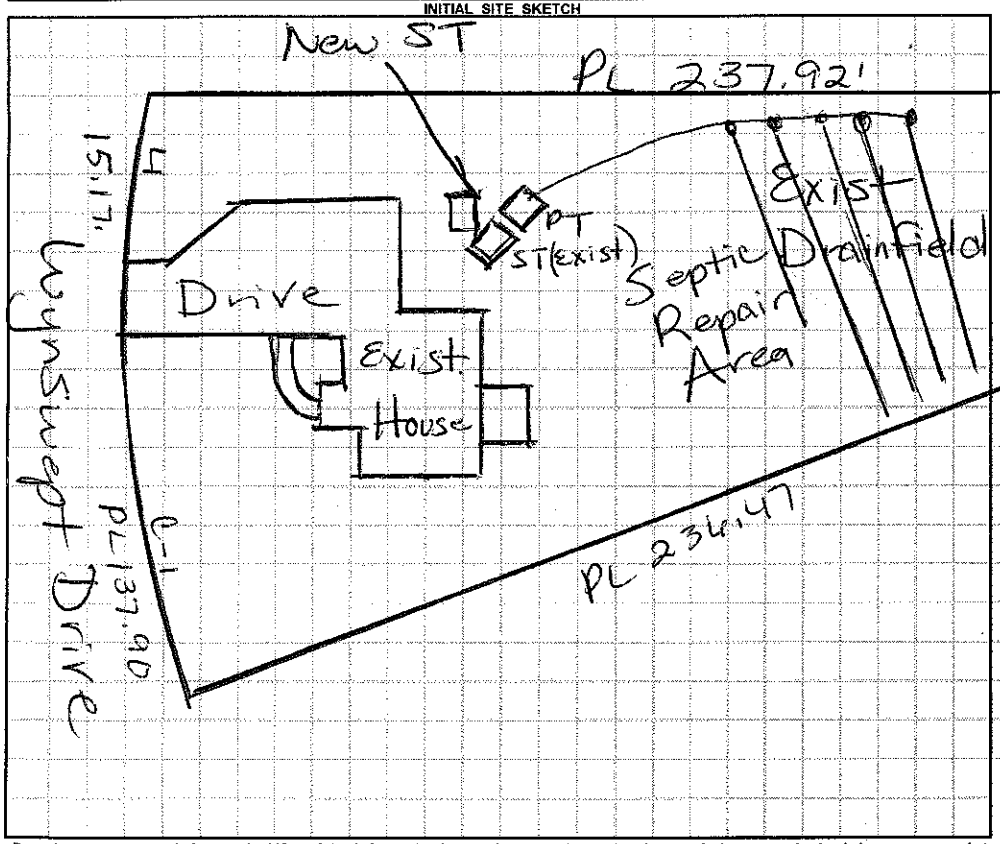

AS BUILT SKETCH

Scale 1:50

7/28/16: Plastic Tank w/ a Tuff-tite EF4 Effluent Filter

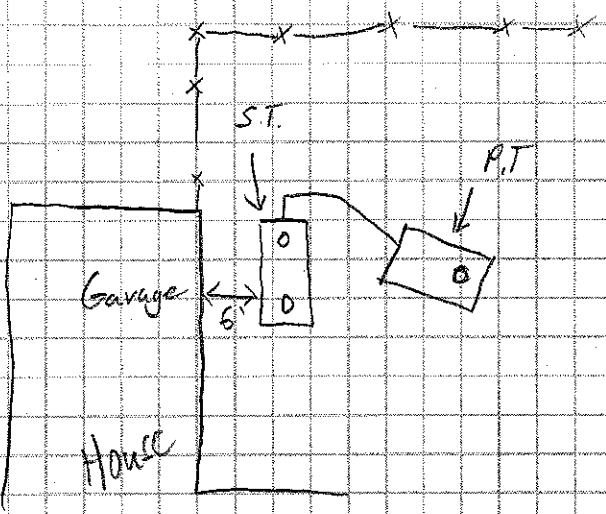

Permit can be suspended or revoked if any false information is supplied toward securing the permit / any unauthorized changes are made to the site / any unauthorized changes are made in the installation of the system. **CONTACT A LOCATOR SERVICE PRIOR TO ANY EXCAVATION**

☐ **IMPROVEMENT PERMIT** *with plat valid without expiration.* ☒ **IMPROVEMENT PERMIT** *with site plan valid for 60 mos.* ☒ **AUTHORIZATION TO CONSTRUCT** *valid for period equal to IMPROVEMENT PERMIT--not to exceed 60 mo.*

Owner / Applicant Signature: Date: 6-18-14 Installed by: Jarrid Lentz

IMPROVEMENT PERMIT by: Date: 6/16/14 OPERATION PERMIT by: Date: 7-28-16

AUTHORIZATION TO CONSTRUCT by: Date: 6/16/14 Existing System Inspected by: Date:

Health Dept. Copy - WHITE Applicant (Final Approval) - YELLOW Applicant (Conditional Approval) - PINK