IREDELL COUNTY HEALTH DEPARTMENT

STATESVILLE 704-878-5305 MOORESVILLE 704-664-5281

IMPROVEMENT PERMIT / CERTIFICATE OF COMPLETION / OPERATION PERMIT / EXISTING SYSTEM INSPECTION

PROPERTY DESCRIPTION NO. 16163 DATE August 19, 93 4636-10-~~0662~~ TAX MAP NO. part of 2FB10

OWNER OR CONTRACTOR Robert Clapshaw Homes PHONE: Business 391-3715 2787 Home

ADDRESS

LOCATION 1100 TL 1113 TR Cove Creek Rd. TL Wynswept Dr. on Right

SUBDIVISION North Shore BLOCK / SECTION F LOT 51 LOT AREA 20,000 ft²+ SITE CLASS. PS per 1958 L.T.A.R. .3

Water Supply: ☐ Individual ☑ Community ☐ Public Goulds WE0511A ½HP

Septic Tank: 1500 Gallons; STB 797 Date 6-6-93

Pump Tank: 1500 Gallons; PT 797 Date 6-21-93

Nitrification Field: No Fields ____ Square Feet ____ Linear Feet 270

No Lines 5 Trench Width 24" Trench Depth 30-36" Gravel Depth NA

☑ New System ☐ Repair System Type: I, II, II, (IV) V, VI

System Description: LP PRBPS

Repair System Description: SAME

Maintenance Agreement Required: ☑ Yes ☐ No

☑ House/Mod. Home ☐ Mobile Home ☐ Business ☐ Other

No. Bedrooms 4 No. Bathrooms 2 No. Employees ____

☐ Slab ☑ Crawl Space ☐ Basement w/plumbing ☐ Basement wo/plumbing

Garbage Disposal: ☑ Yes ☐ No

Auto. Dishwasher: ☑ Yes ☐ No

Auto. Washing Machine: ☑ Yes ☐ No


Other ____

Comments ____

INITIAL SITE SKETCH

Install 2 New Tanks 5' from addition 10' from PL

AS BUILT SKETCH

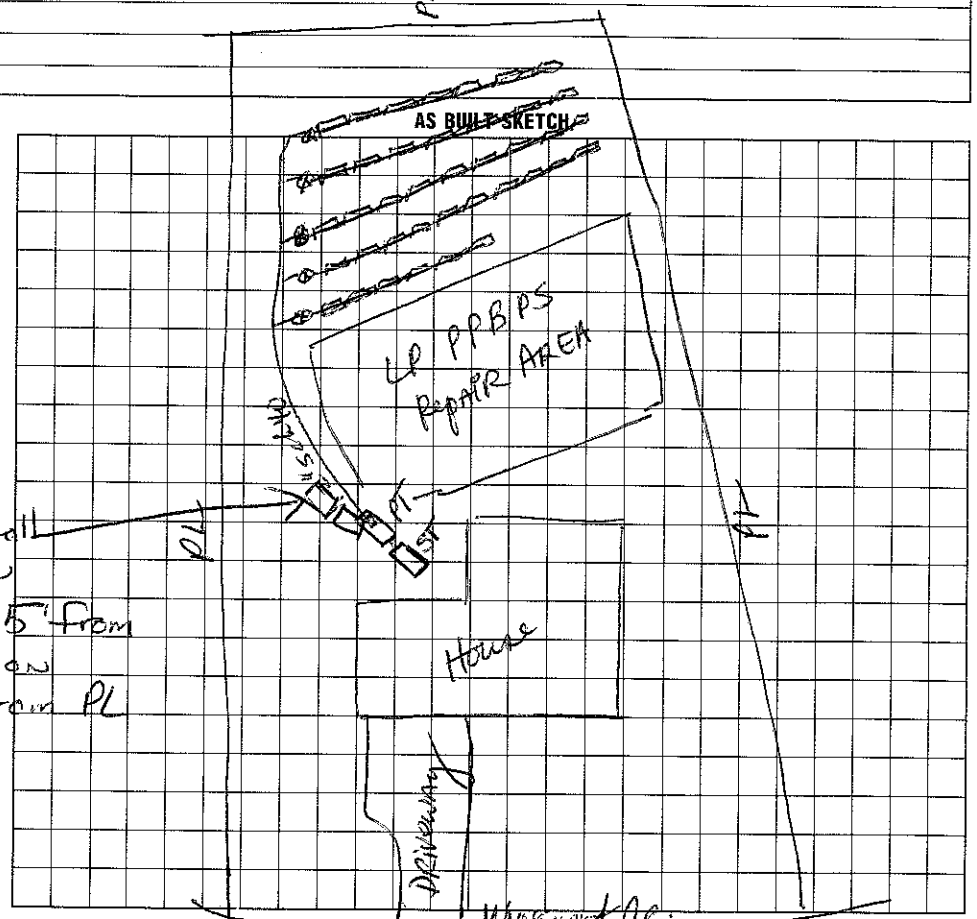

I understand that this permit can be suspended or revoked if any false information is supplied toward securing the permit/any unauthorized changes are made to the site/any unauthorized changes are made in the installation of the system. Improvement Permit is valid for 60 months from date of issuance.

Signed: ____

Improvement Permit by: [signature] date ____

Existing System Inspection by: ____ date ____

Installed by: Iron Horse Grading (8-19-93)

Certificate of Completion by: ____ date ____

Operation Permit by: [signature] date 9/10/93

HEALTH DEPT. COPY: WHITE INSPECTION COPY (FINAL): GREEN OWNER COPY (FINAL): YELLOW INSPECTION COPY (INITIAL): PINK OWNER COPY (INITIAL): GOLD