IREDELL COUNTY HEALTH DEPARTMENT

Authorization to Construct

STATESVILLE 704-878-5305 MOORESVILLE 704-664-5281

IMPROVEMENT PERMIT / ~~CERTIFICATE OF COMPLETION~~ / OPERATION PERMIT / EXISTING SYSTEM INSPECTION

PROPERTY DESCRIPTION NO. 22828 DATE 2/8/96 TAX MAP NO. 2C 23 B 10 4636 10 3106 Watershed: X Yes No

OWNER OR CONTRACTOR Robert Ingram Homes PHONE: Business 391-3715 Home

ADDRESS 2900 B I-85 Service Rd. Charlotte, NC.

LOCATION Isle of Pines TR Cove Creek Rd. TL Wynswept TL Wynwood Ln. 3rd lot on (L)

SUBDIVISION North Shore BLOCK / SECTION II LOT 10 LOT AREA 43338 FT² SITE CLASS PS DESIGN FLOW 480 L.T.A.R. .25

Septic Tank: 1000 Gallons; STB 794 Date 5/17/96

Pump Tank: 1000 Gallons; PT 27 Date 5/27/96

Pump Make: Liberty Model LE51A Serial No. 500X ~~2000~~

Nitrification Field: No Fields 4 Square Feet 1920 Linear Feet ~~2400~~

No Lines 5 Trench Width 36" Max Trench Bottom Depth 36" Gravel Depth 6" SAND

X New System ☐ Repair System Type: I II III IV V

System Description: Pressure manifold - Glendon Hunter

Repair System Description: Pressure manifold - Hunter

Maintenance Agreement Required: ☐ Yes ☐ No

X House/Mod. Home ☐ Mobile Home ☐ Business ☐ Other

No. Bedrooms 4 No. Bathrooms 3.5 No. Employees


Water Supply: ☐ Individual X Community ☐ Public

☐ Slab X Crawl Space ☐ Basement w/plumbing ☐ Basement wo/plumbing


Comments: + 25% reduction for shallow trench use
Pressure Manifold Required - with Protective Box
4" SCH 80 PVC - 1/2" TAPS

Comments:

INITIAL SITE SKETCH

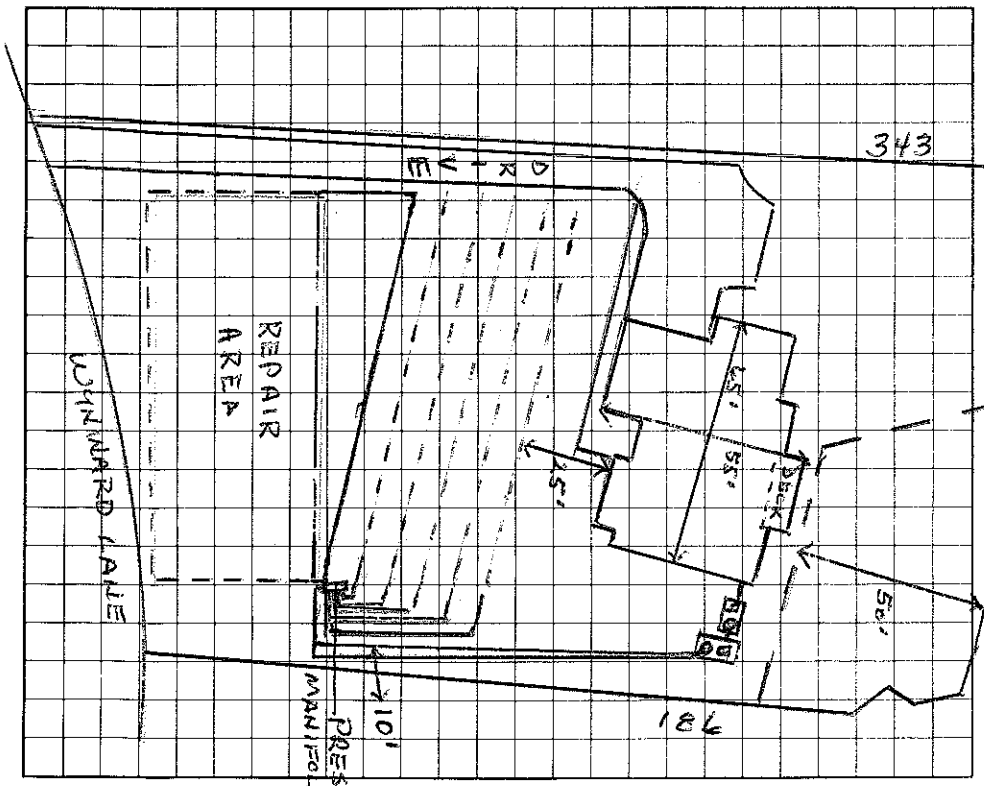

AS BUILT SKETCH

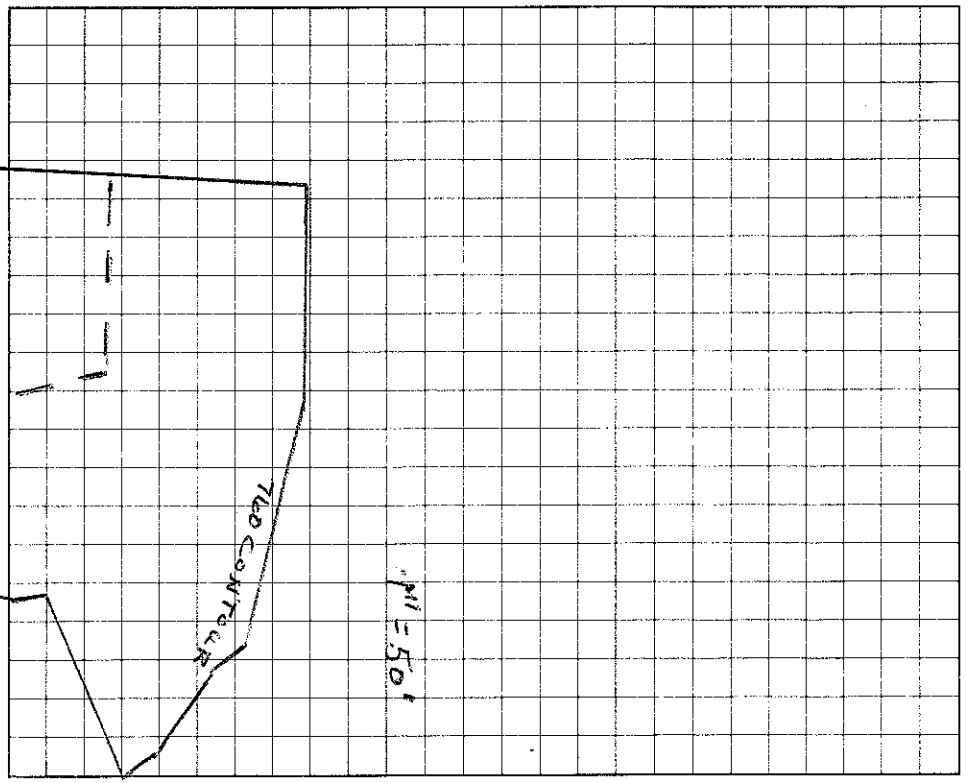

I understand that this permit can be suspended or revoked if any false information is supplied toward securing the permit/any unauthorized changes are made to the site/any unauthorized changes are made in the installation of the system.

Signed: X

Improvement Permit by: Wesley Sparks RS. date 2/9/96

Authorization to Construct Existing System Inspection by: Wesley Sparks RS. date 2/9/96

Installed by: Clon Horse Grading

Certificate of Completion by: date

Operation Permit by: Wesley Sparks RS. date 8/16/96

HEALTH DEPT. COPY: WHITE INSPECTION COPY (FINAL): GREEN OWNER COPY (FINAL): YELLOW INSPECTION COPY (INITIAL): PINK OWNER COPY (INITIAL): GOLD