IREDELL COUNTY HEALTH DEPARTMENT

Authorization to Construct

STATESVILLE 704-878-5305 MOORESVILLE 704-664-5281

IMPROVEMENT PERMIT / ~~CERTIFICATE OF COMPLETION~~ / OPERATION PERMIT / EXISTING SYSTEM INSPECTION

PROPERTY DESCRIPTION NO. 22827 DATE 1/3/96 TAX MAP NO. 26 23 B 9 Watershed: [X] Yes [ ] No

OWNER OR CONTRACTOR Robert Ingram Homes ~~PHONE: Business~~ 4036-10-3229 Home

ADDRESS 2900 I-85 Service Rd., Chas. NC. 28208

LOCATION Lake Pines TR Cane Creek TL Wynnmont TL Wynnwood 3rd on (L)

SUBDIVISION North Shore BLOCK / SECTION II LOT 9 LOT AREA 37,118 SITE CLASS PS DESIGN FLOW 480 L.T.A.R. .3

Septic Tank: 1000 Gallons; STB 714 Date 2/22/96

Pump Tank: _____ Gallons; PT _____ Date _____

Pump Make: _____ Model _____ Serial No. _____

Nitrification Field: No Fields 1 Square Feet 1200 Linear Feet 300

No Lines 4 Trench Width 36" Max Trench Bottom Depth 36" Gravel Depth 6" SAND

[X] New System [ ] Repair System Type: I, II, III, IV, V, VI

System Description: Drainfield Infiltrator

Repair System Description: Same

Maintenance Agreement Required: [ ] Yes [X] No

[X] House/Mod. Home No. Bedrooms 4

[ ] Mobile Home No. Bathrooms 3

[ ] Business No. Employees _____

[ ] Other _____


[ ] Slab [X] Crawl Space [ ] Basement w/plumbing [ ] Basement wo/plumbing

Water Supply:
[ ] Individual
[X] Community
[ ] Public


Comments: * 25% reduction for infiltrator use

Comments:

INITIAL SITE SKETCH

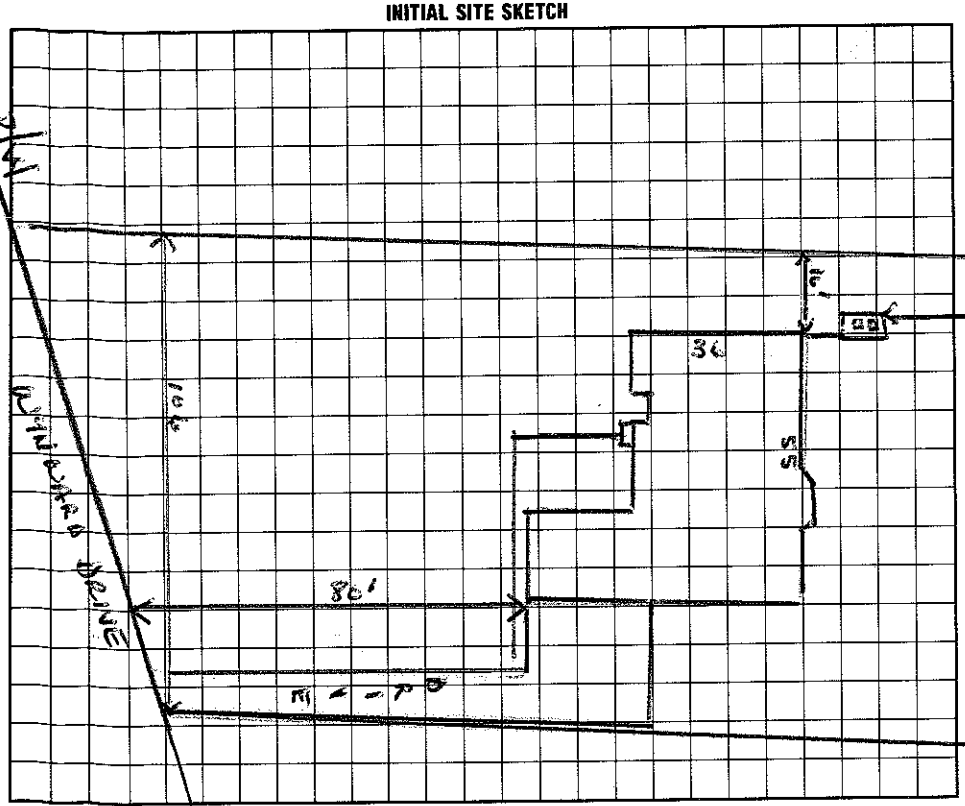

AS BUILT SKETCH

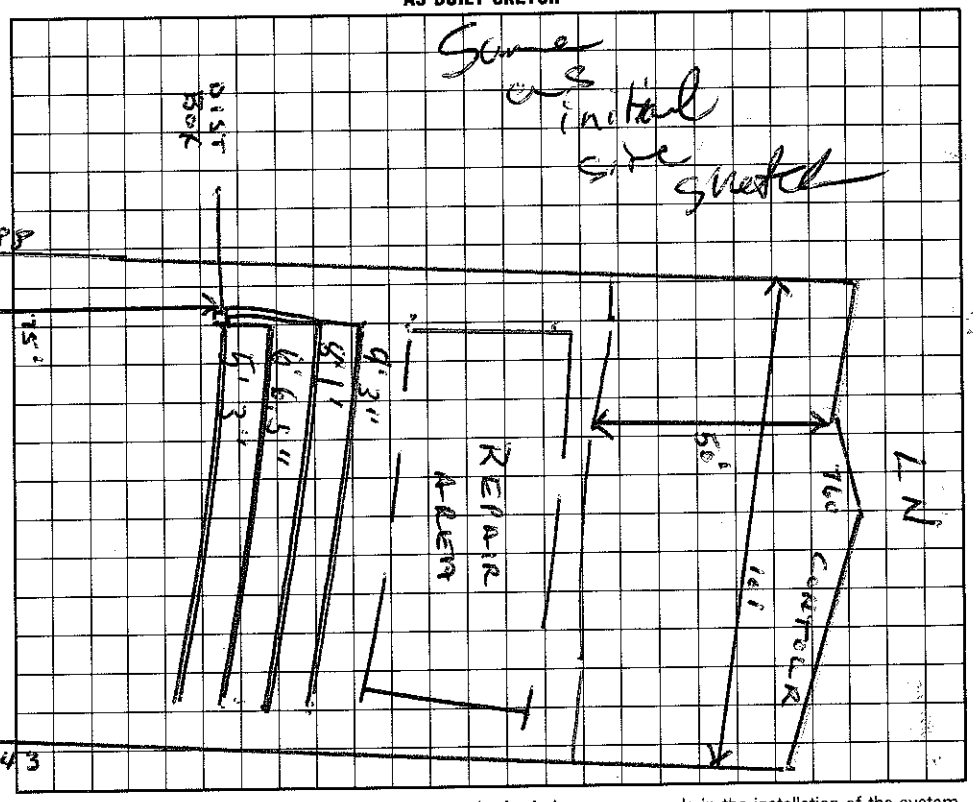

I understand that this permit can be suspended or revoked if any false information is supplied toward securing the permit/any unauthorized changes are made to the site/any unauthorized changes are made in the installation of the system.

Signed: _____

Improvement Permit by: Wesley Sparks RS. date 1/3/96

~~Existing System Inspection by:~~ Assistant Wesley Sparks RS. date 1/3/96

Installed by: Ironhorse

Certificate of Completion by: _____ date 3/25/96

Operation Permit by: _____ date 3/25/96

HEALTH DEPT. COPY: WHITE INSPECTION COPY (FINAL): GREEN OWNER COPY (FINAL): YELLOW INSPECTION COPY (INITIAL): PINK OWNER COPY (INITIAL): GOLD