IREDELL COUNTY HEALTH DEPARTMENT

Authorization to Construct

2 30

STATESVILLE 704-878-5305 MOORESVILLE 704-664-5281

IMPROVEMENT PERMIT / ~~CERTIFICATE OF COMPLETION~~ / OPERATION PERMIT / EXISTING SYSTEM INSPECTION

PROPERTY DESCRIPTION NO. 21104 DATE 4/17/97 TAX MAP NO. 2G 23 B 8 Watershed: X Yes ☐ No

OWNER OR CONTRACTOR Robert Ellington Homes PHONE: Business 391-3715 ~~Home~~ 463b-10-3400

ADDRESS 2900 B I 85 Service Rd. Charlotte, NC.

LOCATION Lake Pines TR Cove Creek TL Wynnsong pt TL Wynwood, 2nd on L

SUBDIVISION North Shore BLOCK / SECTION II LOT 8 LOT AREA 1.64Ac SITE CLASS PS DESIGN FLOW 480 L.T.A.R. .3

Septic Tank: Existing Gallons; STB ____ Date ____

Pump Tank: ____ Gallons; PT ____ Date ____

Pump Make: ____ Model ____ Serial No. ____

Nitrification Field: No Fields 2 Square Feet 840 Linear Feet 280+

No Lines 4 Trench Width 36" Max Trench Bottom Depth 36" Gravel Depth SAND.

☐ New System X Repair System Type: I, II, III, IV, V, VI

System Description: GRAVITY PLASTIC

Repair System Description: GRAVITY PLASTIC

Maintenance Agreement Required: ☐ Yes X No

X House/Mod. Home No. Bedrooms 4

☐ Mobile Home No. Bathrooms 3

☐ Business No. Employees ____

☐ Other ____


☐ Slab X Crawl Space ☐ Basement w/plumbing ☐ Basement wo/plumbing

Water Supply:
☐ Individual
X Community
☐ Public


Comments: - - - lines are to be added
——— lines existing
Need two 6 hole Dist. Box - RELEVEL FLOW DIVIDER AND TWO NEW DIST BOXES.

Comments:

INITIAL SITE SKETCH

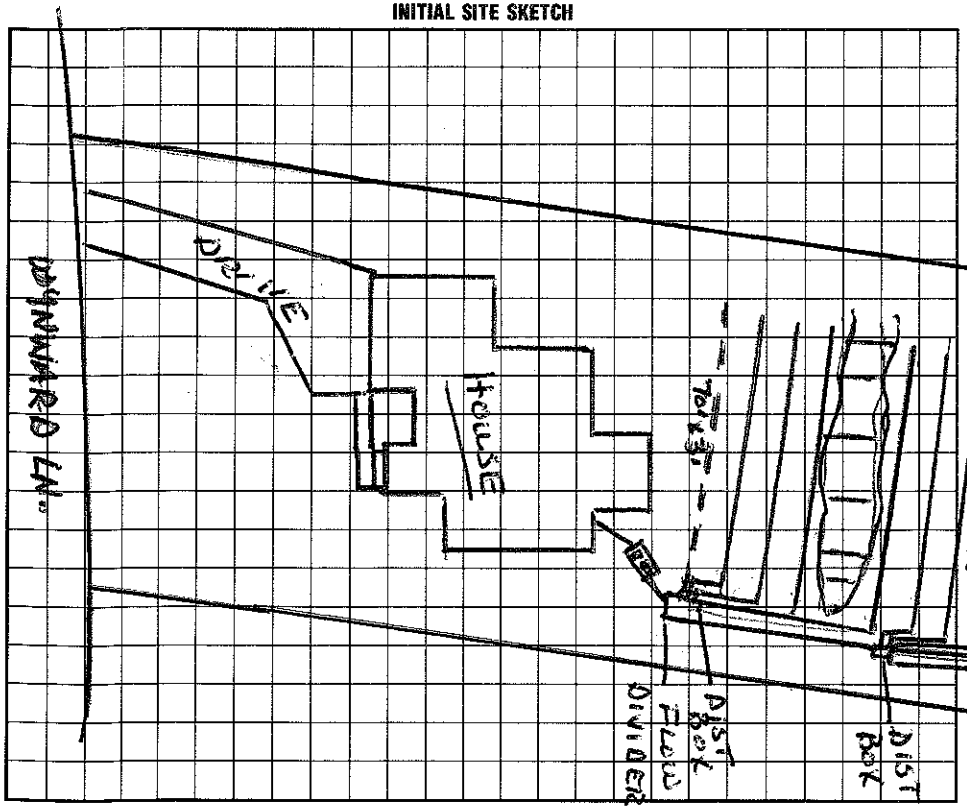

AS BUILT SKETCH

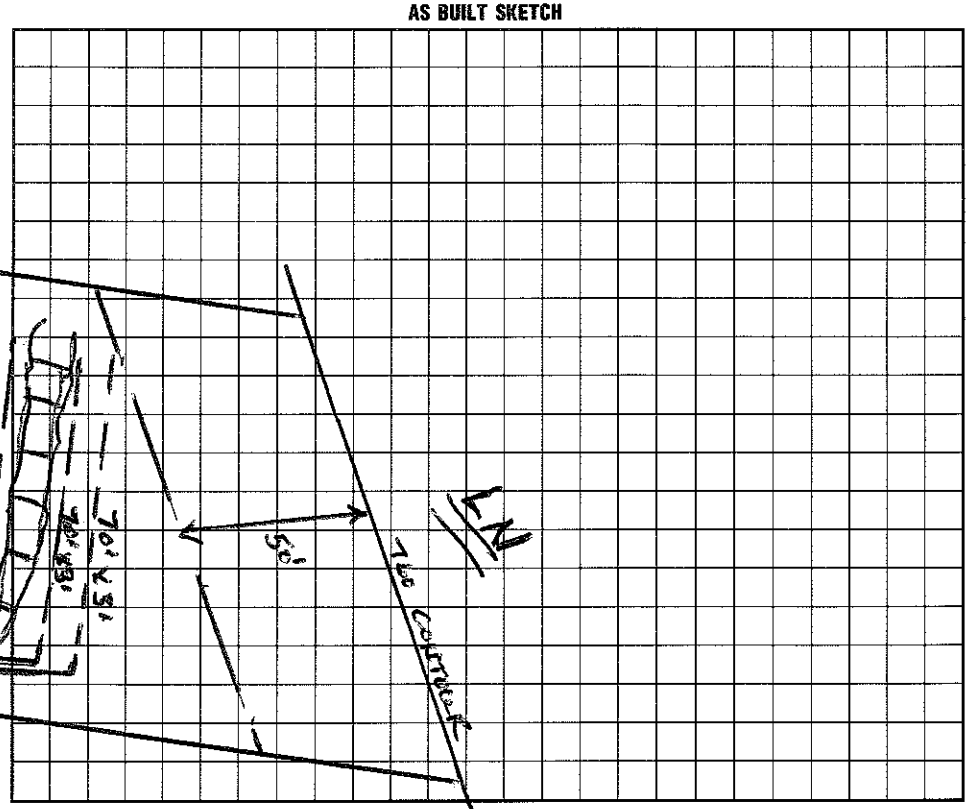

I understand that this permit can be suspended or revoked if any false information is supplied toward securing the permit/any unauthorized changes are made to the site/any unauthorized changes are made in the installation of the system. Improvement Permit is valid for 60 months from date of issuance.

Signed: X

Improvement Permit by: Wesley Sparks R.S. date 4/17/97

Existing System Inspection by: Wesley Sparks R.S. date 4/17/97

Installed by: Alon Hussey Grading

Certificate of Completion by: Wesley Sparks R.S. date 5/9/97

Operation Permit by: Wesley Sparks R.S. date 5/9/97

HEALTH DEPT. COPY: WHITE INSPECTION COPY (FINAL): GREEN OWNER COPY (FINAL): YELLOW INSPECTION COPY (INITIAL): PINK OWNER COPY (INITIAL): GOLD