IREDELL COUNTY HEALTH DEPARTMENT

STATESVILLE 704-878-5305 MOORESVILLE 704-664-5281

IMPROVEMENT PERMIT / CERTIFICATE OF COMPLETION / OPERATION PERMIT / EXISTING SYSTEM INSPECTION

PROPERTY DESCRIPTION NO. 18546 DATE June 30, 194 TAX MAP NO. 2623 B 52 4636103874 Watershed: ☑ Yes ☐ No

OWNER OR CONTRACTOR Robert Brogahan Homes PHONE: Business 391-3715 Home LR

ADDRESS 2900 B 185 Statesville, Charlotte 28208

LOCATION I-40 TL I-13 TR Cove Creek Rd TL Wynsweept Dr. on Right

SUBDIVISION North Shore BLOCK / SECTION II, 1 LOT 52 LOT AREA ~1/2 ac SITE CLASS. PS DESIGN FLOW 360 gpd L.T.A.R. = 3

Septic Tank: 1000 Gallons; STB 194 Wellington Date 9-16-94

Pump Tank: 1000 Gallons; PT 27 Wellington Date 9-12-94

Pump Make: _____ Model _____ Serial No. _____

Nitrification Field: No Fields 2 Square Feet 1200 Linear Feet 480

No Lines ~7 Trench Width 36" Max Trench Bottom Depth 36" Gravel Depth 12"

☑ New System ☐ Repair System Type: I, II, III, IV, V, VI

System Description: pumped Conventional

Repair System Description: Same as LPPBPS

Maintenance Agreement Required: ☐ Yes ☑ No

☑ House/Mod. Home No. Bedrooms 3

☐ Mobile Home No. Bathrooms 3.5

☐ Business No. Employees _____

☐ Other _____


☐ Slab ☑ Crawl Space ☐ Basement w/plumbing ☐ Basement wo/plumbing

Water Supply: ☐ Individual ☑ Community ☐ Public


Comments:

Comments: Drainfield & tanks installed
Checked pump, adjusted flow 12/13/94

INITIAL SITE SKETCH

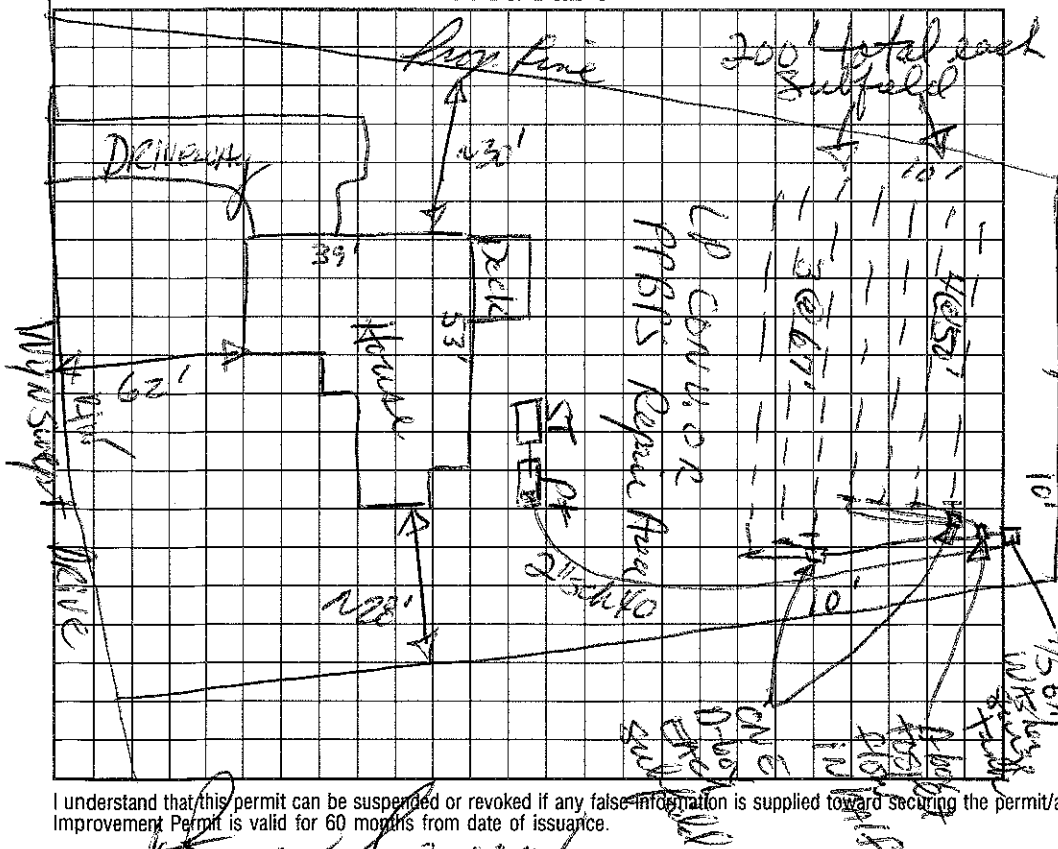

AS BUILT SKETCH

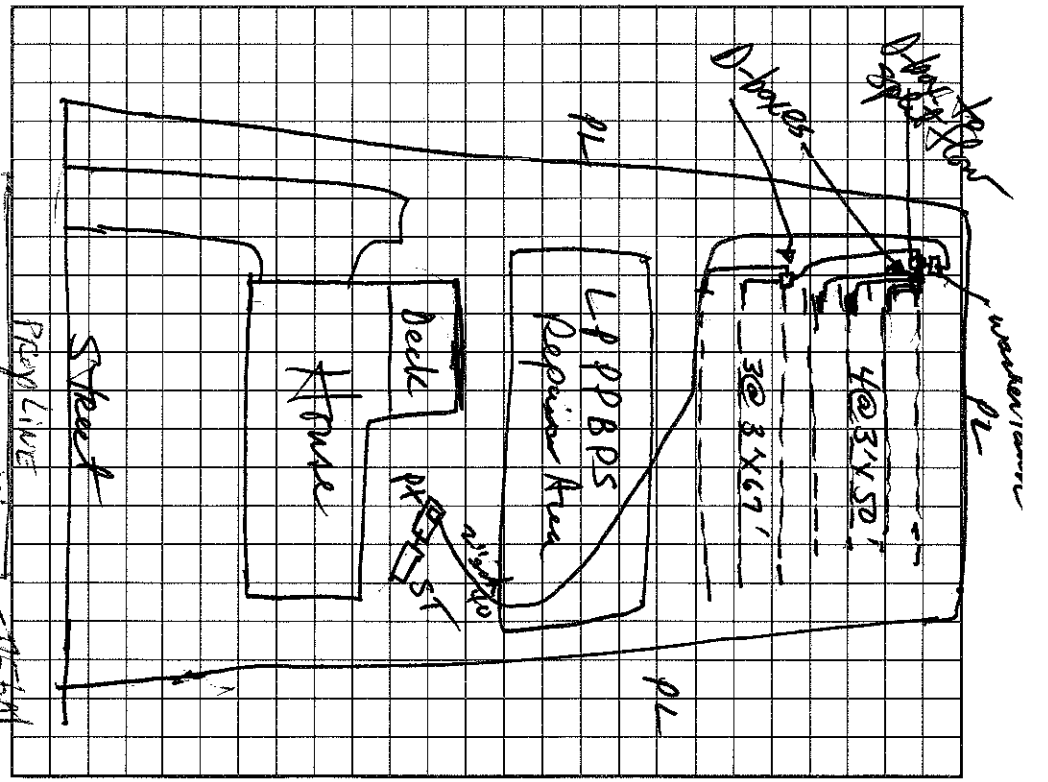

I understand that this permit can be suspended or revoked if any false information is supplied toward securing the permit/any unauthorized changes are made to the site/any unauthorized changes are made in the installation of the system. Improvement Permit is valid for 60 months from date of issuance.

Signed: Kasey Lovegrove

Improvement Permit by: James K. Hunter, RS date 6/30/94

Existing System Inspection by: _____ date _____

Installed by: Ken Painter / Clearhouse Grading

Certificate of Completion by: _____ date _____

Operation Permit by: D. Hunter date 1-13-95

HEALTH DEPT. COPY: WHITE INSPECTION COPY (FINAL): GREEN OWNER COPY (FINAL): YELLOW INSPECTION COPY (INITIAL): PINK OWNER COPY (INITIAL): GOLD