IREDELL COUNTY HEALTH DEPARTMENT

STATESVILLE 704-878-5305 MOORESVILLE 704-664-5281

IMPROVEMENT PERMIT / CERTIFICATE OF COMPLETION / OPERATION PERMIT / EXISTING SYSTEM INSPECTION

PROPERTY DESCRIPTION NO. 17589 DATE Dec 14, 93 TAX MAP NO. 2G-23 B 53 4636 10 4933 Watershed: ☑ Yes ☐ No

OWNER OR CONTRACTOR Robert Ingraham Homes PHONE: Business 391-3715 Home L.N.

ADDRESS

LOCATION 1100 TL 113 TR Cove Creek TL Wynswept 3rd on Right

SUBDIVISION North Shore BLOCK / SECTION II LOT 53 LOT AREA 110'x215' SITE CLASS. RS DESIGN FLOW 360gpd L.T.A.R. • 3

Septic Tank: 1000 Gallons; STB 794 Delliver Date 1-10-94

Pump Tank: 1000 Gallons; PT 27 Delliver Date 1-10-94

Pump Make: Model Serial No.

Nitrification Field: No. Fields 1 Square Feet 1200 Linear Feet 400

No Lines 5 Trench Width 36" Max Trench Bottom Depth 36" Gravel Depth 12"

☑ New System ☐ Repair System Type: I, II, (III), IV, V, VI

System Description: pumped to conventional

Repair System Description: same

Maintenance Agreement Required: ☐ Yes ☑ No

☑ House/Mod. Home No. Bedrooms 3

☐ Mobile Home No. Bathrooms 3

☐ Business No. Employees

☐ Other


☐ Slab ☑ Crawl Space ☐ Basement w/plumbing ☐ Basement wo/plumbing

Water Supply: ☐ Individual ☑ Community ☐ Public


Comments: Use 200 gal per 6½ minute cycle. Pump specs: 30 gpl per minute at 25' head.

Comments: System installed on 3/1/94 Alarm checked for mounting 4/26/94

INITIAL SITE SKETCH

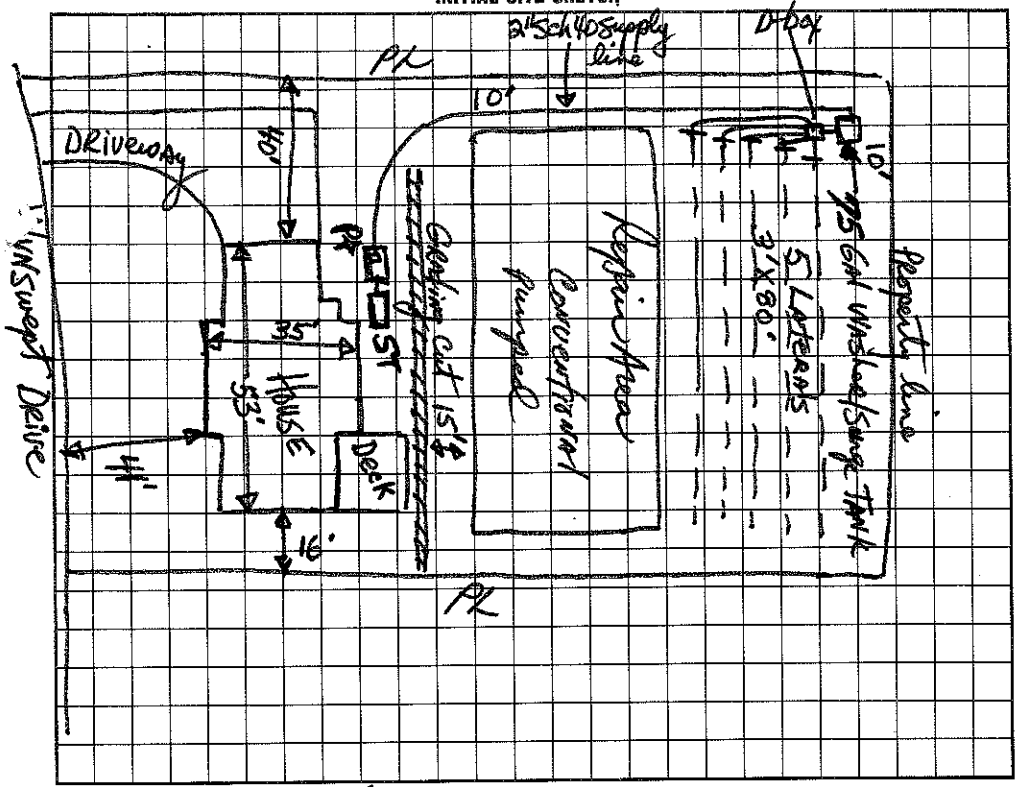

AS BUILT SKETCH

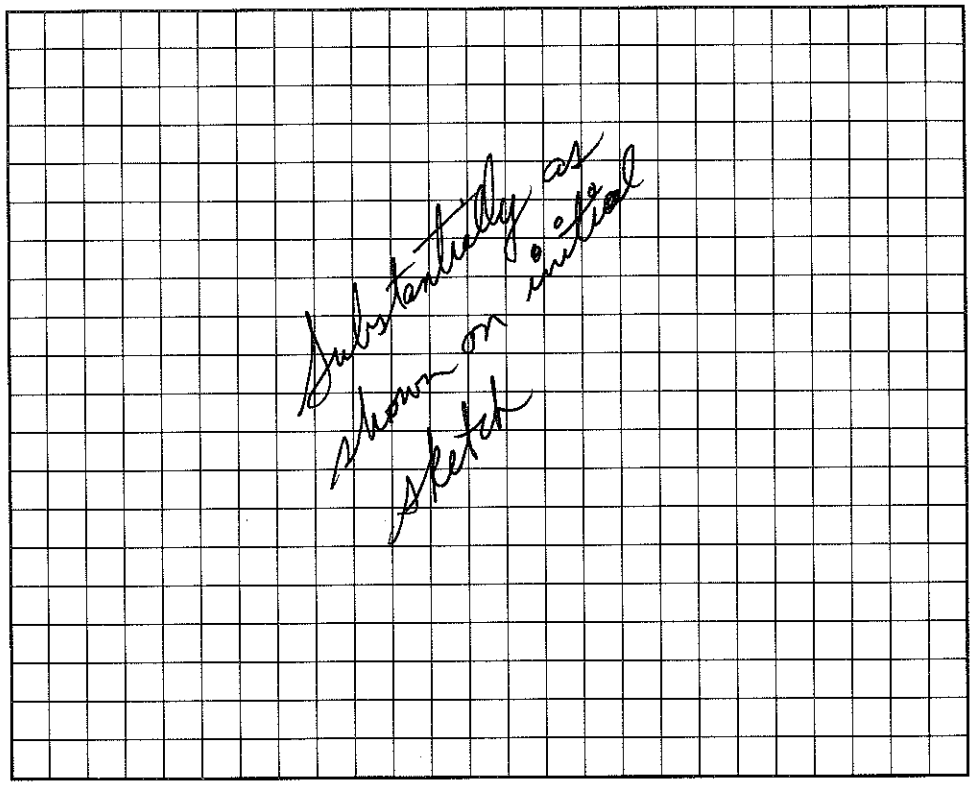

I understand that this permit can be suspended or revoked if any false information is supplied toward securing the permit/any unauthorized changes are made to the site/any unauthorized changes are made in the installation of the system. Improvement Permit is valid for 60 months from date of issuance.

Signed:

Improvement Permit by: Harold R. Hinson, RS date 12/14/93

Existing System Inspection by: date

Installed by: Clearhorse Grading (Ken Painter)

Certificate of Completion by: date

Operation Permit by: Harold R Hinson, RS date 4/26/94

HEALTH DEPT. COPY: WHITE INSPECTION COPY (FINAL): GREEN OWNER COPY (FINAL): YELLOW INSPECTION COPY (INITIAL): PINK OWNER COPY (INITIAL): GOLD