IREDELL COUNTY HEALTH DEPARTMENT

STATESVILLE 704-878-5305 MOORESVILLE 704-664-5281

IMPROVEMENT PERMIT / CERTIFICATE OF COMPLETION / OPERATION PERMIT / EXISTING SYSTEM INSPECTION

PROPERTY DESCRIPTION NO. 16167 DATE June 29, 93 TAX MAP NO. 2F B10

OWNER OR CONTRACTOR Robert Clagraham Homes PHONE: Business 463E-10-5555 Home

ADDRESS

LOCATION 1100 Tl 1163 TR North Shore X Cove TL Wynswept Dr. on left

SUBDIVISION North Shore at Pine Island BLOCK / SECTION 2 LOT 5 LOT AREA SITE CLASS. PS L.T.A.R. .25-.3

Water Supply: ☐ Individual ☑ Community ☐ Public

Septic Tank: 1500 Gallons; STB 797 Bellinger Date 4-7-93

Pump Tank: Gallons; PT Date

Nitrification Field: No Fields 2 Square Feet Linear Feet 300

No Lines 6 Trench Width 24" Trench Depth Gravel Depth NA

☑ New System ☐ Repair System Type: I, II, III, IV, V, VI

System Description: gravity PPBPS

Repair System Description: SAME

Maintenance Agreement Required: ☐ Yes ☑ No

☑ House/Mod. Home No. Bedrooms 4 Garbage Disposal: ☑ Yes ☐ No

☐ Mobile Home No. Bathrooms 2 Auto. Dishwasher: ☑ Yes ☐ No

☐ Business No. Employees Auto. Washing Machine: ☑ Yes ☐ No


☐ Other Other

☐ Slab ☑ Crawl Space ☐ Basement w/plumbing ☐ Basement wo/plumbing

Comments

INITIAL SITE SKETCH

AS BUILT SKETCH

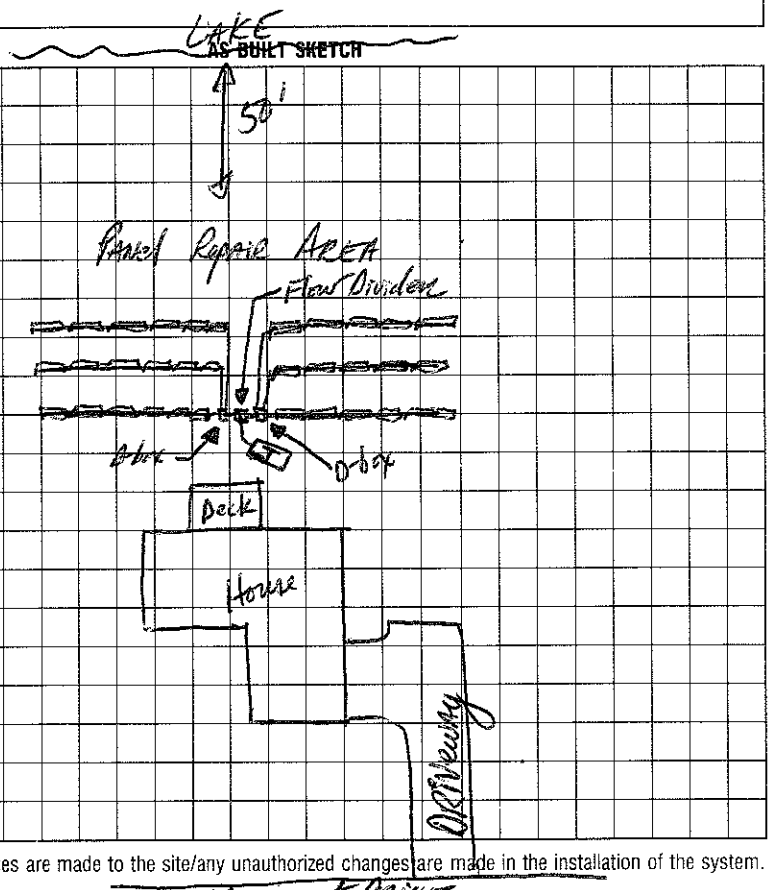

I understand that this permit can be suspended or revoked if any false information is supplied toward securing the permit/any unauthorized changes are made to the site/any unauthorized changes are made in the installation of the system. Improvement Permit is valid for 60 months from date of issuance.

Signed:

Installed by: IRONHORSE Grading

Improvement Permit by: date

Certificate of Completion by: date

Existing System Inspection by: date

Operation Permit by: date 6/29/93

HEALTH DEPT. COPY: WHITE INSPECTION COPY (FINAL): GREEN OWNER COPY (FINAL): YELLOW INSPECTION COPY (INITIAL): PINK OWNER COPY (INITIAL): GOLD