IREDELL COUNTY HEALTH DEPARTMENT

STATESVILLE 704-878-5305 MOORESVILLE 704-664-5281

IMPROVEMENT PERMIT / CERTIFICATE OF COMPLETION / OPERATION PERMIT / EXISTING SYSTEM INSPECTION

PROPERTY DESCRIPTION NO. 46632 DATE August 11, '93 TAX MAP NO. 2G23A3

OWNER OR CONTRACTOR Robert Cloninger Homes PHONE: Business 4636-10-6755 Home

ADDRESS

LOCATION 1100 Blk T.L. 1113 TR Cove Creek Rd. TR High Sail Ct. 3rd on Rt.

SUBDIVISION North Shore at Pine Island BLOCK / SECTION 1 LOT 3 LOT AREA ½ A SITE CLASS B L.T.A.R. .3

Water Supply: ☐ Individual ☑ Community ☐ Public

Septic Tank: 1000 Gallons; STB 794 Dellinger Date 8-13-93

Pump Tank: Gallons; PT Date

Nitrification Field; No Fields 1 Square Feet 1200 Linear Feet 400

No Lines 4 Trench Width 36" Trench Depth 30-36" Gravel Depth 12"

☑ New System ☐ Repair System Type: I, II, IV-V, VI

System Description: gravity conventional

Repair System Description: pumped conventional

Maintenance Agreement Required: ☐ Yes ☑ No

☑ House/Mod. Home No. Bedrooms 3 Garbage Disposal: ☑ Yes ☐ No

☐ Mobile Home No. Bathrooms 3 Auto. Dishwasher: ☑ Yes ☐ No


☐ Business No. Employees Auto. Washing Machine: ☑ Yes ☐ No

☐ Other Other


☐ Slab ☑ Crawl Space ☐ Basement w/plumbing ☐ Basement wo/plumbing

Comments Plumbing to exit house at a level to accomodate specified Horizontal bottom depth.

INITIAL SITE SKETCH

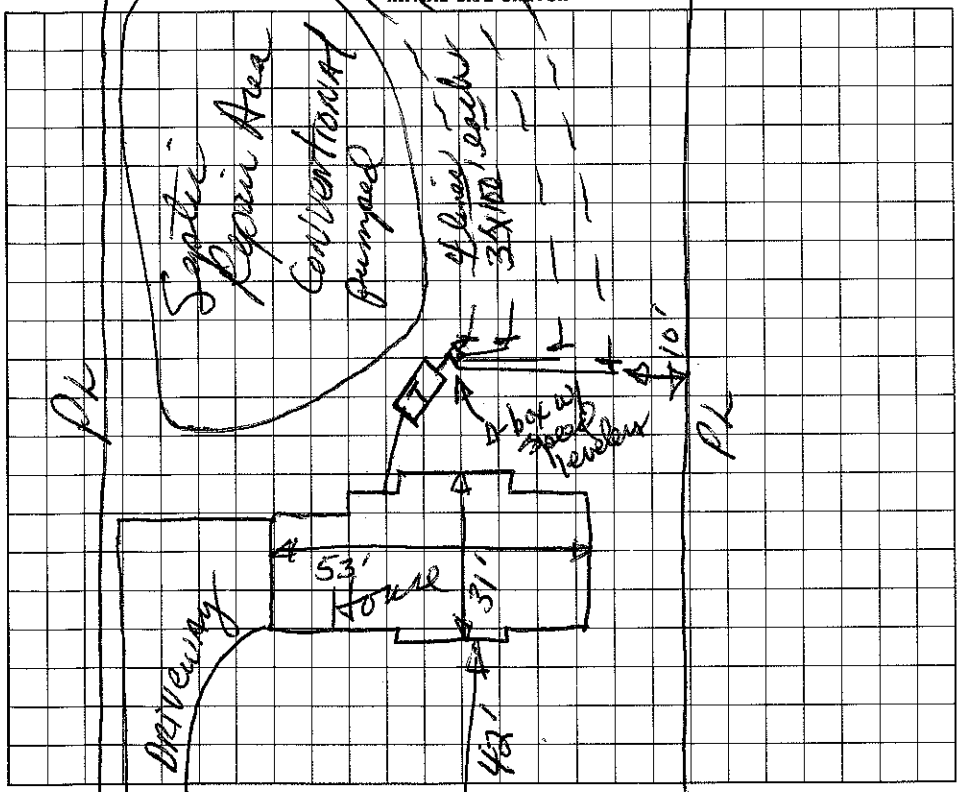

AS BUILT SKETCH

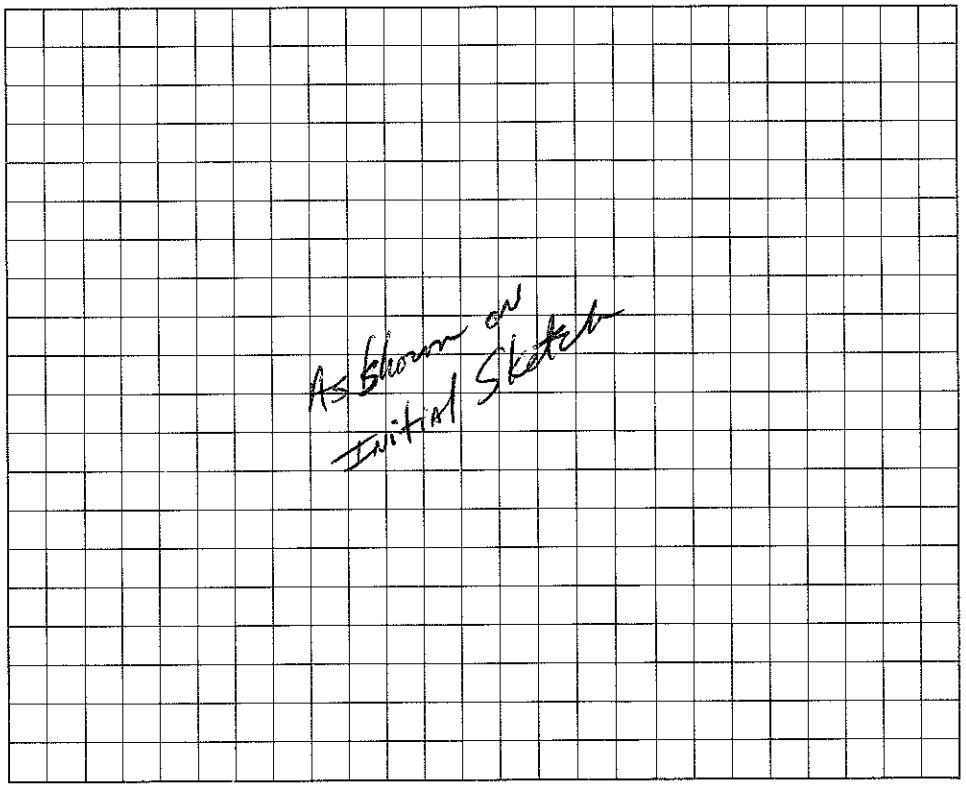

I understand that this permit can be suspended or revoked if any false information is supplied toward securing the permit/any unauthorized changes are made to the site/any unauthorized changes are made in the installation of the system. Improvement Permit is valid for 60 months from date of issuance.

Signed: High Sail Court Roddy Jr

Improvement Permit by: David R. Hamrick IRS date 8/11/93

Existing System Inspection by: date

Installed by: Ironhorse Grading

Certificate of Completion by: David R. Hamrick IRS date 10/29/93

Operation Permit by: date

HEALTH DEPT. COPY: WHITE INSPECTION COPY (FINAL): GREEN OWNER COPY (FINAL): YELLOW INSPECTION COPY (INITIAL): PINK OWNER COPY (INITIAL): GOLD