4636106755

IREDELL COUNTY HEALTH DEPARTMENT

STATESVILLE 704-878-5305 MOORESVILLE 704-664-5281

IMPROVEMENT PERMIT / CERTIFICATE OF COMPLETION / OPERATION PERMIT / EXISTING SYSTEM INSPECTION

PROPERTY DESCRIPTION NO. 66899 DATE Sept. 2, '93 TAX MAP NO. 2623B

OWNER OR CONTRACTOR Robert Clingraham Homes PHONE: Business _____ Home _____

ADDRESS _____

LOCATION 1100 TR 1113 TR Cove Creek Rd. TR Wynnecrest Dr. 3rd lot on left

SUBDIVISION North Shore BLOCK / SECTION H LOT 3 LOT AREA ~27,000 ft² SITE CLASS. B per 1996 L.T.A.R. .13

Water Supply: ☐ Individual ☑ Community ☐ Public

Septic Tank: 1000 Gallons; STB _____ Date _____

Pump Tank: _____ Gallons; PT _____ Date _____

Nitrification Field: No Fields 2 Square Feet 1620 Linear Feet 540

No Lines n/a Trench Width 36" Trench Depth 24" Gravel Depth 12"

☑ New System ☐ Repair System Type: I (II) III IV V VI

System Description: gravity conventional

Repair System Description: gravity RPBPS

Maintenance Agreement Required: ☐ Yes ☑ No

☑ House/Mod. Home No. Bedrooms 4

☐ Mobile Home No. Bathrooms 3

☐ Business No. Employees _____

☐ Other _____

☑ Slab ☐ Crawl Space ☑ Basement w/plumbing ☐ Basement wo/plumbing

Garbage Disposal: ☑ Yes ☐ No


Auto. Dishwasher: ☑ Yes ☐ No

Auto. Washing Machine: ☑ Yes ☐ No


Other _____

Comments Follow contours w/drainfield

INITIAL SITE SKETCH

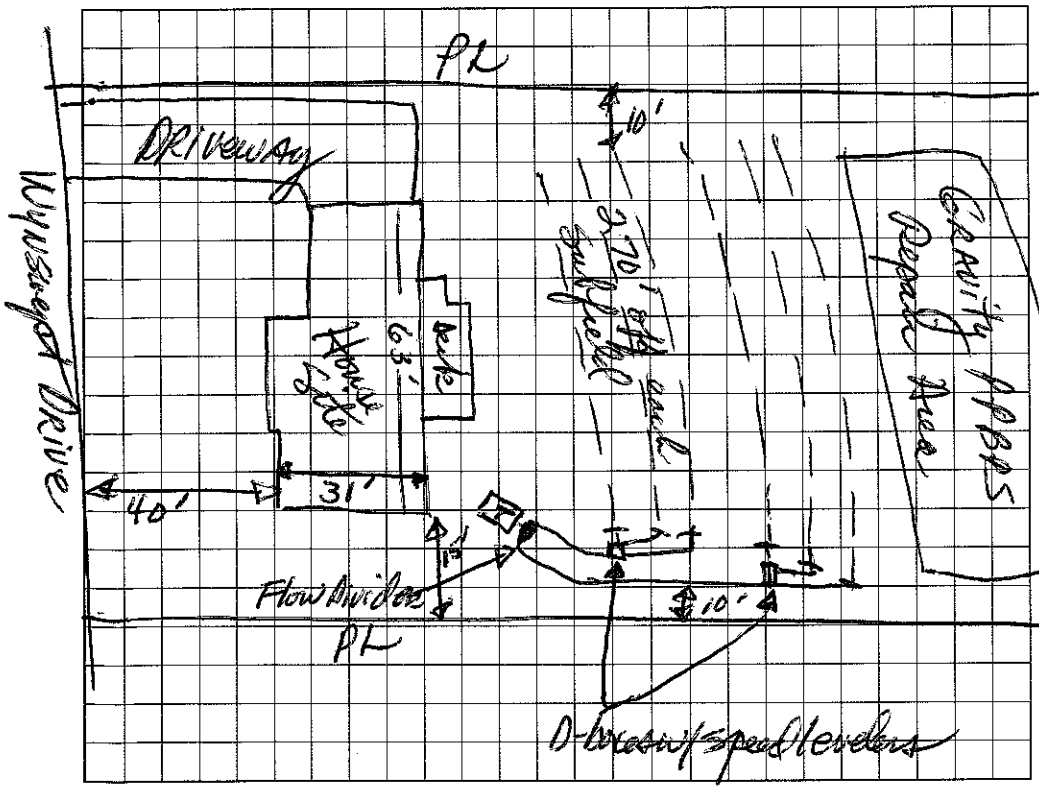

AS BUILT SKETCH

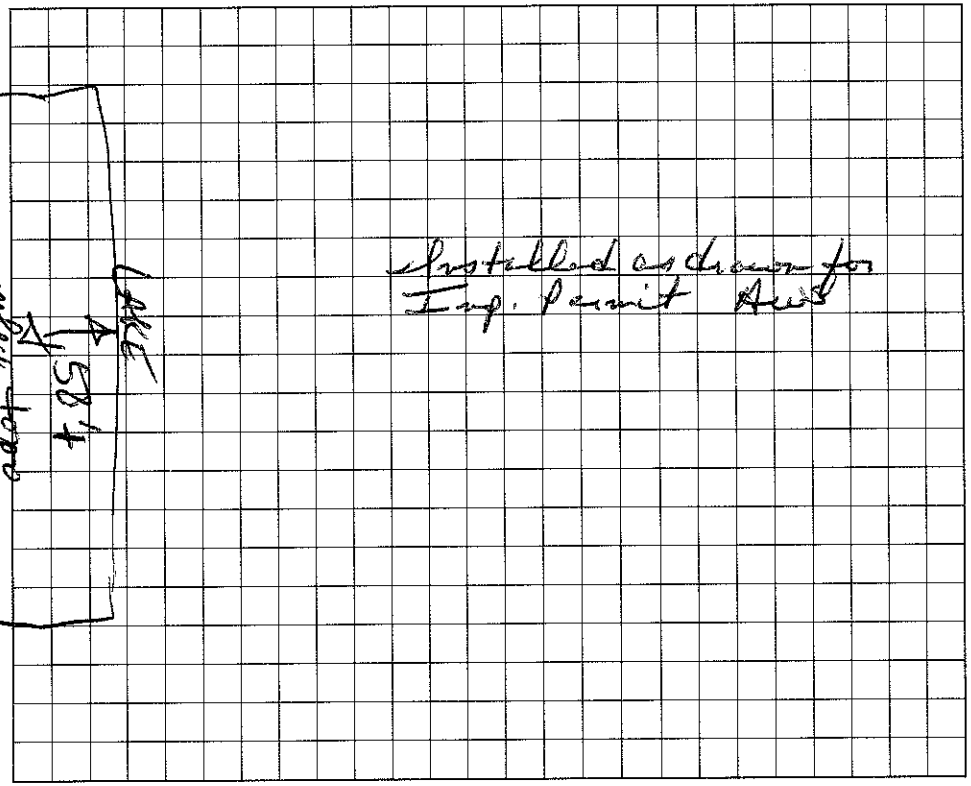

I understand that this permit can be suspended or revoked if any false information is supplied toward securing the permit/any unauthorized changes are made to the site/any unauthorized changes are made in the installation of the system. Improvement Permit is valid for 60 months from date of issuance.

Signed: X _____

Improvement Permit by: _____ date 9/2/93

Existing System Inspection by: _____ date _____

Installed by: Avon Home Building Co.

Certificate of Completion by: Wesley Sparks date 11/12/93

Operation Permit by: _____ date _____

HEALTH DEPT. COPY: WHITE INSPECTION COPY (FINAL): GREEN OWNER COPY (FINAL): YELLOW INSPECTION COPY (INITIAL): PINK OWNER COPY (INITIAL): GOLD