IREDELL COUNTY HEALTH DEPARTMENT

STATESVILLE 704-878-5305 MOORESVILLE 704-664-5281

IMPROVEMENT PERMIT / CERTIFICATE OF COMPLETION / OPERATION PERMIT / EXISTING SYSTEM INSPECTION

PROPERTY DESCRIPTION NO. 17343 DATE Oct. 27, 93 TAX MAP NO. 2623A84

OWNER OR CONTRACTOR Robert Ingraham Homes PHONE: Business 391-3715 Home 4636-10-6755

ADDRESS 2900 B Fes S. Sachree Rd. Charlotte Watershed: ☐ Yes ☐ No

LOCATION 1100 ft 1/13 TR Cove Creek TR High Sail Ct. attend on left

SUBDIVISION North Shore BLOCK / SECTION 1 LOT 3 LOT AREA ~ 3/4 Ac SITE CLASS PS DESIGN FLOW 460 gpd L.T.A.R. .35

Septic Tank: 1000 Gallons; STB 794 Dellinger Date 11-14-93

Pump Tank: _____ Gallons; PT _____ Date _____

Pump Make: _____ Model _____ Serial No. _____

Nitrification Field: No Fields 2 Square Feet 1380 Linear Feet 460

No Lines 6 Trench Width 36" Max Trench Bottom Depth 36" Gravel Depth 12"

☑ New System ☐ Repair System Type: I II III IV V VI

System Description: gravity conventional

Repair System Description: _____

Maintenance Agreement Required: ☐ Yes ☑ No

☑ House/Mod. Home No. Bedrooms 4

☐ Mobile Home No. Bathrooms 2½

☐ Business No. Employees ____

☐ Other _____


☐ Slab ☑ Crawl Space ☐ Basement w/plumbing ☐ Basement wo/plumbing

Water Supply: ☐ Individual ☑ Community ☐ Public

Comments:

Comments:

INITIAL SITE SKETCH

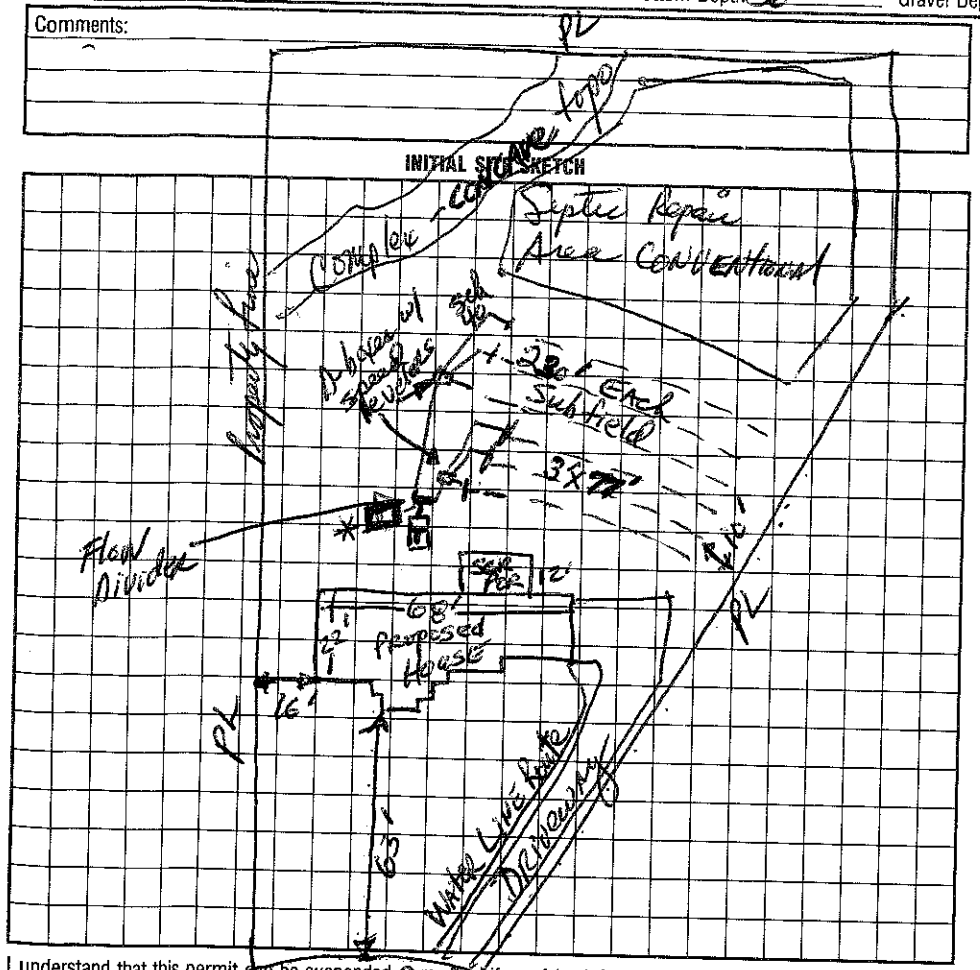

AS BUILT SKETCH

Installed Substantially as shown on initial sketch. Tank oriented as X

I understand that this permit can be suspended or revoked if any false information is supplied toward securing the permit/any unauthorized changes are made to the site/any unauthorized changes are made in the installation of the system. Improvement Permit is valid for 60 months from date of issuance.

Signed: _____

Improvement Permit by: David R Hinson, RS date 10/27/93

Existing System Inspection by: _____ date _____

Installed by: Kent Painter Woodhouse Grading

Certificate of Completion by: David R Hinson, RS date 12/18/94

Operation Permit by: _____ date _____

HEALTH DEPT. COPY: WHITE INSPECTION COPY (FINAL): GREEN OWNER COPY (FINAL): YELLOW INSPECTION COPY (INITIAL): PINK OWNER COPY (INITIAL): GOLD