IREDELL COUNTY HEALTH DEPARTMENT

STATESVILLE 704-878-5305 MOORESVILLE 704-664-5281

IMPROVEMENT PERMIT / CERTIFICATE OF COMPLETION / OPERATION PERMIT / EXISTING SYSTEM INSPECTION

PROPERTY DESCRIPTION NO. 16900 DATE Sept. 2, '93

OWNER OR CONTRACTOR Robert Klingelhoefer Homes PHONE: Business Home

ADDRESS TAX MAP NO. 2623B2

LOCATION 1102 T/L 1113 TR Cone Creek Rd TL Wynnwood Dr 2nd lot on Lft

SUBDIVISION North Shore BLOCK / SECTION II LOT 2 LOT AREA ~27,000 Ft² SITE CLASS. B per 1956 L.T.A.R. 1.3

Water Supply: ☐ Individual ☑ Community ☐ Public

Septic Tank: 1000 Gallons; STB 794 Date 8-15-93

Pump Tank: Gallons; PT Date

Nitrification Field: No Fields 2 Square Feet 1620 Linear Feet 540

No Lines ~6 Trench Width 36" Trench Depth 24" Gravel Depth 12"

☑ New System ☐ Repair System Type: I, II, III, IV, V, VI

System Description: gravity conventional

Repair System Description: gravity PPBFS

Maintenance Agreement Required: ☐ Yes ☑ No

☑ House/Mod. Home No. Bedrooms 4

☐ Mobile Home No. Bathrooms 3

☐ Business No. Employees

☐ Other

☐ Slab ☑ Crawl Space ☐ Basement w/plumbing ☐ Basement wo/plumbing

Garbage Disposal: ☐ Yes ☐ No

Auto. Dishwasher: ☑ Yes ☐ No


Auto. Washing Machine: ☑ Yes ☐ No

Other


Comments Follow contours with drainfield

Lower w/ Expand Laterals

INITIAL SITE SKETCH

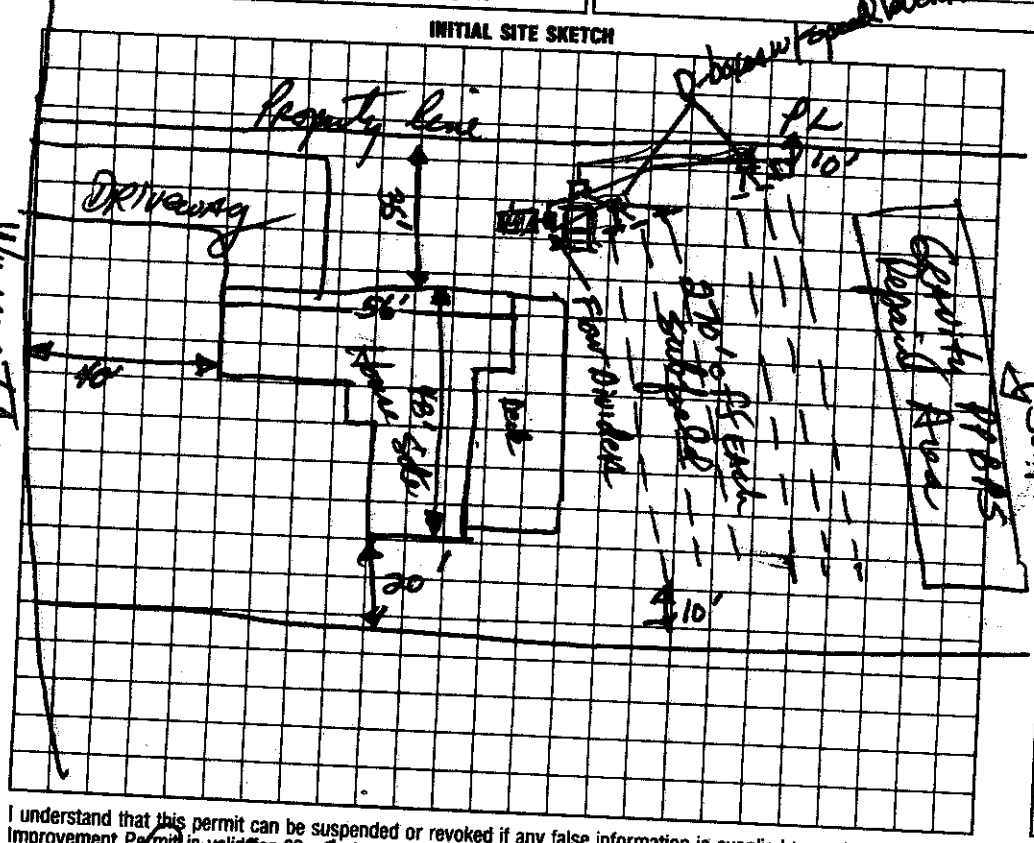

AS BUILT SKETCH

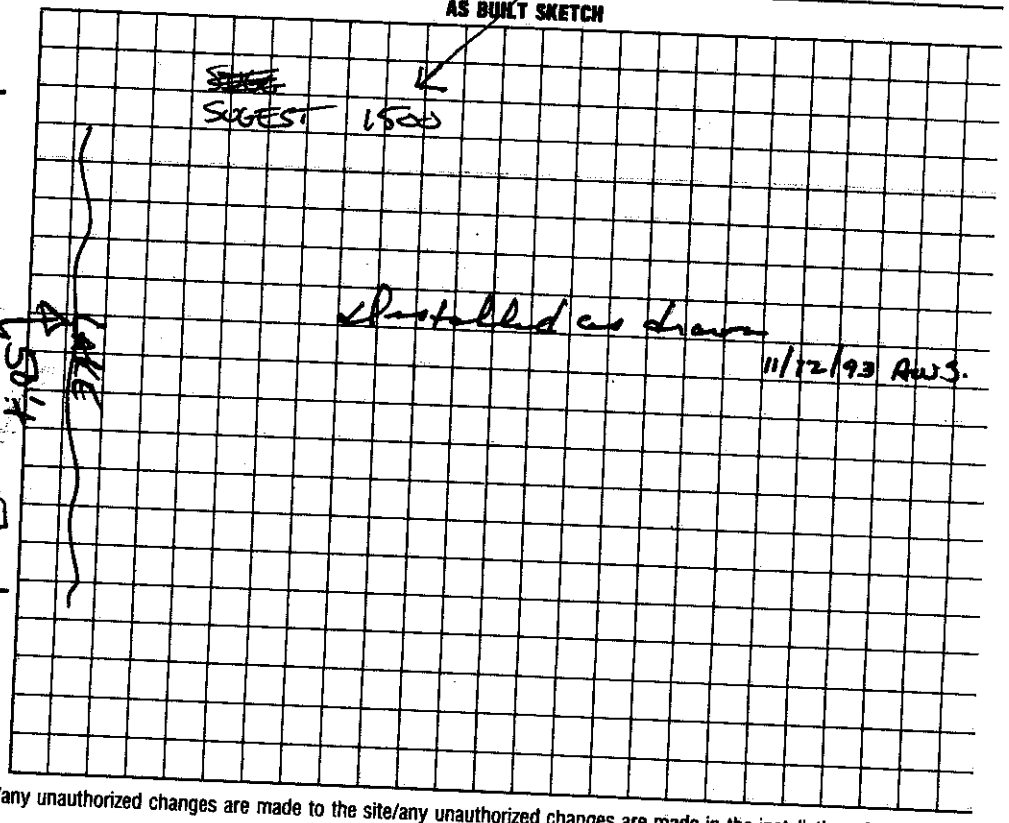

I understand that this permit can be suspended or revoked if any false information is supplied toward securing the permit/any unauthorized changes are made to the site/any unauthorized changes are made in the installation of the system. Improvement Permit is valid for 60 months from date of issuance.

Signed

Improvement Permit by: Richard R Hanson, RS date 9/2/93

Existing System Inspection by: date

Installed by: Thomas Grading Co.

Certificate of Completion by: Wesley Sparkman date 11/12/93

Operation Permit by: date

HEALTH DEPT. COPY: WHITE INSPECTION COPY (FINAL): GREEN OWNER COPY (FINAL): YELLOW INSPECTION COPY (INITIAL): PINK OWNER COPY (INITIAL): GOLD