4636-10-7972

3-4pm

IREDELL COUNTY HEALTH DEPARTMENT

STATESVILLE 704-878-5305 MOORESVILLE 704-664-5281

IMPROVEMENT PERMIT / CERTIFICATE OF COMPLETION / OPERATION PERMIT / EXISTING SYSTEM INSPECTION

PROPERTY DESCRIPTION NO. 19772 DATE Oct 6, 194 TAX MAP NO. 2623 B1 Watershed: ☑ Yes ☐ No CN

OWNER OR CONTRACTOR Robert Clingenheim Homes PHONE: Business 392-3715 Home

ADDRESS 2900 B I-85 S. Service Rd., Charlotte 28208

LOCATION 1100 TY 1113 TR Cove Creek Rd. on left at jct w/ Wynswept

SUBDIVISION North Shore BLOCK / SECTION F LOT 1 LOT AREA ~26,000 +/- SITE CLASS. PS pd. 1956 DESIGN FLOW 360 gpd. L.T.A.R. .3

Septic Tank: 1000 Gallons; STB 794 Bellinger Date 12-12-94

Pump Tank: 1000 Gallons; PT 27 Bellinger Date 11-12-94

Pump Make: Gould Model WS05111A Serial No. 9438480

Nitrification Field: No Fields 1 Square Feet Linear Feet 200

No Lines 3 Trench Width 24" Max Trench Bottom Depth 28" Gravel Depth NA

☑ New System ☐ Repair System Type: I, II, III, IV, V, VI

System Description: LP PPBRS

Repair System Description: SAME

Maintenance Agreement Required: ☑ Yes ☐ No

☑ House/Mod. Home No. Bedrooms 3

☐ Mobile Home No. Bathrooms 3

☐ Business No. Employees

☐ Other


☐ Slab ☐ Crawl Space ☑ Basement w/plumbing ☐ Basement wo/plumbing

Water Supply: ☐ Individual ☑ Community ☐ Public


Comments: follow contour w/ laterals; 46 panels total; one 3/16" hole per panel.

Comments: 1-26-95 System installed & closed
3-29-95 checked alarm, elec hookup and recd contract

INITIAL SITE SKETCH

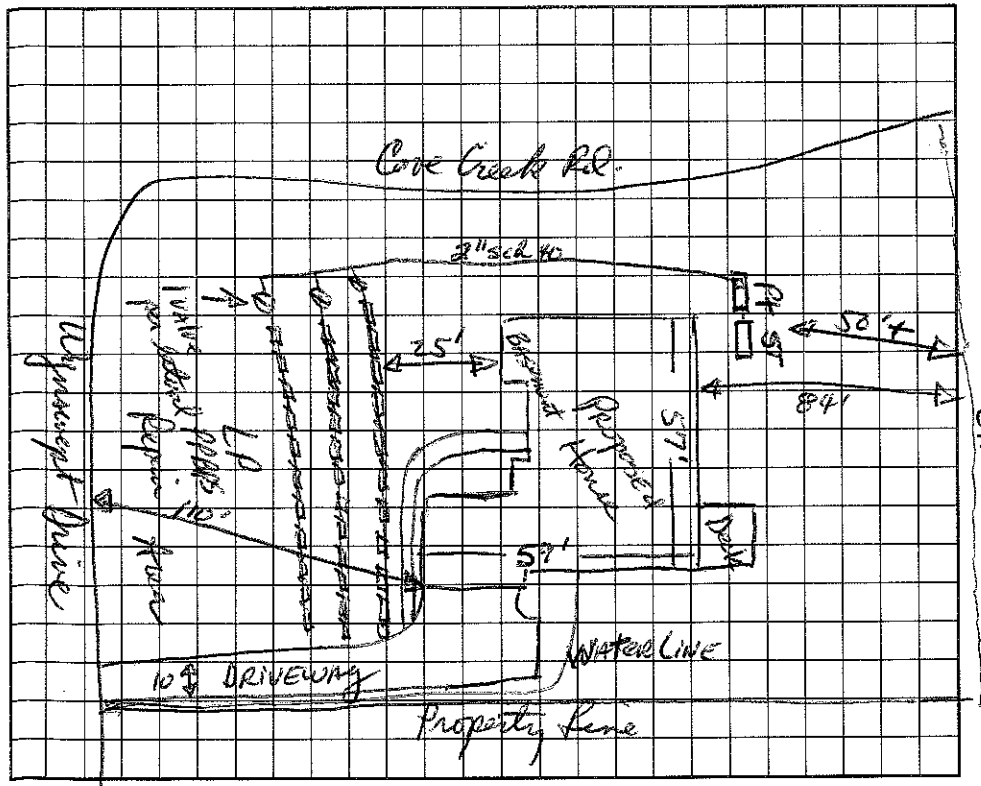

AS BUILT SKETCH

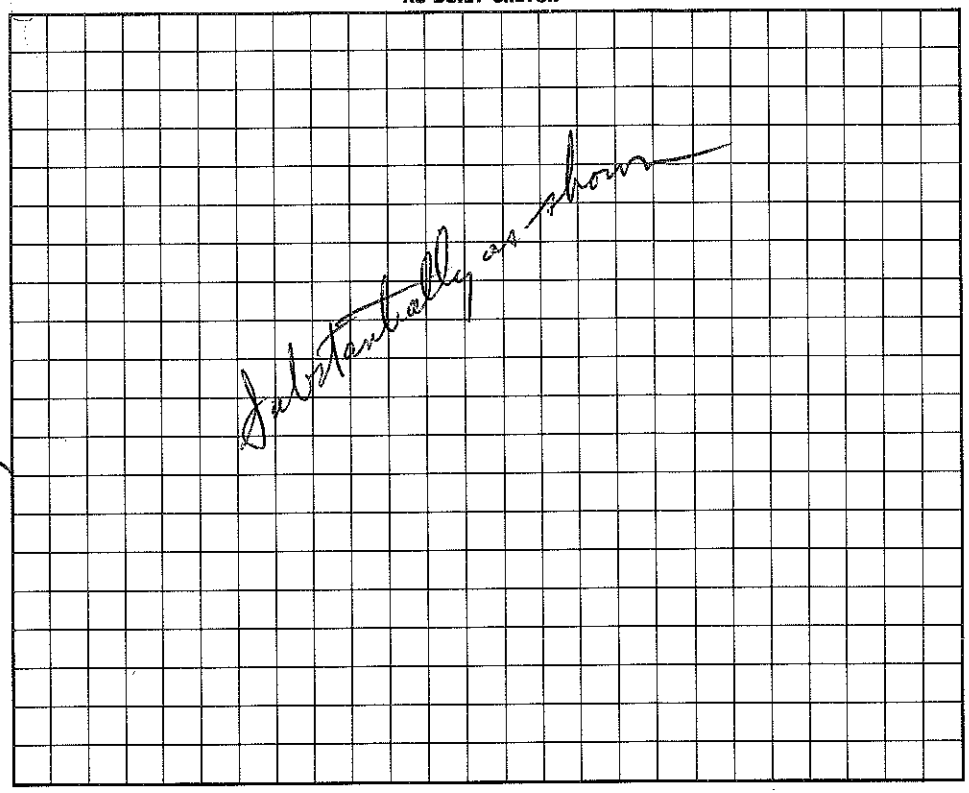

I understand that this permit can be suspended or revoked if any false information is supplied toward securing the permit/any unauthorized changes are made to the site/any unauthorized changes are made in the installation of the system. Improvement Permit is valid for 60 months from date of issuance.

Signed:

Improvement Permit by: J R Hinson, IRS date 10/6/94

Existing System Inspection by: date

Installed by: Ken Painter / Ironhorse Grading

Certificate of Completion by: date

Operation Permit by: J R Hinson IRS date 3/29/95

HEALTH DEPT. COPY: WHITE INSPECTION COPY (FINAL): GREEN OWNER COPY (FINAL): YELLOW INSPECTION COPY (INITIAL): PINK OWNER COPY (INITIAL): GOLD