IREDELL COUNTY HEALTH DEPARTMENT

STATESVILLE 704-878-5305 MOORESVILLE 704-664-5281

IMPROVEMENT PERMIT / CERTIFICATE OF COMPLETION / OPERATION PERMIT / EXISTING SYSTEM INSPECTION

PROPERTY DESCRIPTION NO. 20786 DATE 4-10-95 TAX MAP NO. 2G-23-B-42 Watershed: ☑ Yes ☐ No

OWNER OR CONTRACTOR Robert Ingraham Homes PHONE: Business 351-3715 ~~Home~~ 4636-11-0423 WS4-CA

ADDRESS 2900 B- I-85 Serv Rd Charlotte, N.C.

LOCATION Cornor North Shore Drive + Wynward Lane

SUBDIVISION North Shore BLOCK / SECTION 2 LOT 42 LOT AREA .56 SITE CLASS. PS DESIGN FLOW 480 L.T.A.R. .3

Septic Tank: 1000 Gallons; STB [illegible] Date 5-12-95
Pump Tank: ______ Gallons; PT ______ Date ______
Pump Make: ______ Model ______ Serial No. ______
Nitrification Field: No Fields 1 Square Feet 540 Linear Feet 270
No Lines 5 Trench Width 24" Max Trench Bottom Depth 32" Gravel Depth N/A

☑ New System ☐ Repair System Type: I, II, (III), IV, V, VI
System Description: Gravity Panel
Repair System Description: Pump to Pressure Less Panel
Maintenance Agreement Required: ☐ Yes ☐ No
☐ Slab ☑ Crawl Space ☐ Basement w/plumbing ☐ Basement wo/plumbing


☑ House/Mod. Home No. Bedrooms 4
☐ Mobile Home No. Bathrooms 2½
☐ Business No. Employees ______
☐ Other ______

Water Supply:
☐ Individual
☐ Community
☑ Public

Comments: use Distribution box with speed levelers

Comments: Replaces Permit issued 4-17-95

INITIAL SITE SKETCH

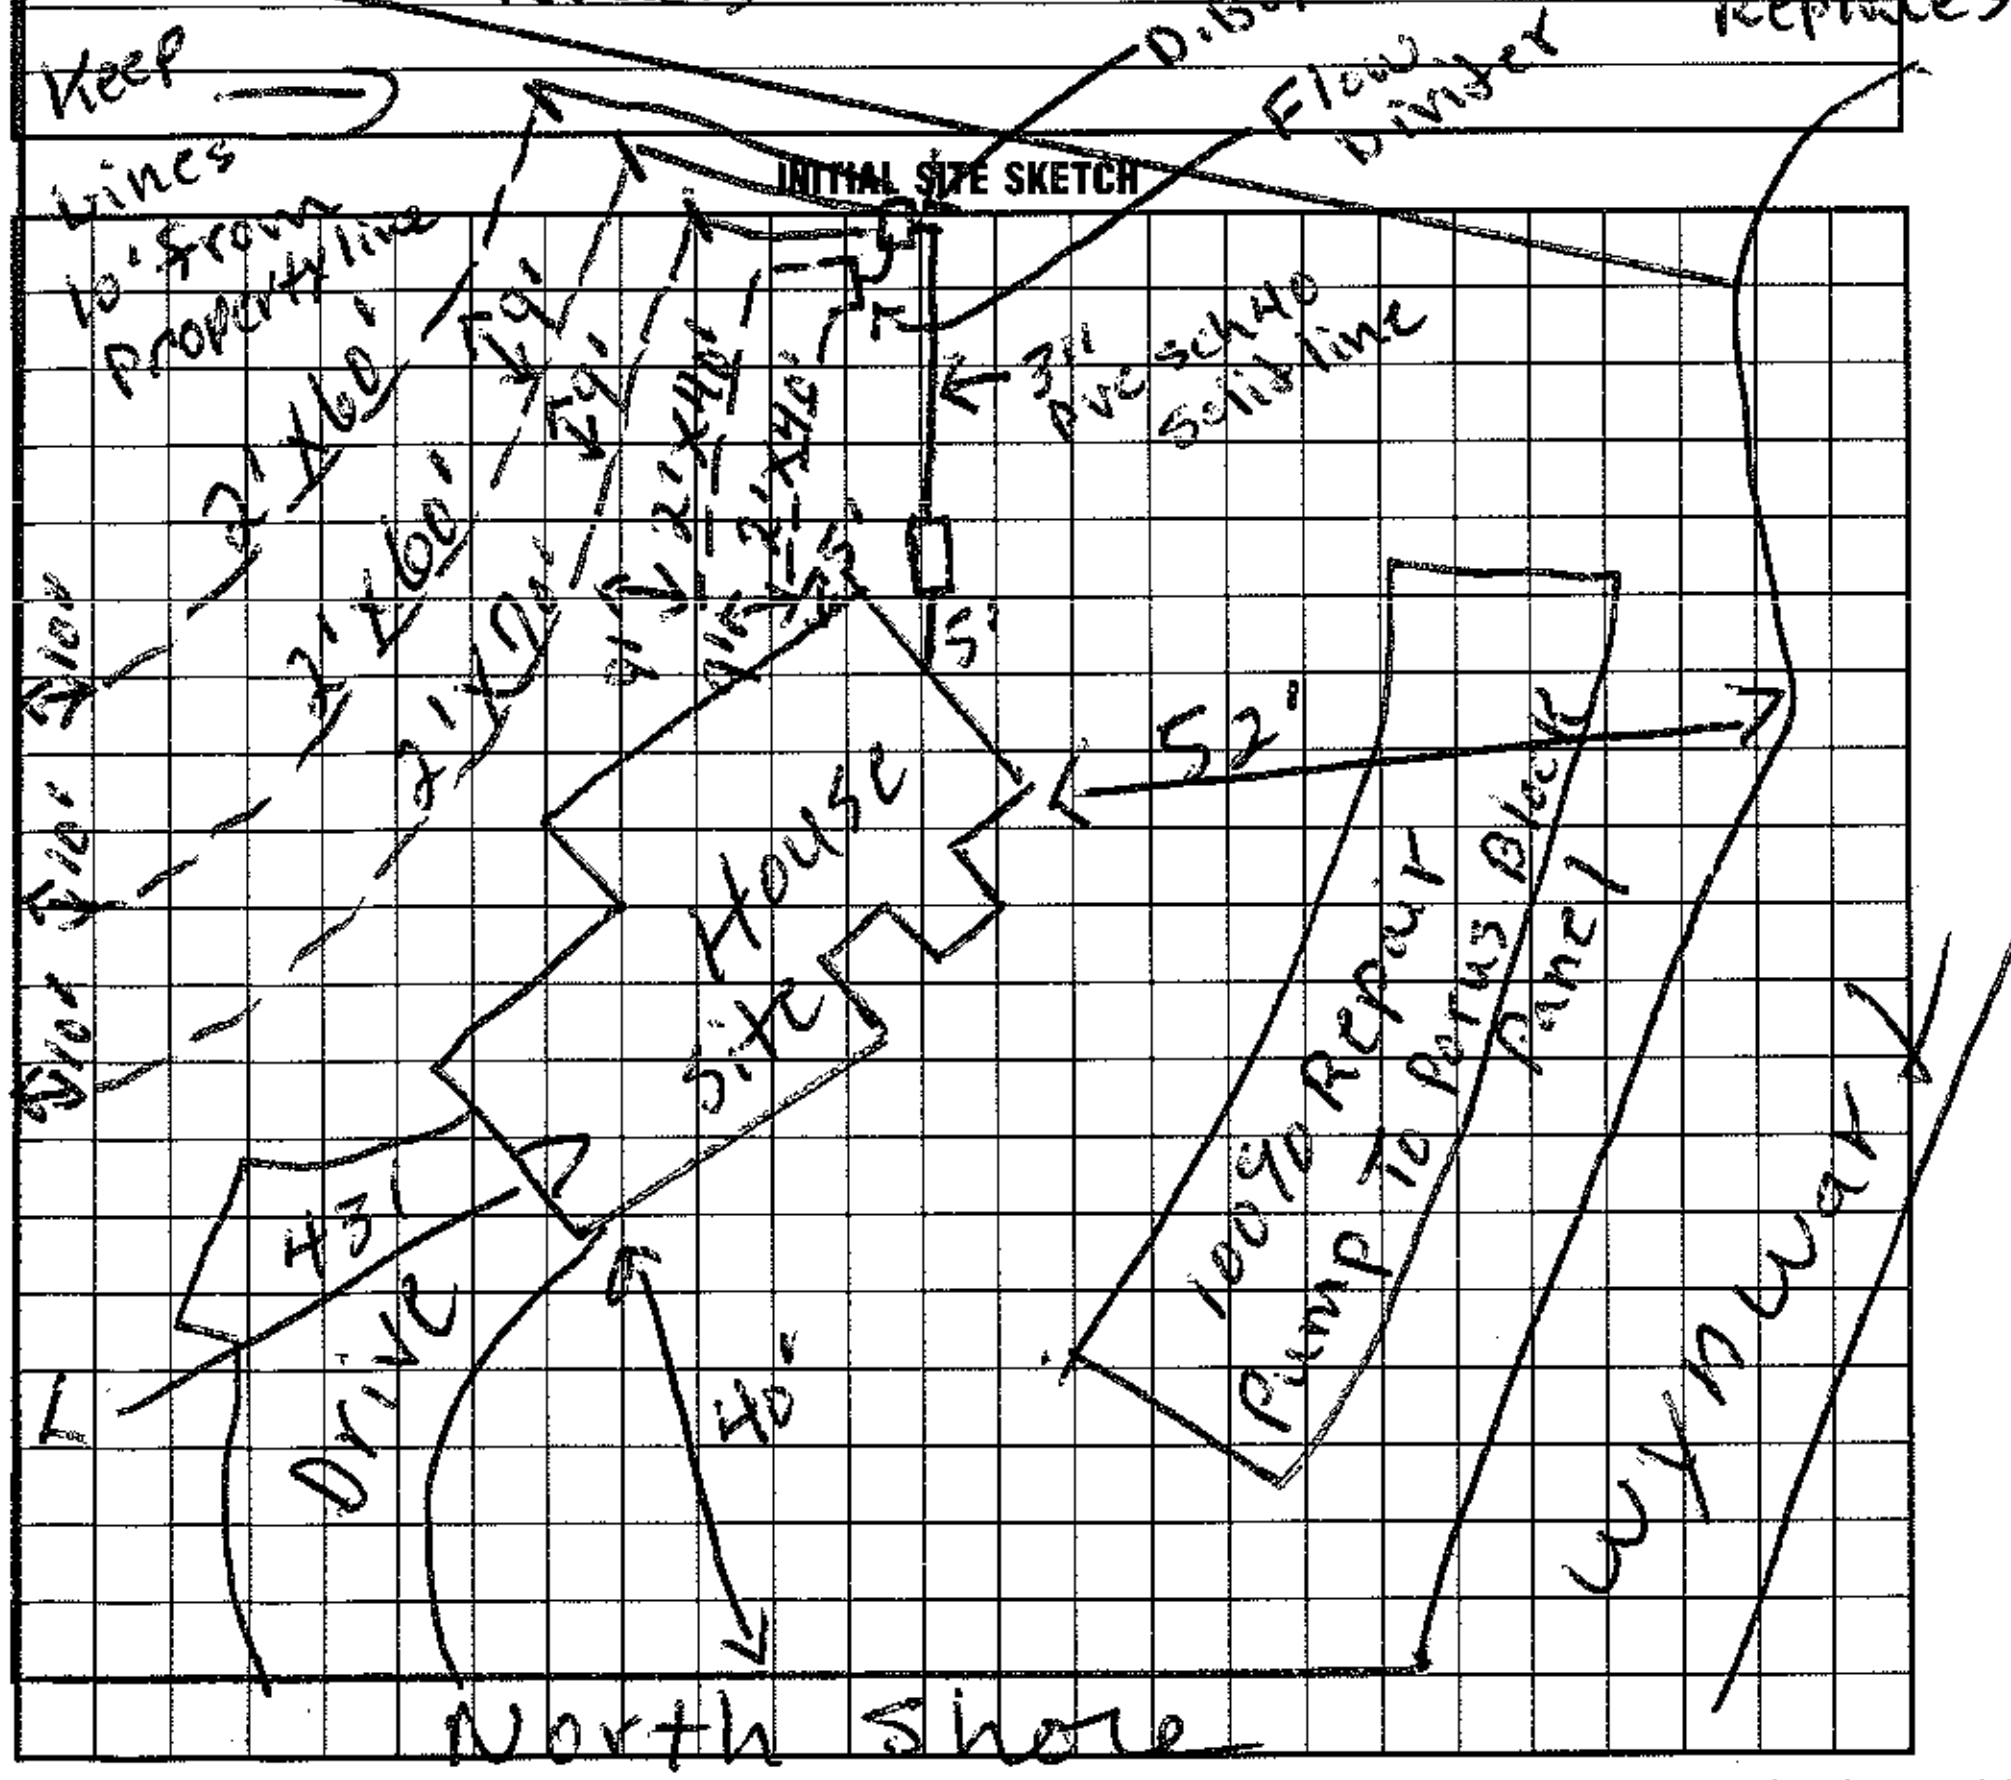

AS BUILT SKETCH

Substantially as shown

I understand that this permit can be suspended or revoked if any false information is supplied toward securing the permit/any unauthorized changes are made to the site/any unauthorized changes are made in the installation of the system. Improvement Permit is valid for 60 months from date of issuance.

Signed: ______

Improvement Permit by: R. C. Moore date 4-10-95

Existing System Inspection by: ______ date ______

Installed by: Ken Painter

Certificate of Completion by: [signature] RS date ______

Operation Permit by: ______ date 7-19-95

HEALTH DEPT. COPY: WHITE INSPECTION COPY (FINAL): GREEN OWNER COPY (FINAL): YELLOW INSPECTION COPY (INITIAL): PINK OWNER COPY (INITIAL): GOLD